



Field Notes for Installation:


Just before 2nd tree back from 2nd gray light pole back from intersection with Waterfront.

Pole Site Location S/S Water Av west of Waterfront Dr

Sign Panel Panel Type

W1 **B logo**

Pole Type **B**

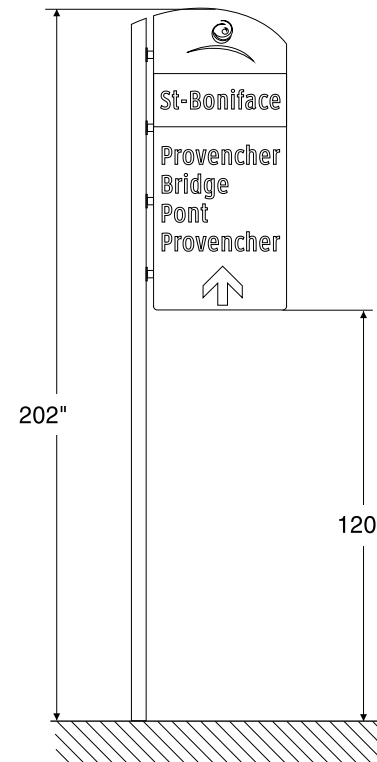




Field Notes for Installation:

35' beyond 3rd pole back from Waterfront.

Pole Site Location S/S York St west of Waterfront Dr


Sign Panel	Panel Type
YE1-U	D logo
YE1-L	D lower
Pole Type	D+D

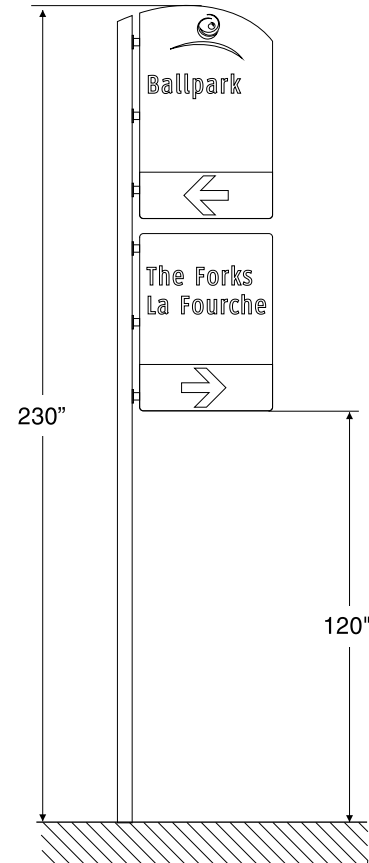




Pile Site Location E/S Waterfront Dr south of York Av

Sign Panel	Panel Type
WF3-U	D logo
WF3-L	B lower
Pole Type	D+B

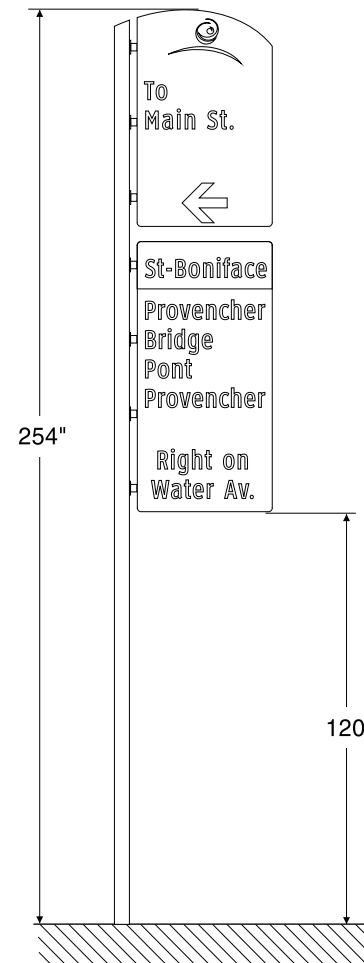

Field Notes for Installation:

New pole just beyond driveway to lot before York, in line with tree box edge.

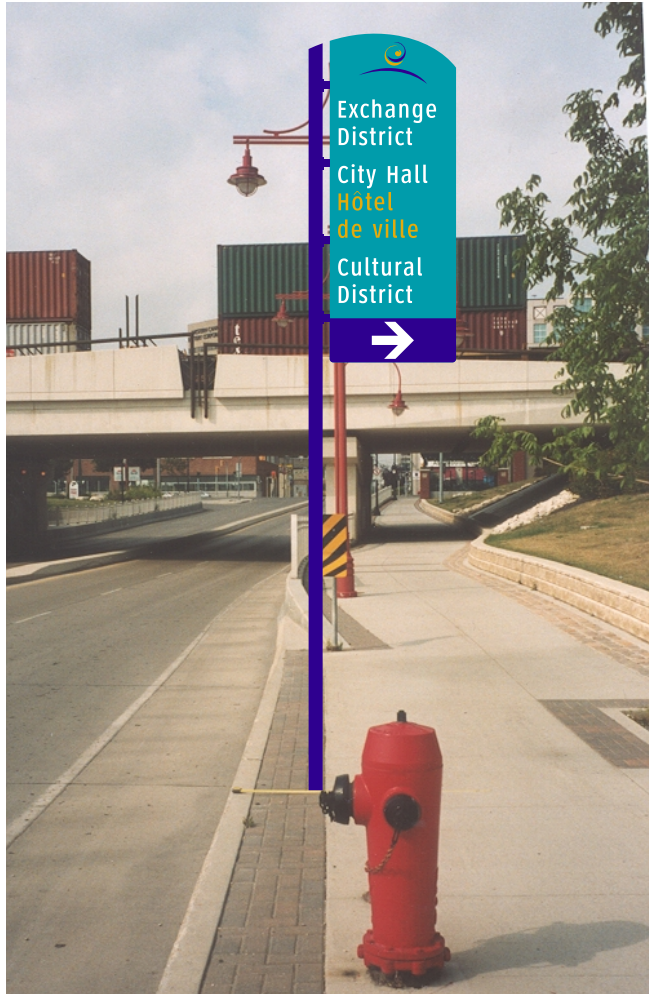

Field Notes for Installation:

210' from Waterfront, 10' beyond hydrant.

Pile Site Location N/S York Av east of Main St

Sign Panel	Panel Type
YW2	A logo

Pole Type **A**

