
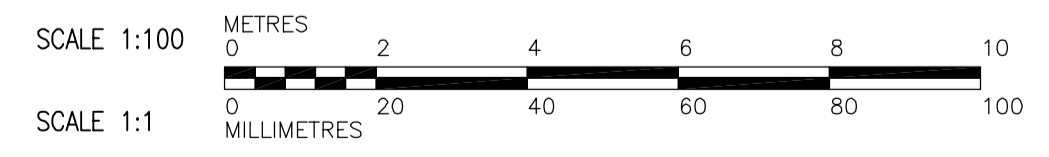


- NOTES:**
- SEE DWG. WF-M9101 FOR ROUND OPENING SIZES
  - FOR CORNER REINFORCING SEE DET.
  - ENCASE ALL PIPING UNDER BUILDING IN CONCRETE.  
SEE
  - PROVIDE TEMPORARY SHORING WHEN POURING FILL CONCRETE AT EXPANSION JOINT.
  - 15m @ 200 EW CENTRED.

BASE SLAB PLAN AT EL 231.000  
1:100

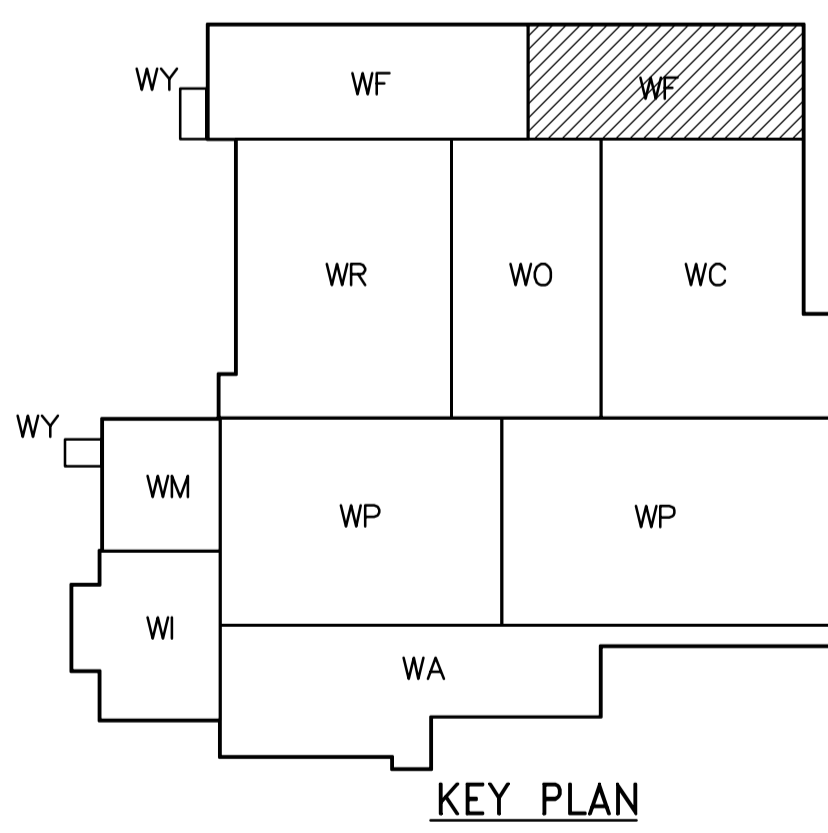

 Certificate of Authorization CH2M HILL Canada Ltd. No. 1441 Expiry: April 30, 2006	B.M. ELEV.	 Frederickson Cooper ARCHITECTS	 A You International Ltd. Company	ENGINEER'S SEAL  ORIGINAL SIGNED BY D. KRUGER 2006/02/06	 THE CITY OF WINNIPEG WATER AND WASTE DEPARTMENT ENGINEERING DIVISION  WATER TREATMENT PLANT FILTRATION AND CONCRETE STRUCTURES  STRUCTURAL FILTRATION AREA 2 LOWER LEVEL PLAN	CITY FILE NUMBER									
	<table border="1"> <tr> <td>01</td> <td>583-2005 ADDENDUM 3</td> <td>06/03/10</td> <td>KA</td> </tr> <tr> <td>00</td> <td>ISSUED FOR TENDER</td> <td>2006/02/03</td> <td>KA</td> </tr> <tr> <td>NO.</td> <td>REVISIONS</td> <td>DATE</td> <td>BY</td> </tr> </table>			01		583-2005 ADDENDUM 3	06/03/10	KA	00	ISSUED FOR TENDER	2006/02/03	KA	NO.	REVISIONS	DATE
01	583-2005 ADDENDUM 3	06/03/10	KA												
00	ISSUED FOR TENDER	2006/02/03	KA												
NO.	REVISIONS	DATE	BY												