


AECOM
As of January 3, 2009, EarthTech became AECOM Canada Ltd.

AECOM AS-CONSTRUCTED
SIG..... DATE.....

GENERAL NOTES:
A. EARTH TECH FIELD BOOK No. 4401
B. LOCATION OF UNDERGROUND STRUCTURES AS SHOWN ARE BASED ON THE BEST INFORMATION AVAILABLE, BUT NO GUARANTEE IS GIVEN THAT ALL EXISTING UTILITIES ARE SHOWN OR THAT THE GIVEN LOCATIONS ARE EXACT. CONFIRMATION OF EXISTING AND EXACT LOCATION OF ALL SERVICES MUST BE OBTAINED FROM THE INDIVIDUAL UTILITIES BEFORE PROCEEDING WITH CONSTRUCTION.
C. PHOSPHORUS REMOVAL FACILITY (BY OTHERS).

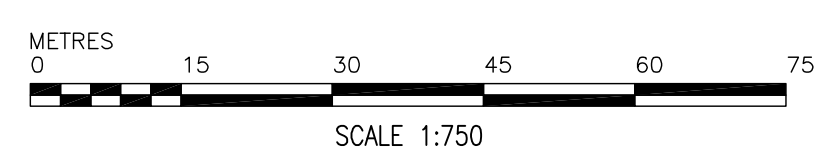

FOR REFERENCE ONLY

150 mm WM	WATERMAIN	150 mm WM	HYDRO	●	LIGHT STANDARD
◇	HYDRANT	+	M.T.S.	○B	BOLLARD
○	VALVE	○	CONCRETE	■	FIRE EXTINGUISHER
300mm LPS	LAND DRAINAGE SEWER	300mm LPS	ASPHALT	▣	CURB STOP
250mm WWS	WASTEWATER SEWER	250mm WWS	PROPERTY LINE	—	TREATED CENTRATE
○	MANHOLE	+	TEST HOLES		RAILWAY TRACK
□	CATCH BASIN	232.750	ELEVATION	(32.750)	DITCH
▽	CURB INLET	300s	TREE	—	RAS
+	JUNCTIONS	—	ANODE	—	WAS
—	CULVERT	—	CONCRETE SIDEWALK	—	FW
—	GAS	—	FENCE	—	CENTRATE
EXISTING	LEGEND - PLAN	PROPOSED	EXISTING	LEGEND - PLAN	PROPOSED

AECOM
Certificate of Authorization
AECOM Canada Ltd.
Original dated on: No. 4671 Date: 2006/05/15

13-027	W. side Main St. on the grounds of the North End Treatment Plant, 1st. on top of Conc. pit in front of main ELEV. bldg., 22.3m E. of line of most Ely. wall & 32.8m S. of most Nly. wall of main bldg. (ties to 1st.) ELEV. = 231.261m
02	AS-CONSTRUCTED DRAWING 09/02/18 CD
01	ISSUED FOR CONSTRUCTION 06/08/30 GLG
00	ISSUED FOR TENDER 06/05/15 FC
NO.	REVISIONS
	DATE BY
	DATE 2006/01/10
	DATE 2006/05/15

EarthTech
A Tyco International Ltd. Company

DESIGNED BY: GSK	CHECKED BY: KWF
DRAWN BY: FC	APPROVED BY: JEH
SCALE: 1:750	RELEASED FOR CONSTRUCTION BY: K. MARTENS
DATE 2006/01/10	DATE 2006/05/15

ENGINEER'S SEAL
ORIGINAL SIGNED BY
K.W. FITCHETT
2006/05/15

THE CITY OF WINNIPEG
WATER AND WASTE DEPARTMENT
ENGINEERING DIVISION

NEWPCC CENTRATE NUTRIENT TREATMENT NITROGEN REMOVAL FACILITY

CIVIL GENERAL ARRANGEMENT SITE UTILITIES

CITY FILE NUMBER
SHEET OF
CITY DRAWING NUMBER
1-0101C-C0003-001-02