



THE CITY OF WINNIPEG
 WATER AND WASTE DEPARTMENT
 Engineering Division
WATER TREATMENT PLANT
 SITE UTILITIES

ENGINEER'S SEAL
 ORIGINAL SIGNED BY
 K.W. FITCHETT
 2007/02/20
 CONSULTANT DRAWING NO.
 WH-03100

EarthTech
 CHECKED BY: CSK
 APPROVED BY: JBC
 RELEASED FOR CONSTRUCTION BY: R. SODERSTROM
 DATE: 2007/02/20

CONSTRUCTION
 BIDDING CLOSED BY: CSK
 AWARDED BY: JBC
 CONTRACT VALUE: \$1,500,000
 DATE: 2006/11/21

AS-CONSTRUCTED
 DATE: 2007/02/20

AECOM
 Certificate of Authorization
 AECOM Canada Ltd.
 No. 4671 Date: 2007/02/20


AECOM AS-CONSTRUCTED
 DATE: _____

AECOM
 100 King Street West
 Toronto, Ontario M5X 1C4
 Canada

AECOM
 100 King Street West
 Toronto, Ontario M5X 1C4
 Canada

AECOM
 100 King Street West
 Toronto, Ontario M5X 1C4
 Canada

AECOM
 100 King Street West
 Toronto, Ontario M5X 1C4
 Canada

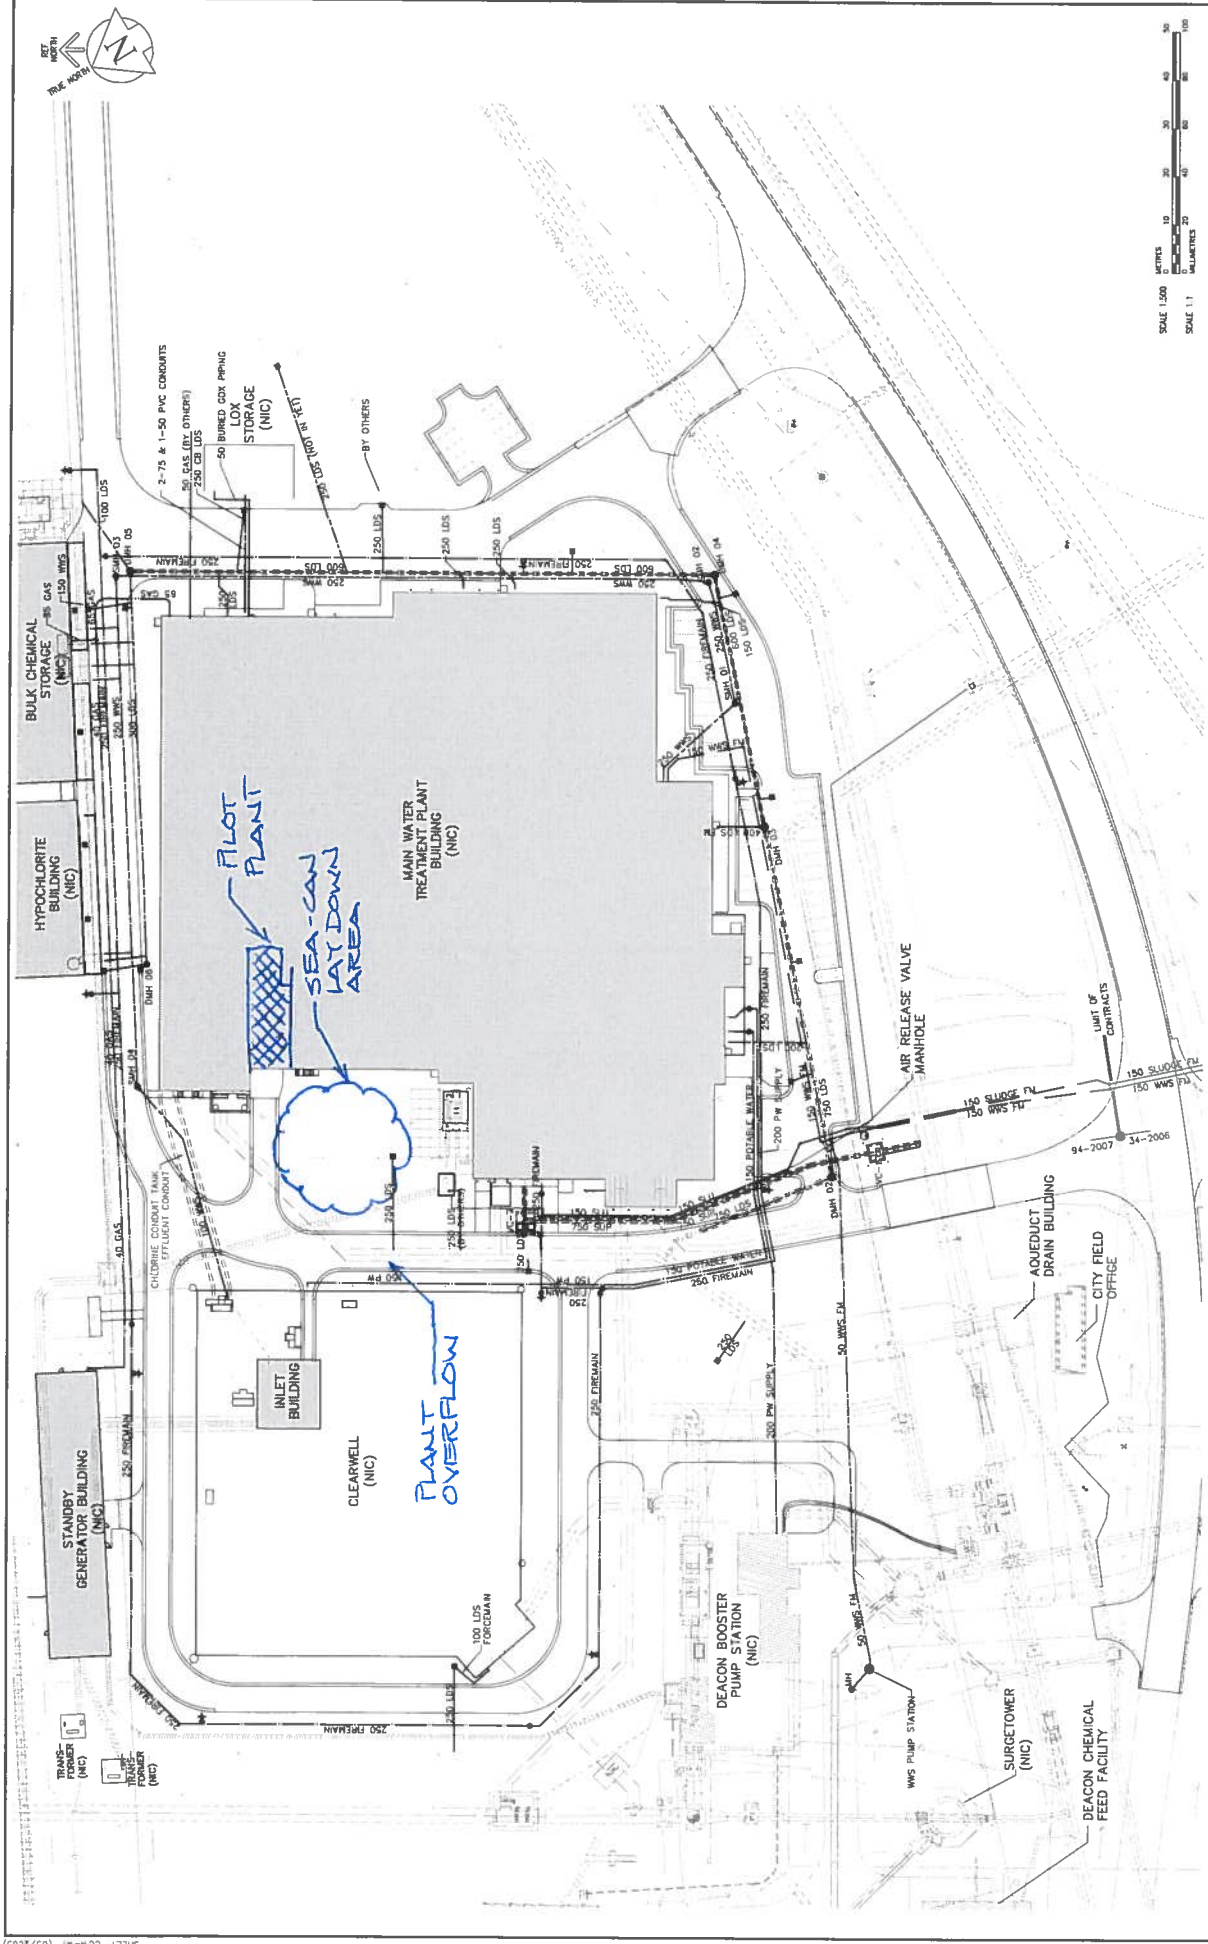

L:\WORK\7000\76538\03A-CAD\ALL\SUBMISSION\AS-BUILT\RECORD\C37 - 94-2007 UNDERGROUND SITE UTILITIES\AS-CONSTRUCTED DWG\1-000H-0002-001-030.DWG
 SHEET CC-M-41 (05/2005)