


DEMOLITION/REMOVAL NOTES:

- REMOVE ALL PAVEMENT AND GRASSED AREAS WITHIN THE SHOWN LIMITS OF WORK, AS REQUIRED FOR NEW CONSTRUCTION. LIMITS OF REMOVAL TO BE CONFIRMED WITH CONTRACT ADMINISTRATOR PRIOR TO COMMENCEMENT OF WORK.
- REMOVE OR RELOCATE ALL EXISTING TREES WITHIN THE SHOWN LIMITS OF WORK, AS REQUIRED FOR NEW CONSTRUCTION. LIMITS OF TREE REMOVAL TO BE CONFIRMED BY CONTRACT ADMINISTRATOR PRIOR TO COMMENCEMENT OF WORK, AND ACCEPTED BY C.O.W. URBAN FORESTRY BRANCH.
- SALVAGE EXISTING SIGNAGE, POSTS AND HARDWARE SECURED TO ANY FENCING, LIGHT POSTS OR PAVEMENT AREAS, AS DIRECTED BY THE CONTRACT ADMINISTRATOR. SALVAGED SIGNS, POSTS AND HARDWARE TO BE SORTED TO THE SATISFACTION OF THE CONTRACT ADMINISTRATOR AND DELIVERED TO THE FACILITY MAINTENANCE SUPERVISOR.
- TEMPORARILY RELOCATE ALL GARBAGE BINS TO AN ON-SITE LOCATION DESIGNATED BY THE FACILITY MAINTENANCE SUPERVISOR OR CONTRACT ADMINISTRATOR, AS REQUIRED TO FACILITATE CONSTRUCTION.

GENERAL CONSTRUCTION NOTES:

- ALL PRODUCTS INCORPORATED IN THE WORK SHALL CONFORM TO THE CITY WINNIPEG "STANDARD CONSTRUCTION SPECIFICATIONS" AND SHALL BE REGISTERED IN THE CITY OF WINNIPEG LISTING OF APPROVED PRODUCTS OR AS SPECIFIED ON THIS DRAWING. ALL CONSTRUCTION TO CONFORM TO THE CITY OF WINNIPEG "STANDARD CONSTRUCTION SPECIFICATIONS", LATEST EDITION.
- IT IS THE RESPONSIBILITY OF THE CONTRACTOR TO VERIFY THE LOCATIONS OF ALL UTILITIES, PIPES, SURVEY MARKERS, OR STRUCTURES, AND TO NOTIFY ALL RELEVANT UTILITIES PRIOR TO COMMENCEMENT OF CONSTRUCTION. THE CONTRACTOR IS TO NOTIFY THE CONTRACT ADMINISTRATOR OF ANY ERROR OR OMISSION PRIOR TO CONSTRUCTION.
- IN ACCORDANCE TO THE CITY OF WINNIPEG SURVEY INFRASTRUCTURE PROTECTION PROGRAM, THE CONTRACTOR IS TO NOTIFY THE GEOMATICS BRANCH A MINIMUM 3 DAYS PRIOR TO START OF CONSTRUCTION.
- DESCRIPTION OF PROPERTY LIMITS, AND EXISTING AND/OR PROPOSED FEATURES RELATIVE TO THESE LIMITS AS SHOWN ON THIS DRAWING DO NOT REPRESENT A LEGAL SURVEY. WSP MAKES NO REPRESENTATION OR GUARANTEE THAT THE PROPERTY LIMIT INFORMATION IS ACCURATE. WSP ACCEPTS NO RESPONSIBILITY FOR DAMAGES, IF ANY, SUFFERED BY ANY THIRD PARTY AS A RESULT OF DECISIONS OR ACTIONS BASED ON THIS DRAWING.
- ALL ITEMS TO BE REMOVED OR DEMOLISHED SHALL BE LEGALLY DISPOSED OF. IF NOTED OTHERWISE, ITEMS SHALL BE SALVAGED AND DELIVERED TO THE FACILITY MAINTENANCE SUPERVISOR.
- THE CONTRACTOR SHALL SCHEDULE AND STAGE CONSTRUCTION ACTIVITIES TO MEET THE FOLLOWING ACCESS REQUIREMENTS:
 - AMBULANCE, FIRE LANE AND EMERGENCY VEHICLE ACCESS TO BE MAINTAINED AT ALL TIMES TO THE MAIN ENTRANCE OF THE BUILDING.
 - SAFE PEDESTRIAN ACCESS TO THE MAIN ENTRANCE OF THE BUILDING SHALL BE MAINTAINED AT ALL TIMES FROM THE EXISTING PARKING AND SIDEWALK AREAS.
 - REFUSE AND RECYCLING VEHICLE ACCESS SHALL BE MAINTAINED AT ALL TIMES.

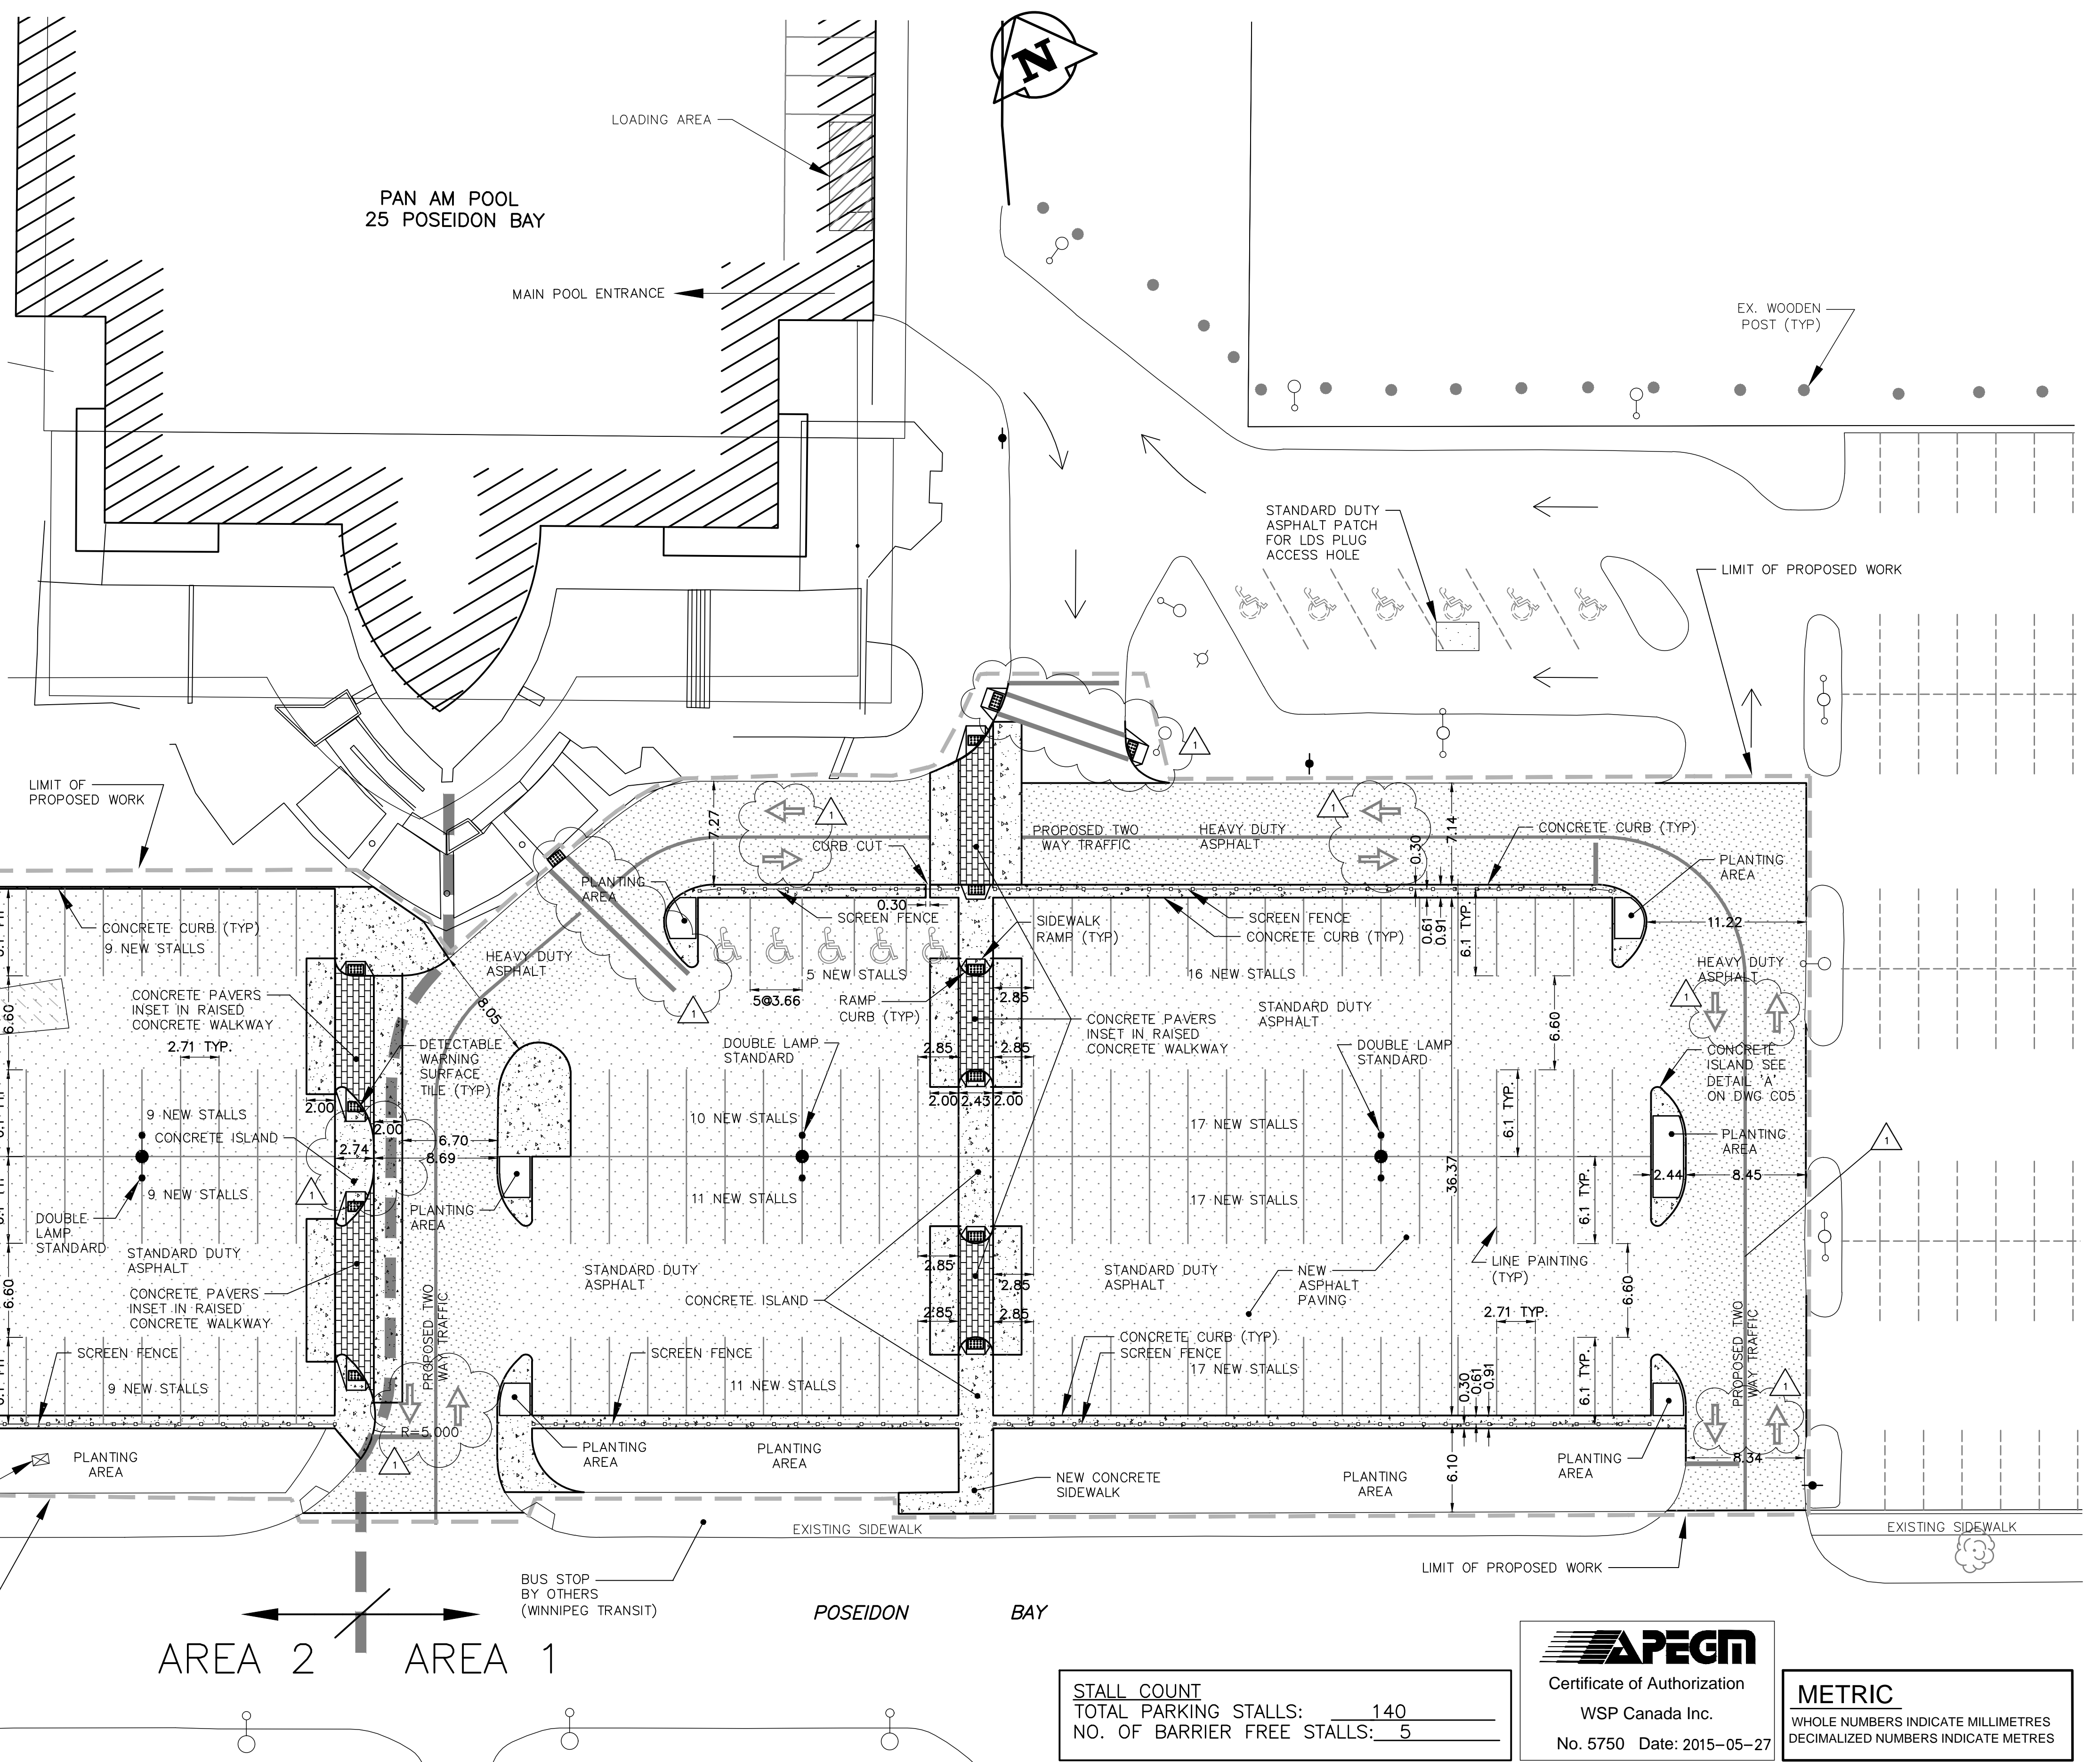

STALL COUNT	
TOTAL PARKING STALLS:	140
NO. OF BARRIER FREE STALLS:	5

APEGM
 Certificate of Authorization
 WSP Canada Inc.
 No. 5750 Date: 2015-05-27

METRIC
 WHOLE NUMBERS INDICATE MILLIMETRES
 DECIMALIZED NUMBERS INDICATE METRES

EXISTING	LEGEND - PLAN	NEW	EXISTING	LEGEND - PLAN	NEW	EXISTING	LEGEND - PROFILE	NEW
150 mm WM	WATERMAIN	150 mm WM	---	GAS	---	CENTRELINE OF SWALE	ELEVATION	230.000 COS
300 mm LDS	LAND DRAINAGE SEWER	300 mm LDS	---	HYDRO	---	CATCH BASIN ELEVATION	230.000 CB	
250 mm CS	WASTE WATER SEWER	250 mm CS	---	PEDESTAL	---	TESTHOLE		
○	MANHOLE	●	---	PROPERTY LINE	---	TOPSOIL & SOD		
□	CATCH BASIN	■	---	SURVEY BAR	---	ASPHALT		
△	CURB INLET	▲	230.000	CURB STOP	---	CURBING		
△	SIGN	▲	230.000	GROUND ELEVATION	(230.000)	TREE		
○-○	LAMP STANDARD	●-●	---	PAVEMENT ELEVATION	(230.000)	CONCRETE		
•	UTILITY POLE	•	---			PAVERS		

LOCATION APPROVED UNDERGROUND STRUCTURES

SUPV. U/G STRUCTURES COMMITTEE DATE

NOTE: LOCATION OF UNDERGROUND STRUCTURES AS SHOWN ARE BASED ON THE BEST INFORMATION AVAILABLE BUT NO GUARANTEE IS GIVEN THAT ALL EXISTING UTILITIES ARE SHOWN OR THAT THE GIVEN LOCATIONS ARE EXACT. CONFIRMATION OF EXISTENCE AND EXACT LOCATION OF ALL SERVICES MUST BE OBTAINED FROM THE INDIVIDUAL UTILITIES BEFORE PROCEEDING WITH CONSTRUCTION.

C.W.B.M. 52-012..... 233.701m N.E. CORNER OF TAYLOR AVE. AND CAMBRIDGE ST. AT REAR OF NO. 880 CAMBRIDGE ST. FACING TAYLOR AVE., A TABLET IN S. SIDE OF SQUARE CONCRETE VENTILATOR FOR UNDERGROUND GARAGE.

1	ISSUED FOR ADDENDUM 2	15/06/19	B.J.
0	ISSUED FOR CONSTRUCTION	15/06/15	B.J.
0	ISSUED FOR TENDER	15/05/27	--
-		11/04/00	--
NO. REVISIONS		DATE	BY

WSP

1600 BUFFALO PLACE
 WINNIPEG, MB, R3T 6B8
 PHONE: 204-477-6550
 FAX: 204-474-2864
 WWW.WSPGROUP.COM

DESIGNED BY: B.J.
 CHECKED BY: B.J.
 DRAWN BY: G.P.
 APPROVED BY: B.J.
 HOR. SCALE: 1:250 (A1)
 VERT. SCALE: ---
 DATE: APRIL 2015

ENGINEER'S SEAL

ORIGINAL DRAWING SEALED BY G.B. JONSON and DATED May 27, 2015

CONSULTANT DRAWING NO. 121-24877-C02

THE CITY OF WINNIPEG
 PLANNING, PROPERTY & DEVELOPMENT

PAN AM INDOOR POOL PARKING LOT REDEVELOPMENT-PHASE 1
 SITE LAYOUT PLAN

CITY DRAWING NO. 432-2015-C02
 SHEET 2 OF 9
 REV. C02 1