


REVISED AS CONSTRUCTED  
 DATE 04.12.7 BY [Signature]  
 CHECKED BY [Signature]  
 1:40  
 1:200  
 1:50  
**B-5515-4**  
**METRIC**  
 WHOLE NUMBERS INDICATE MILLIMETRES  
 DECIMALIZED NUMBERS INDICATE METRES

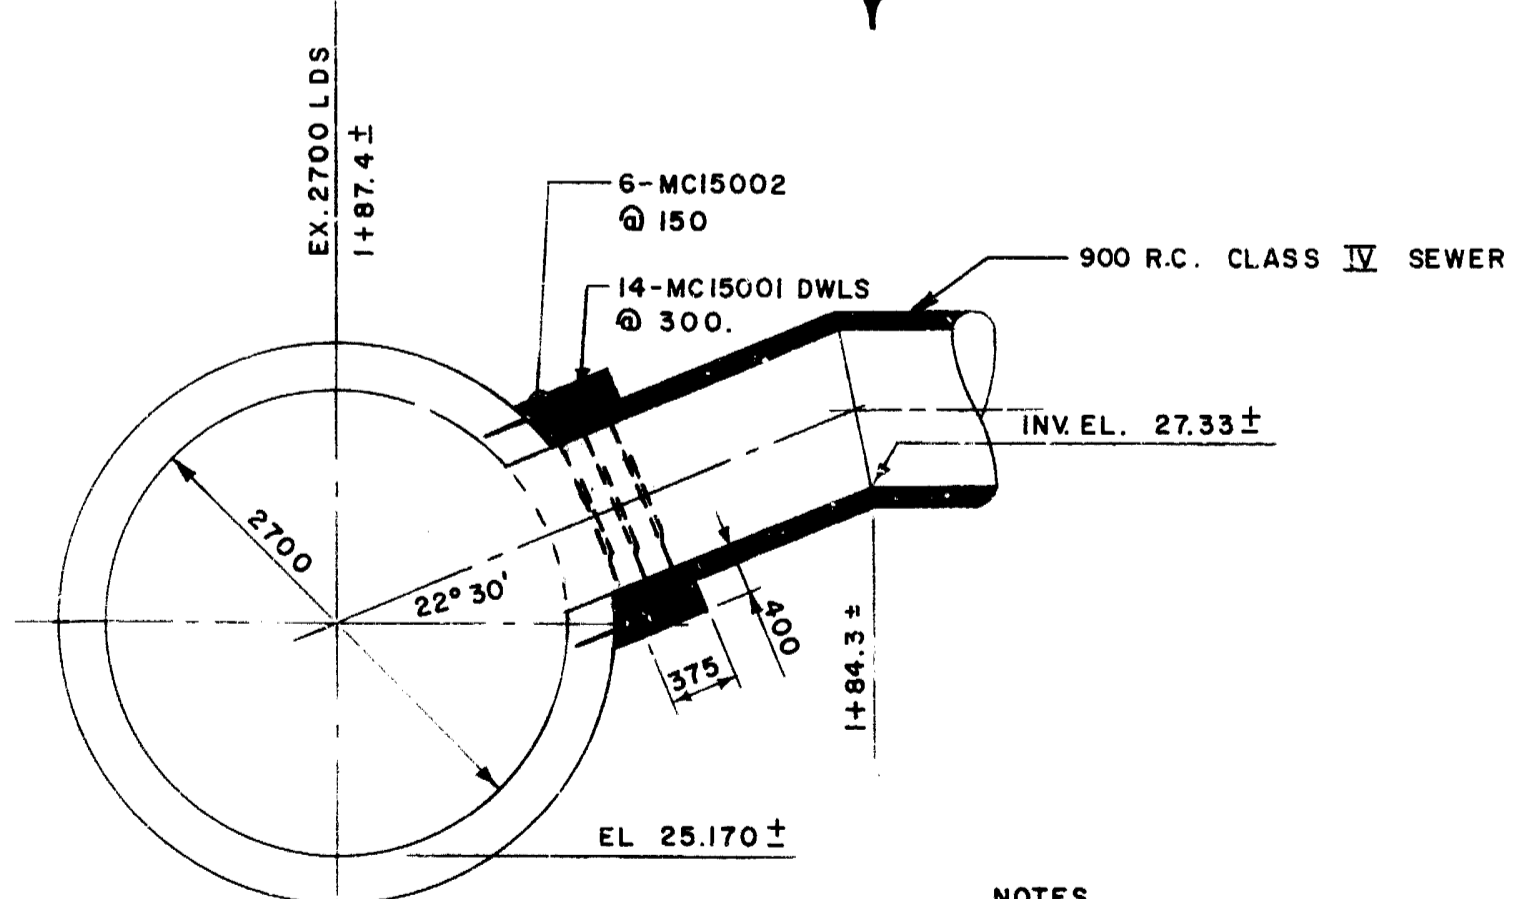

NOTES  
 1. CONCRETE NOTES DWG. P06  
 2. REINFORCING NOTES DWG. P08

DETAIL A  
 SCALE 1:40 P04

150 mm W.M.	WATERMAIN	150 mm W.M.			
	HYDRANT				
	CATCH BASIN				
	CURB INLET				
	JUNCTIONS				
	GAS				
	EXISTING				

ENGINEER'S SEAL

**ide** INTERDISCIPLINARY ENGINEERING COMPANY  
 PROFESSIONAL ENGINEERS WINNIPEG, MANITOBA  
 DESIGNED BY: G.W.M.  
 CHECKED BY: G.W.M.  
 APPROVED BY: A. Wyszka  
 DRAWN BY: [Signature]  
 DATE: 21-05-82  
 DATE: 10/6/82

**THE CITY OF WINNIPEG**  
 WORKS & OPERATIONS DIVISION  
 STREETS & TRANSPORTATION DEPARTMENT

**ROUTE 90 UNDERPASS**  
**LAND DRAINAGE SEWER**  
 STA 1+00 TO STA 1+87.4<sup>+</sup> NORTH  
 AUTHORIZED BY: [Signature] 1982-10-08  
 ACCEPTED BY: [Signature] 12.10.82  
 SCALE: HORIZ. 1:200 VERT. 1:50  
 DRAWING NO. U228-83-P04