



1 FLOOR PLAN EL. 235.915
1:100

AS CONSTRUCTED
DATE MAY 1996 BY C.J.A.
APPROVED BY *Shelly Selman*

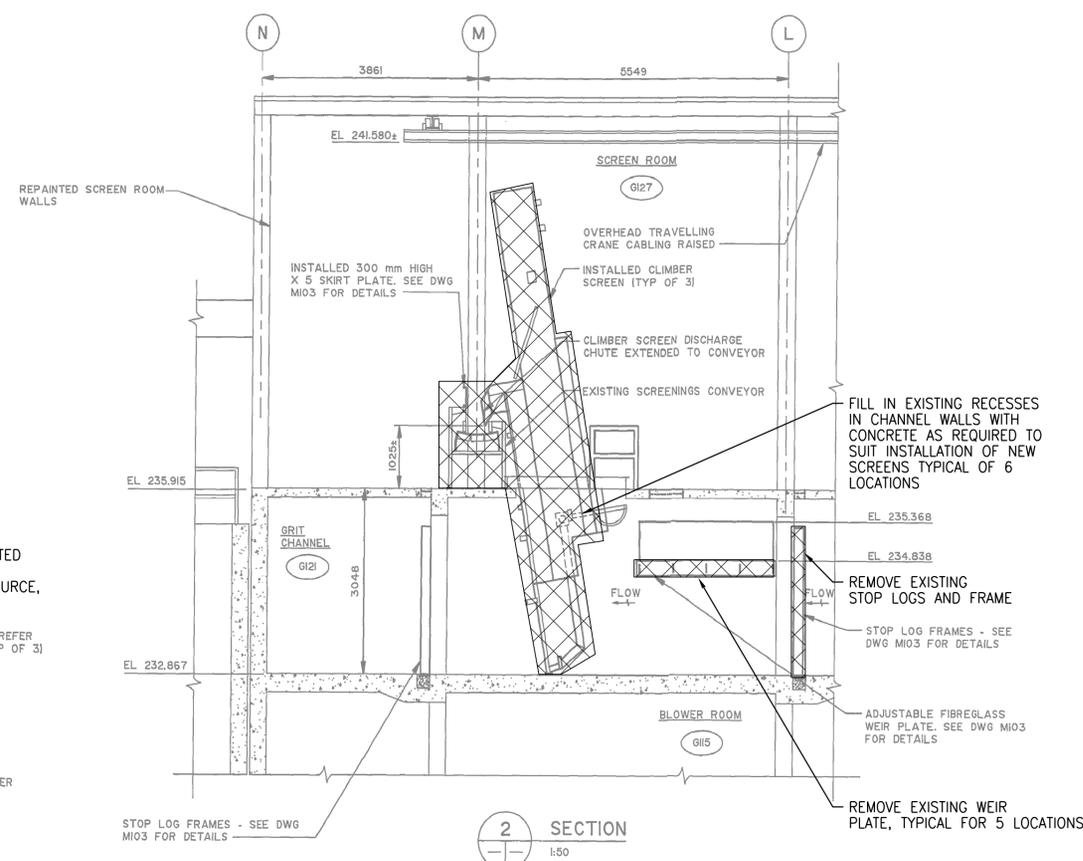

2 SECTION
1:50

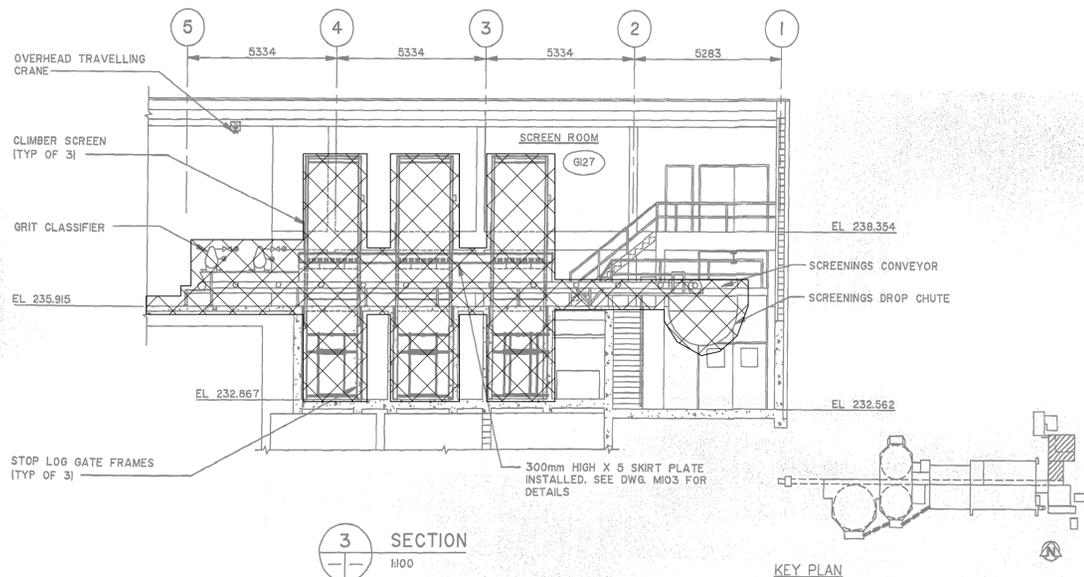


3 SECTION
1:100

KEY PLAN
NTS

- NOTES:**
- FOR NEW CONSTRUCTION SEE MECHANICAL HEADWORKS DRAWINGS.
 - REFER TO GENERAL DEMOLITION NOTES DRAWING 1-0102-DAAA-AD01.

SEALING ARCHITECT OR ENGINEER ACCEPTS RESPONSIBILITY ONLY FOR AREAS IDENTIFIED BY CLOUDING ON THIS DRAWING.
NOTE: THIS DRAWING SUPERSEDES DRAWING SEP-2412

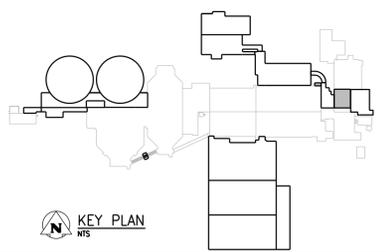

PLANS AND SECTIONS
NTS

APEGM
Certificate of Authorization
CH2M HILL Canada Ltd.
No. 1441

NO.	REVISIONS	DATE	DESIGN	CHECK
01	ISSUED FOR ADDENDUM 7 - 976-2016	2017/07/20	JBC	
00	ISSUED FOR CONSTRUCTION - 976-2016	2017/04/05	B.C. J.C.	

CH2MHILL
SNC-LAVALIN

DESIGNED BY: B. EDGAR
DRAWN BY: B. COOPER
SCALE: NTS

CHECKED BY: F. ABSI
APPROVED BY: H.T. FREIHAMMER
ISSUED FOR CONSTRUCTION BY: J. SHUMKA
DATE: 2017/04/05

CONSULTANT NO.: 474248

ENGINEER'S SEAL
24 July 2017
F. J. ABSI
Member
36875
REGISTERED PROFESSIONAL ENGINEER

THE CITY OF WINNIPEG
Winnipeg WATER AND WASTE DEPARTMENT

SOUTH END WATER POLLUTION CONTROL CENTRE
SEWPC UPGRADING/EXPANSION PROJECT
HEADWORKS - GRIT BUILDING
PROCESS EQUIPMENT AND PIPING
PLANS AND SECTIONS

CITY DRAWING NUMBER: 1-0102-PGAD-GD53
SHEET: 01
REV: 01
SIZE: A1