



1 SECTION
M128 | M129 1:50

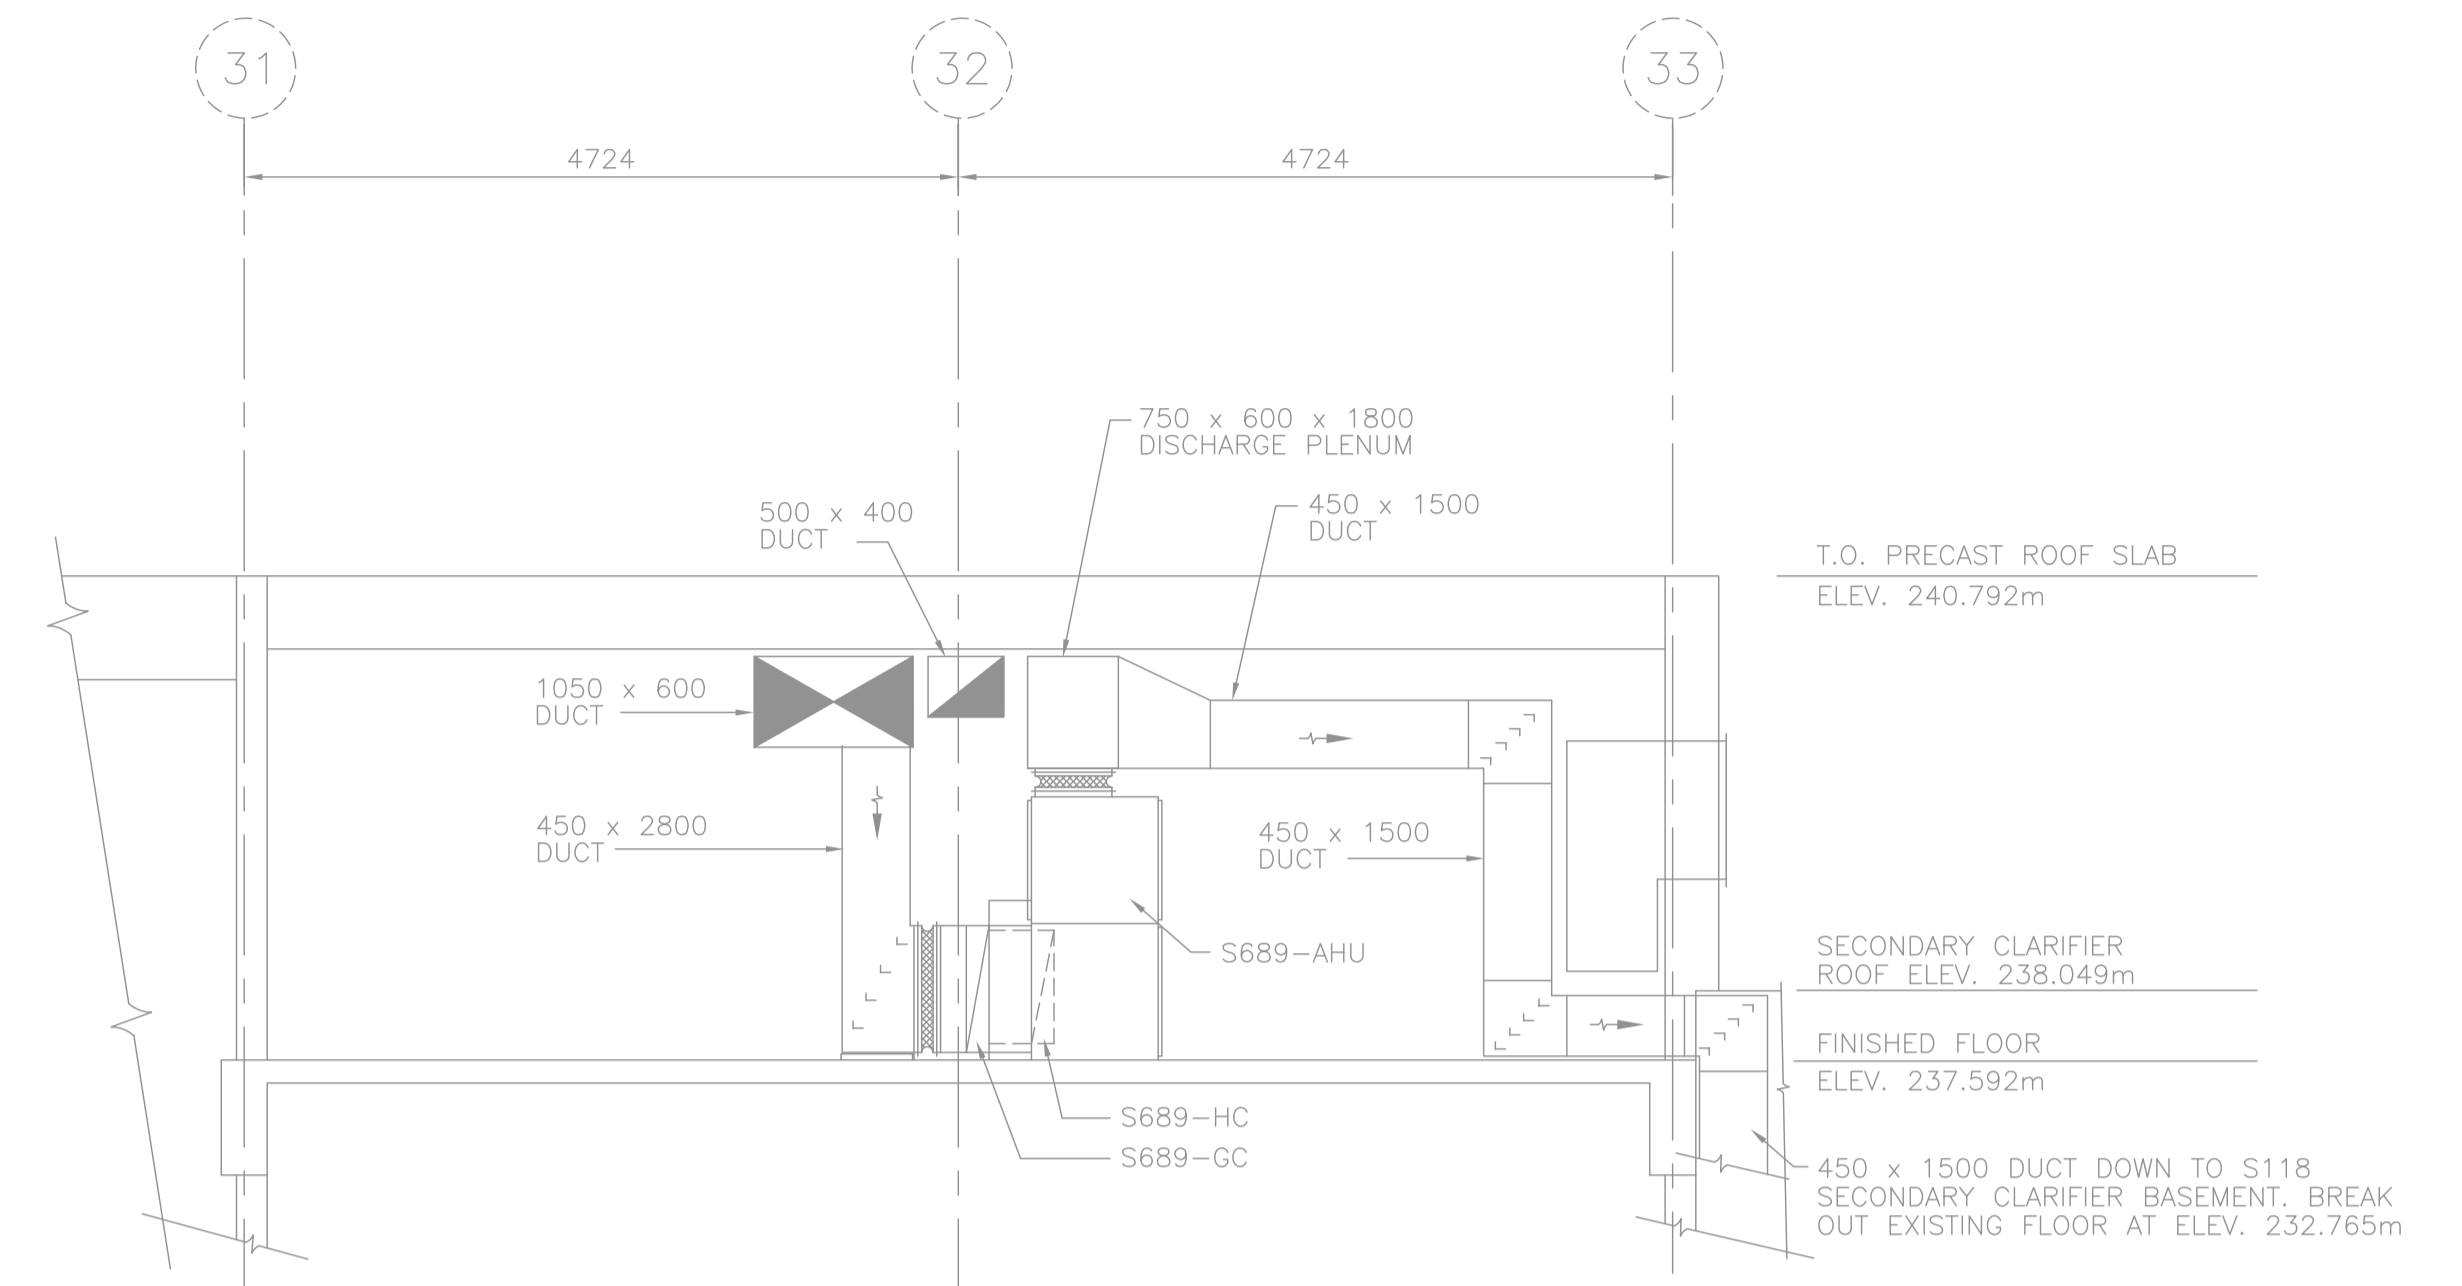

2 SECTION
M128 | M129 1:50

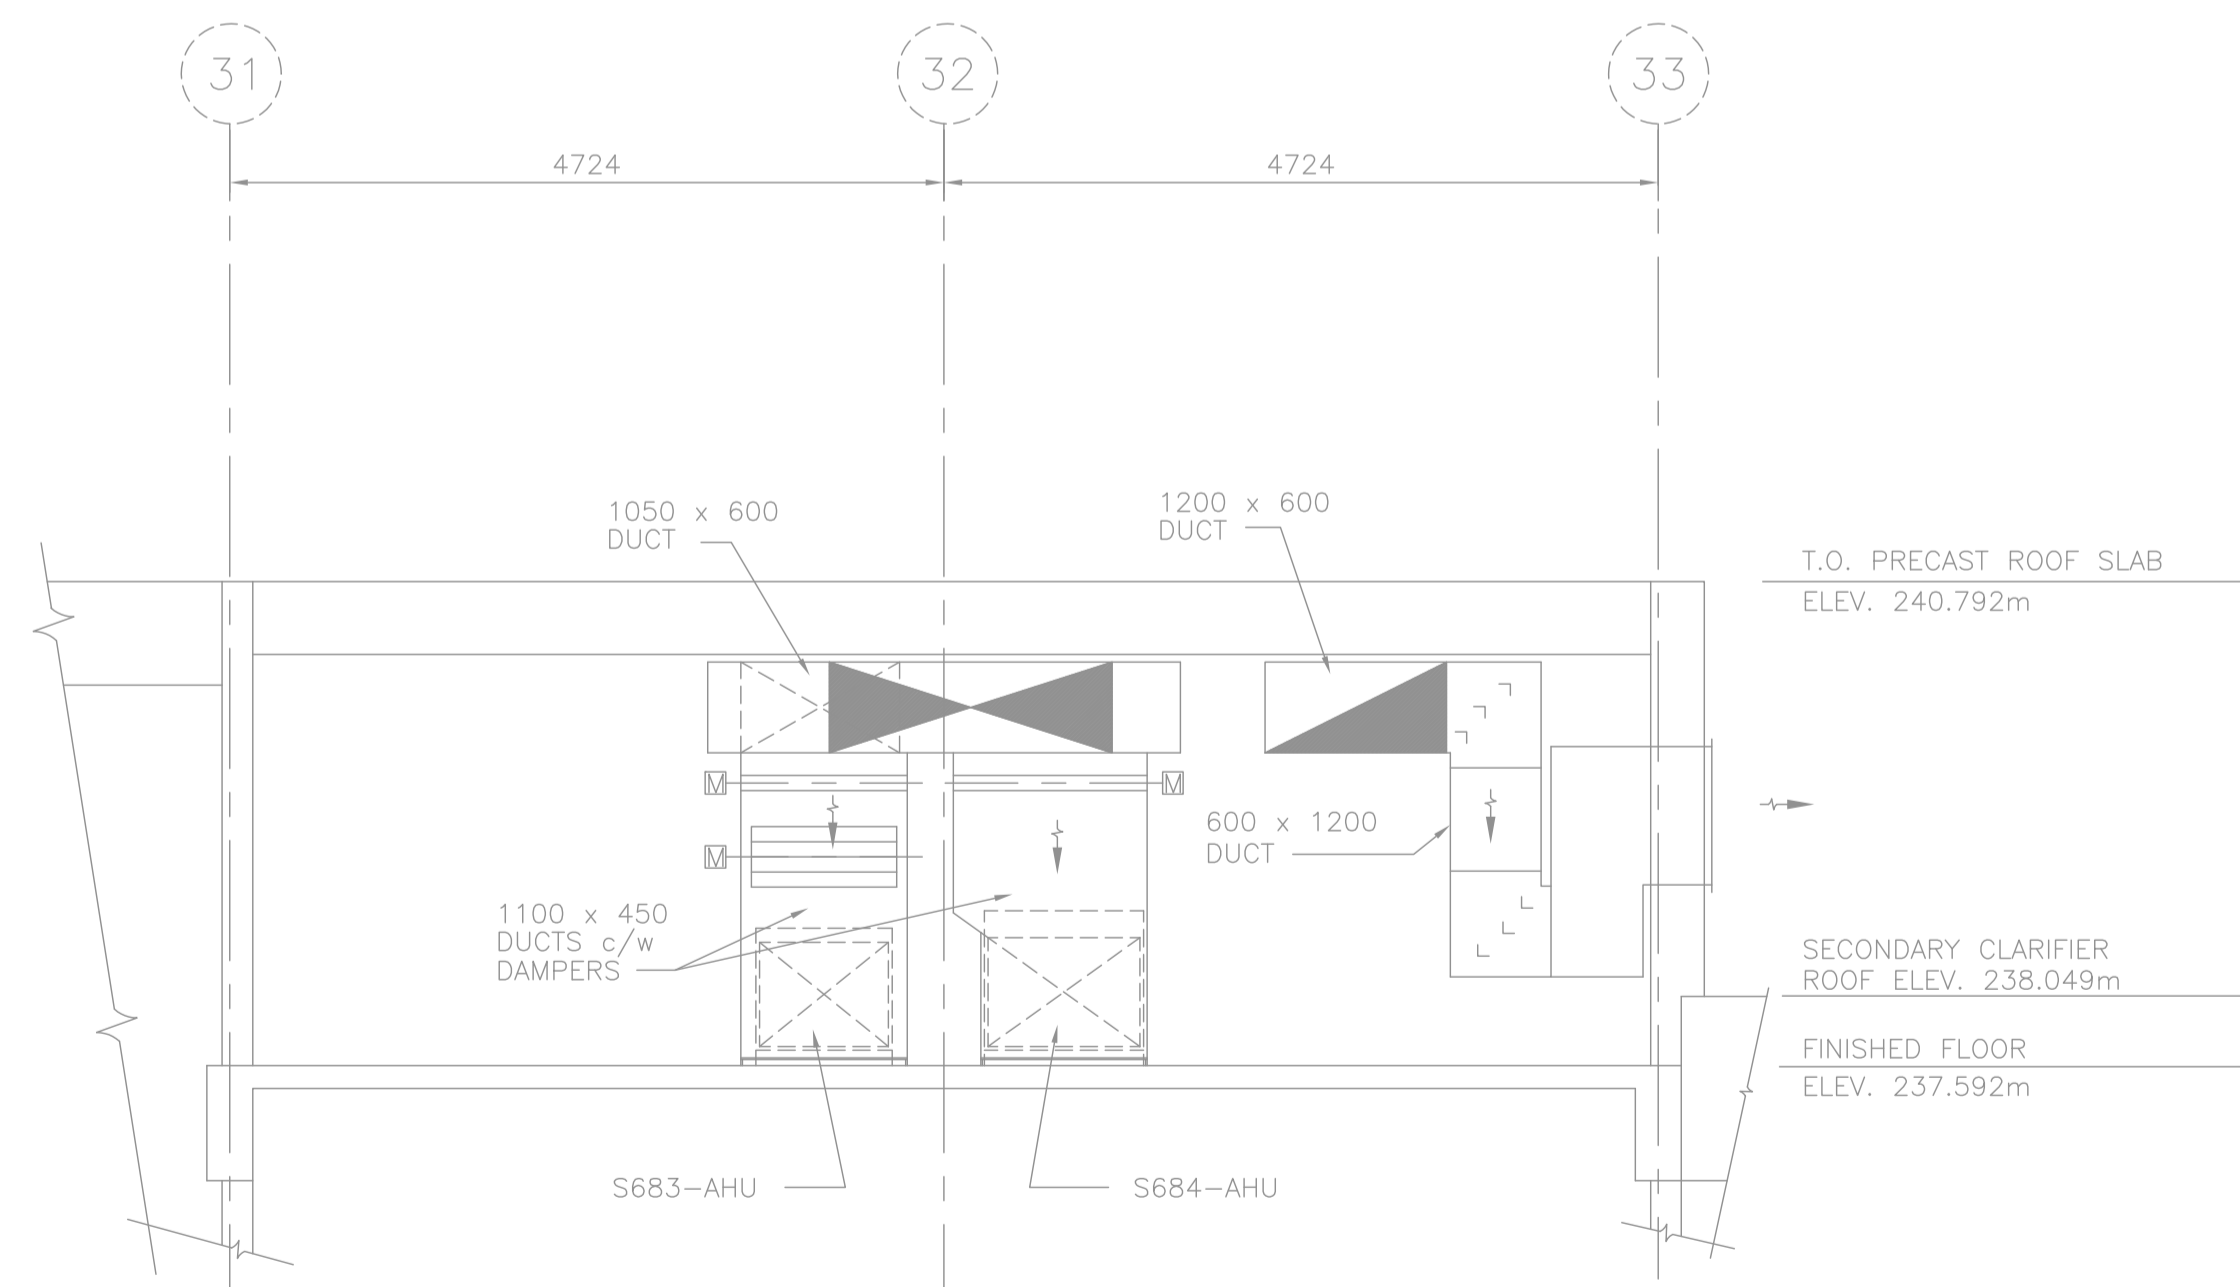

3 SECTION
M128 | M129 1:50

- NOTES:
- REFER TO GENERAL DEMOLITION NOTES DRAWING 1-0102-DAAA-AD01.
 - CONFIRMED ASBESTOS CONTAINING MATERIALS IN AIR HANDLING UNIT. REFER TO ASBESTOS ABATEMENT SPECIFICATIONS FOR ABATEMENT PROCEDURES.
 - CONFIRMED ASBESTOS CONTAINING MATERIALS IN DUCTWORK INSULATION. REFER TO ASBESTOS ABATEMENT SPECIFICATIONS FOR ABATEMENT PROCEDURES.
 - CONFIRMED ASBESTOS CONTAINING MATERIALS IN HEATING WATER FITTINGS INSULATION. REFER TO ASBESTOS ABATEMENT SPECIFICATIONS FOR ABATEMENT PROCEDURES.

AS CONSTRUCTED

DATE SEPTEMBER 1999 BY P.R.B.

APPROVED BY

NO.	REVISIONS	DATE	BY	DATE	BY
3	ISSUED FOR ADDENDUM 7 - 976-2016	07/17	JBC		
2	ISSUED FOR CONSTRUCTION - 976-2016	04/17	P.R.B.		
1	AS CONSTRUCTED	09/93	P.R.B.		
0	ISSUED FOR TENDER	07/90	S.Q.		
-	ISSUED FOR APPROVAL	04/90	S.Q.		

DESIGNED BY S.Q.		CHECKED BY	
DRAWN BY V.J.H.		APPROVED BY	
HOR. SCALE: 1:50		RELEASED FOR CONSTRUCTION:	
VERTICAL: 1:50		DATE	
MARCH 1990		DATE	

ORIGINALLY DESIGNED BY

PROVINCE OF MANITOBA

T.T. TRAN
Member
40578

REGISTERED PROFESSIONAL ENGINEER

CONSULTANT DRAWING NO.
870012-01-22-S-M129

THE CITY OF WINNIPEG
WORKS AND OPERATIONS DIVISION
WATERWORKS, WASTE & DISPOSAL DEPARTMENT

SOUTH END WATER POLLUTION CONTROL CENTRE
SECONDARY CLARIFIER EXPANSION-MECHANICAL

VENTILATION ROOM S114
SECTIONS
HEAT, VENTILATION AND DUCTWORK

CITY DRAWING NUMBER
SHEET OF
SEP-449