

0	
1:5	
15	(
-	
250	
H`	1
N	
100	

150 WM	WATERMAIN	150 WM		CONCRETE		150 WM	WATERMAIN	150 WM		B.M. ELE				DESIGNED BY	WPN		ENGINEER'S
-Q-	HYDRANT	<b>—</b>		ASPHALT		<u>300</u> LDS	LAND DRAINAGE SEWER		UNDERGROUND STRUCTURES		v.					``\,	
$\otimes$	VALVE	$\otimes$		PLANING		2 <u>50_WWS</u>	WASTE WATER SEWER	250 WWS							GLG		20VING
0	MANHOLE	•		SIDEWALK	<u></u>		HYDRANT	<del></del>	SUPV. U/G STRUCTURES DATE						GLG		
	CATCH BASIN			PAVING STONES			VALVE							CHECKED			∦_ ( .
$\bigtriangledown$	CURB INLET	▼		PARTIAL DEPTH REPAIR	<u>/././././.</u>	— · <del>×</del> · —	ହ PROFILE							BY	WPN	DILLON	RG N
300 LDS	LAND DRAINAGE SEWER	300 LDS		PROPERTY LINE			NORTH/WEST GUTTER							APPROVED		CONSULTING	STE
50 WWS	WASTE WATER SEWER	250 WWS	$\longrightarrow$	DRAINAGE ARROW		— — <u> </u> — —	SOUTH/EAST GUTTER		LOCATION OF UNDERGROUND STRUCTURES AS					BY	—		1780
HYDRO	HYDRO	HYDRO		CURB RAMP (SD-229C)		<u> </u>	NORTH/WEST DITCH		LOCATION OF UNDERGROUND STRUCTURES AS SHOWN ARE BASED ON THE BEST INFORMATION AVAILABLE. BUT NO GUARANTEE IS GIVEN THAT ALL EXISTING UTILITIES ARE SHOWN OR							RELEASED FOR	
MTS	M.T.S.	MTS		DETECTABLE WARNING			SOUTH/EAST DITCH		THAT ALL EXISTING UTILITIES ARE SHOWN OR THAT THE GIVEN LOCATIONS ARE EXACT.	1	ADDENDUM #5	18/03/16	WPN	HOR. SCALE	1:500	CONSTRUCTION	
DO GAS	GAS	100 GAS		SURFACE TILE (SD-229AA)					THAT THE GIVEN LOCATIONS ARE SHOWN OF THAT THE GIVEN LOCATIONS ARE EXACT. CONFIRMATION OF EXISTENCE AND EXACT LOCATION OF ALL SERVICES MUST BE OBTAINED FROM THE INDIVIDUAL UTILITIES BEFORE PROCEEDING WITH CONSTRUCTION.	0	ISSUED FOR TENDER	18/02/09	WPN	VERTICAL	1:50		CONSULTAN
ISTING	LEGEND-PLAN	PROPOSED	EXISTING	LEGEND-PLAN	PROPOSED	EXISTING	LEGEND-PROFILE	PROPOSED	BEFORE PROCEEDING WITH CONSTRUCTION.	NO.	REVISIONS	DATE	BY	DATE		DATE	- 1

0	12.5	25
		m
1:500		

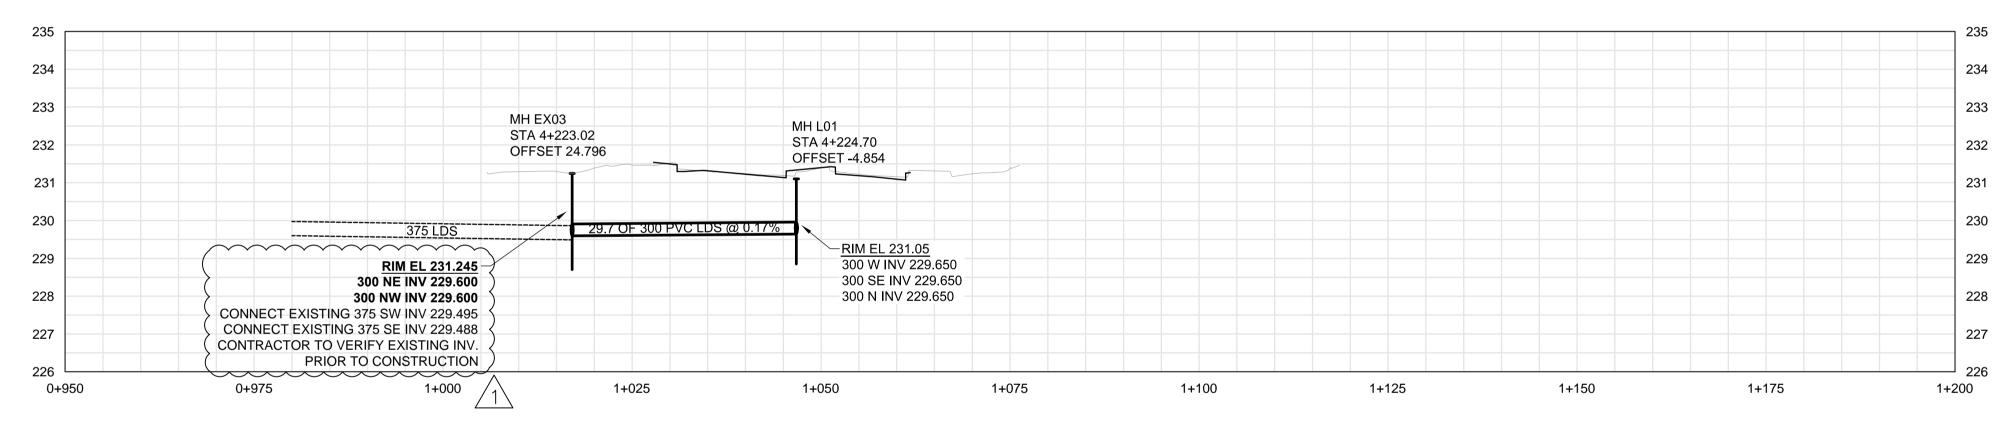

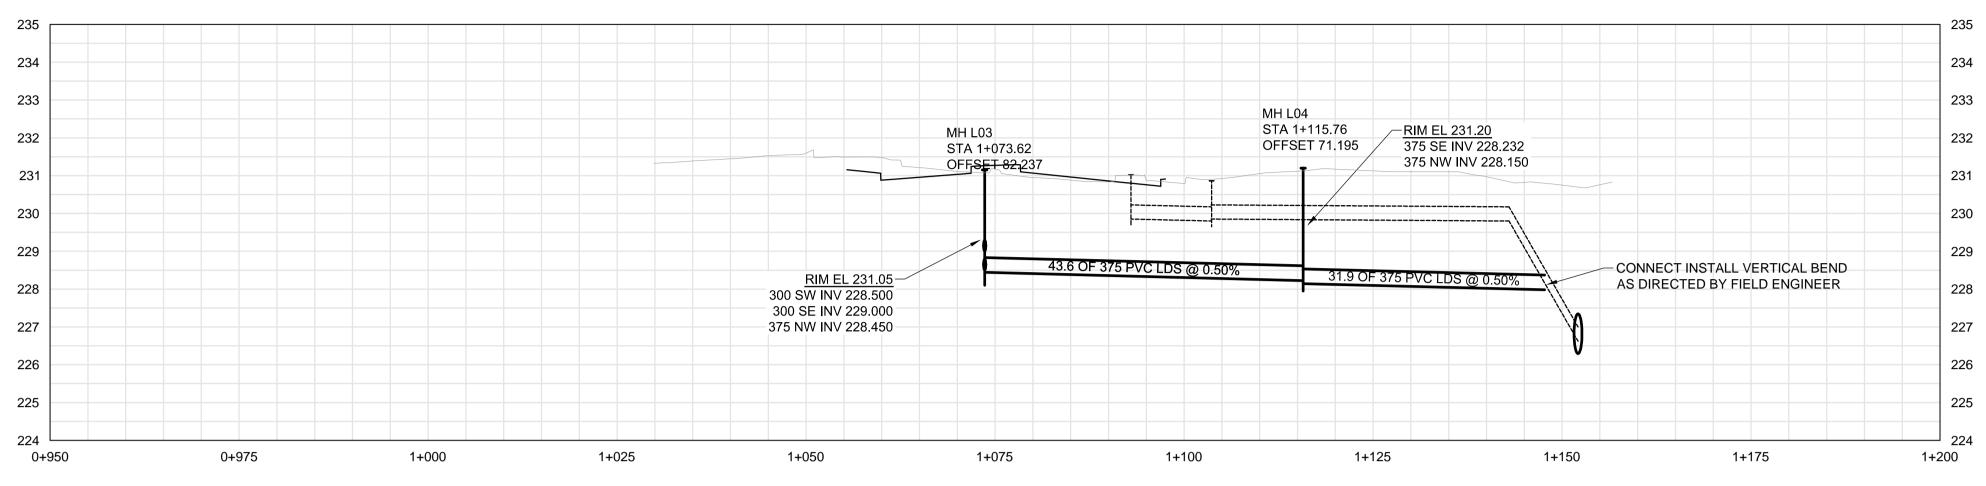

#### STE ANNE'S NORTHBOUND CONTROL LINE - MH L03 TO 1050 LDS

#### STE ANNE'S NORTHBOUND CONTROL LINE - MH EX03 TO MH L01

CONSTRUCTION NOTES:

- 1. ALL DIMENSIONS ARE TO BACK OF CURB.
- 2. ISOLATE MISCELLANEOUS ITEMS IN NEW CONCRETE WORKS AS PER SD-228C.
- 3. LEGAL PLAN AND UNDERGROUND INFORMATION FROM CITY OF WINNIPEG LBIS.
- 4. CONTRACTOR TO TAKE PRECAUTIONARY STEPS TO AVOID DAMAGE FROM CONSTRUCTION ACTIVITIES TO TREES WITHIN THE LIMITS OF CONSTRUCTION.
- 5. LOCATION OF EXISTING SERVICES TO BE CONFIRMED IN THE FIELD BY THE CONTRACTOR.
- 6. CB LEADS TO BE INSTALLED AT MIN. 1.0% SLOPE OR AS DIRECTED BY CONTRACT ADMINISTRATOR.
- 7. ADJUST EXISTING CATCH BASINS AND MANHOLES AND ISOLATE AS PER SD-220A.
- 8. PROTECT EXISTING LEGAL PINS IN NEW PAVEMENT UTILIZING A WATER VALVE INSERT. GRIND OFF SYMBOL ON COVER.
- 9. CONCRETE PAVEMENT IN MINOR STREET APPROACHES, PRIVATE APPROACHES AND MEDIAN OPENINGS SHALL BE HAND PLACED WITH INTEGRAL CURB CONSTRUCTION (SD-203A OR SD-203B AS SPECIFIED). MAIN LINE CONCRETE PAVEMENT SHALL BE SLIP FORMED UNLESS OTHERWISE REQUIRED DUE TO TRAFFIC STAGING RESTRICTIONS.
- 10. INSTALL 150 mm SUB DRAIN IN BOTH DIRECTIONS OF CATCH BASINS WHERE INDICATED, ALONG PAVEMENT EDGE AS PER SD-245 AND CAP ENDS.
- 11. SEE STAGING DRAWINGS FOR REMOVAL AND ADJUSTMENT PHASING

## METRIC

WHOLE NUMBERS INDICATE MILLIMETRES DECIMALIZED NUMBERS INDICATE METRES

## WARNING

IF POWER EQUIPMENT OR EXPLOSIVES ARE TO BE USED FOR EXCAVATION ON THIS PROJECT THE CONTRACTOR MUST:

- 1. NOTIFY THE GAS COMPANY OF THE PROPOSED LOCATION OF EXCAVATION.
- 2. TAKE PRECAUTION TO AVOID DAMAGE TO GAS COMPANY INSTALLATIONS SEE PROVINCIAL REGULATION 210/72 FOR DETAILS.
- 3. OBTAIN EXCAVATION PERMITS PRIOR TO CONSTRUCTION.

# 

Certificate of Authorization
Dillon Consulting Limited (MB)
No. 1789 Date: 18/02/01

CNOINEER 4801	Winnipeg THE CITY OF WINNIPEG											
	FERMOR AVENUE BRIDGE OVER SEINE RIVER	CITY DRAWING NUMBER P-3489-2017-CU-007										
NH-	BRIDGE REHABILITATION, PEDESTRIAN-CYCLIST UNDERPASS STRUCTURE AND ROADWORKS FROM ST. ANNE'S ROAD TO ARCHIBALD STREET	sheet of 007 11										
T NUMBER	ST. ANNE'S - STA. 0+950 TO STA. 1+200 (PROFILE)	CONSULTANT DRAWING NUMBER										
2												