PLUM	IBING FIX	TURE SCHE	DULE										
TAG TYPE		FIXTURE				ACCESSORY				ACCESSORY		NOTES	
WC-1	FLUSH VALVE TOILET	ACORN	'DURA-WARE' 2100-W-1-HPS-BCN	WALL	BARRIER FREE	CONCEALED FLUSHOMETER	MANUFACTURER	'REGAL XL OPTIMA' 153-1.6 ES-S,	TYPE  TRANSFORMER  CARRIER  COUPLING	SLOAN WATTS MIFAB	EL-342 ISCA-101-M11 MI-HUB TR-440	TOILET: BLOWOUT JET, OFF FLOOR, WALL THICKNESS 190MM BLOCK, WALL (CONCEALED), OFF-FLOOR, WALL OUTLET, 1.6 GPF, HIGH POLISH INTEGRAL SEAT, BLIND CAP NUTS (3). FLUSHOMETER: FOR TOP SPUD TOILET, QUIET ACTION DIAPHRAGM TYPE, INFRARED SENSOR, SOLENOID OPERATED FLUSH CONTROLLER CIRCUITRY, COURTESY FLUSH ELECTRONIC OVER—RIDE BUTTON, BAK—CHEK ANGLE STOP, EXPOSED CP ELBOW FOR TOP SPUD CONNECTION, VACUUM BREAKER, SENSOR LOCATED ABOVE THE TOILET, 5 VA POWER REQUIRED PER UNIT. OFFSET P—TRAP WITH INSULATION COVERING. WATTS FLOW STOPPER. PROVIDE 4" (102 MM) SQUARE ELECTRICAL BOX FOR MOUNTING SENSOR PLATE. TRANSFORMER: 240/24 50 VA. CARRIER: SINGLE HORIZONTAL ADJUSTABLE, MOUNTED ON CONCRETE FLOOR, ALL EPOXY COATED CAST IRON FITTING, ADJUSTABLE ABS SLIDE NIPPLE WITH INTEGRAL TEST CAP AND NEOPRENE BOWL GASKET, WASTED PLATED HARDWARE, CHROME CAP NUTS, TILING FRAME, 4) NO HUB WASTE, 2" NO HUB VENT, 350 LBS STATIC LOAD. 12" FINISHED METAL STUD WALL TO BACK OF PIPE SPACE. COUPLING: NO—HUB, TYPE 300 AISI STAINLESS STEEL BAND, TYPE 300 AISI STAINLESS STEEL EYELETS, ELASTOMERIC COMPOUND GASKET MEETING THE REQUIREMENTS OF ASTM C—564, TYPE 300 AISI STAINLESS STEEL SHIELD, TESTED TO MAINTAIN 4.3 PSI OF WATER PRESSURE AT 60 INCH LB MIN/MAX TORQUE BOLT TIGHTNESS, TESTED AND CERTIFIED TO ASTM STANDARD 1460—2012 AND CSA STANDAD B602—2010 AND LISTED WITH IAPMO. ALL MODELS ARE LISTED TO THE NATIONAL PLUMBING CODE OF CANADA AND RELEVANT CANADIAN STANDARD 1460—2012 AND CSA STANDAD B602—2010 AND LISTED WITH IAPMO. ALL MODELS ARE LISTED TO THE NATIONAL PLUMBING CODE OF CANADA AND RELEVANT CANADIAN STANDARD (S) AND BEAR THE CUPC MARK OF CONFORMITY. NON CONSTANT TEMPERATURE RATING IS 140°F. PROVIDE WITH BACK REST (NOT INCLUDED) TO MEET CITY OF WINNIPEG REQUIREMENTS.	
WC-2	FLUSH TANK TOILET	AMERICAN STANDARD	'CADET' #2467016.020	FLOOR	YES	TOILET SUPPLY	MCGUIRE	LFH172BV	SEAT	CENTOCO	500STSCC.001	TOILET: FLOOR MOUNTED TANK TYPE TOILET, VITREOUS CHINA, TANK TYPE 'CADET RIGHT HEIGHT PRESSURE—ASSISTED ELONGATED', 419 MM HIGH TOILET, 3483.001, 4142.016, VITREOUS CHINA, FLOOR MOUNTED, 1.6 US GAL PER FLUSH, TWO PIECE, ELONGATED BOWL, SIPHON JET FLUSH ACTION, RAISED SANITARY BAR. PROVIDE FLOOR FLANGE, (SAME MATERIAL AS THE CONNECTING PIPE DRAIN), WITH ALL BRASS BOLTS AND WITH RUBBER GASKET. PROVIDE BOLTED TANK COVER IF REQUIRED — TO MEET LOCAL CODES. SEAT: HEAVY DUTY TOILET SEAT, SOLID PLASTIC, OPEN FRONT LESS COVER. SUPPLY: POLISHED BRASS TOILET SUPPLY.	
L-1	LAVATORY	ACORN	'MERIDIAN' 3701-1-SO-DMJ-PDM	WALL	YES	INTEGRAL FAUCET		_	MIX VALVE GRID DRAIN SUPPLIES P—TRAP WALL CARR.	LAWLER MCGUIRE MCGUIRE MCGUIRE WATTS	TMM-1070 155A LFH165LKN3 8872C CA-321	LAVATORY: STAINLESS STEEL CURVED FRONT UNI—BASIN LAVATORY, OFF—FLOOR, WALL OUTLET, SENSOR OPERATION, DECK MOUNTED SPOUTS, DECK MOUNTED J SPOUT, METERING LIQUID SOAP DISPENSER.  MIXING VALVE: BELOW DECK MECHANICAL WATER MIXING VALVE, BRONZE BODY, TEMPERATURE ADJUSTING DIAL, 3/8" INLETS AND OUTLET COMPRESSION FITTINGS, HIGH TEMPERATURE THERMOSTATIC LIMIT STOP, SHUT—OFF WITH AUTOMATIC RESET WHEN TEMPERATURE EXCEEDS 120 °F, INTEGRAL CHECKS, OFFER TEMPERATURE RANGE FROM FULL COLD THROUGH 114.8 °F. PROVIDE TEE, ADAPTORS AND FLEX. COPPER TUBING TO SUIT INSTALLATION.  DRAIN: CAST BRASS ONE PIECE TOP, 17 GA. TUBULAR 1—1/4" TAILPIECE. SUPPLIES: CHROME PLATED FINISH POLISHED BRASS, HEAVY DUTY ANGLE STOPS, 10 MM (3/8") I.P.S. INLET X 76 MM (3") LONG RIGID HORIZONTAL NIPPLES, V.P. LOOSE KEYS, ESCUTCHEON AND FLEXIBLE COPPER RISERS.  P—TRAP: HEAVY CAST BRASS ADJUSTABLE BODY, WITH SLIP NUT, 1—1/4" SIZE, SHALLOW WALL FLANGE AND SEAMLESS TUBULAR WALL BEND.  CARRIER: MOUNTED ON CONCRETE FLOOR, EPOXY COATED TOP AND BOTTOM UNIVERSAL STEEL HANGER PLATES, HEAVY GAUGE EPOXY COATED STEEL OFFSET UPRIGHTS WITH WELDED FEET SUPPORTS. 4" FINISHED METAL STUD WALL TO BACK OF PIPE SPACE.	
L-2	LAVATORY	AMERICAN STANDARD	'MURRO' 0954.004EC.020 0059.020EC.020	WALL	YES	SINGLE HANDLE FAUCET	AMERICAN STANDARD	'SERIN' #2064LDH.101.002 2064.101P	MIX VALVE GRID DRAIN SUPPLIES P-TRAP WALL CARR.	LAWLER MCGUIRE MCGUIRE MCGUIRE WATTS	TMM-1070 155A LFH170BVRB 8872C WCA-411-CA-481	LAVATORY: WALL HUNG BASIN, WHITE FINISH. PROVIDE TEE, ADAPTORS AND FLEX. COPPER TUBING TO SUIT INSTALLATION. PROVIDE TEMPERED WATER TO HOT SIDE OF FAUCET. FAUCET: SINGLE HANDLE FAUCET. MIXING VALVE: BELOW DECK MECHANICAL, INTEGRAL CHECKS. DRAIN: OPEN GRID DRAIN. SUPPLIES: POLISHED BRASS FAUCET SUPPLIES. P-TRAP: MCGUIRE WALL CARRIER: BASIN CARRIER.	
WH-1	WALL HYDRANT	WATTS	HY-430	WALL	_	-	-	-	-	-	-	WALL HYDRANT, MODERATE CLIMATE 3/4" (19MM) WITH INTEGRAL VACUUM BREAKER CHROME PLATED HYDRANT FACE, INTEGRAL VACUUM BREAKER, GALVANIZED WALL CASING, ALL BRONZE HEAD AND HYDRANT KEY. LENGTH TO SUIT WALL THICKNESS.	
FD-1	FLOOR DRAIN	WATTS (OR EQUAL)	FD-100-C-A	FLOOR	-	-	-	-	-	-	-	FLOOR DRAIN, EPOXY COATED CAST IRON, WITH ANCHOR FLANGE, REVERSIBLE MEMBRANE CLAMP WITH PRIMARY AND SECONDARY WEEPHOLES, ADJUSTABLE NICKEL BRONZE STRAINER, NO HUB OUTLET. PROVIDE WITH WADE MODEL #4405 TRAP SEAL DEVICE (OR EQUAL), REGULARLY FURNISHED: ELASTOMERIC TRAP SEAL DEVICE WITH FITTING.	
MS-1	FLOOR DRAIN	STERN WILLIAMS	#MTB-2424	FLOOR	_	TWO HANDLE	AMERICAN STANDARD	#8350.243	WALL HOOK HANGER	STERN WILLIAMS STERN WILLIAMS	T-35 T-40	SQUARE SERVICE / MOP SINK, 610 MM (24") X 610 MM (24") X 254 MM (10") DEEP, FLOOR MOUNTED, TERRAZZO COMPOSED OF PEARL GRAY MARBLE CHIPS AND PORTLAND CEMENT GROUND SMOOTH, SEALED TO RESIST STAIN, CAST BRASS DRAIN WITH STAINLESS STEEL STRAINER, 3"(75MM) OUTLET. WALL MOUNTED TWO HANDLE FAUCET, CHROME PLATED, 8" (203MM) CENTERSET, CAST BRASS BODY, SLOW COMPRESSION, UNRESTRICTED HOSE END OUTLET, SPOUT WITH ATMOSPHERIC VACUUM BREAKER AND BUCKET HOOK 173 MM (7-1/4") FROM WALL TO OUTLET REACH, LEVER HANDLES. HOSE AND WALL HOOK HOSE 36" (914MM) LONG WITH 3/4" (19MM) CHROME COUPLING, STAINLESS STEEL WALL BRACKET. MOP HANGER STAINLESS STEEL #4 FINISH, 24" (610MM) LONG WITH 3 RUBBER SPRING LOADED CLIPS. STERN WILLIAMS BP BACK SPLASH PANEL 20 GAUGE TYPE 304 STAINLESS STEEL. PROVIDE P-TRAP, SAME MATERIAL AS THE CONNECTING PIPE DRAIN.	
СО	CLEAN-OUTS	WATTS (OR EQUAL)	CO SERIES	-	_	-	-	-	-	-	-	CLEAN OUT: DUCO COATED, CAST IRON BODY, AND REMOVABLE POSITIVE GASKET SEAL CLOSURE PLUG AND HEAVY DUTY 6" (150MM) ROUND ADJUSTABLE COVER	
_	WATER HAMMER ARRESTORS	WATTS (OR EQUAL)	LF SERIES	-	_	-	-	_	-	-	_	WATER HAMMER ARRESTORS: LEAD-FREE, STAINLESS STEEL, PRESSURIZED CHAMBERS, BELLOWS, SIZE ACCORDING TO MANUFACTURER'S RECOMMENDATIONS CHART TO ELIMINATE WATER HAMMER AND SHOCK FROM PIPING SYSTEM. PROVIDE WATER HAMMER ARRESTORS ON HOT AND COLD WATER SUPPLIES TO ALL QUICK VALVES, SOLENOIDS, AND PLUMBING FIXTURES, AND LOCATE IN AN UPRIGHT POSITION BETWEEN THE LAST TWO FIXTURES ON A LINE, OR HORIZONTALLY AT THE END OF LINE CLOSEST TO SUPPLY SOURCE.	

LEGEND - PLU	JMBING
	SANITARY LINE ABOVE FLOOR/GRADE
	SANITARY LINE BELOW FLOOR/GRADE
	VENT LINE
	VENT LINE INSULATION
	PUMPED DISCHARGE LINE
	GAS LINE
	DOMESTIC COLD WATER (DCW)
	DOMESTIC HOT WATER (DHW)
	HOT WATER RECIRCULATION (DHWR)
<u>—</u> I	CLEANOUT
0	FLOOR / HUB DRAIN
	PUMP
	SHUT-OFF VALVE
——IOI——	BALL VALVE
N	CHECK VALVE
——I <u>↓</u>	MANUAL BALANCING VALVE
	UNION
	PRESSURE REDUCING VALVE
<del></del>	STRAINER
	PIPE ANCHOR
ф⊸	WALL HYDRANT
9	PRESSURE GAUGE
	THERMOMETER
<del></del>	DIRECTION OF FLOW

LEGEND - HV	AC
	SUPPLY AIR DIFFUSER
	RETURN AIR GRILLE
	EXHAUST AIR GRILLE
+	DOOR GRILLE
T	THERMOSTAT
H	HUMIDISTAT
(0)	CARBON DIOXIDE DETECTOR
\$	ON / OFF SWITCH (BY ELECTRICAL)
E = = 3	DUCTWORK LOCATED IN FLOOR
	BALANCING DAMPER
§ FD	FIRE DAMPER
§ BDD	BACK DRAFT DAMPER
<b>S S</b>	MOTORIZED DAMPER
	FLEXIBLE DUCT CONNECTION
8/////	THERMAL INSULATION
<b>\$</b>	ACOUSTIC INSULATION
TYPE SIZE CFM NECKØ	GRILLE / DIFFUSER TAG
EQ NO	EQUIPMENT TAG
TYPE SIZE OUTPUT	ALTERNATE EQUIPMENT TAG
	DRAWING NOTE TAG

NOVA 3 ENGINEERING LTD.
PROFESSIONAL ENGINEERS

201–120 FORT STREET TEL.: (204) 943–6142
WINNIPEG, MANITOBA R3C 1C7 FAX.: (204) 942–1276
WWW.NOVA3.CA JN.: 41–139
THIS DRAWING IS THE EXCLUSIVE PROPERTY OF NOVA 3 ENGINEERING LTD.
AND MAY ONLY BE REPRODUCED WITH THE WRITTEN PERMISSION OF NOVA 3 ENGINEERING LTD.

THE CONCEPT AND DESIGN INCORPORATED INTO THIS DRAWING ARE BASED ON INFORMATION PROVIDED BY THE CLIENT AND OTHER RELATED SOURCES. PROFESSIONAL ENGINEER ACCEPTS NO RESPONSIBILITY FOR DRAWING AND DESIGN UNLESS DRAWING IS ACCOMPANIED BY ORIGINAL SEALED LETTER OF INTENT OR EQUIVALENT ACCEPTABLE FACSIMILE. PROFESSIONAL ENGINEER ACCEPTS NO RESPONSIBILITY FOR FINAL INSTALLATION CONFORMANCE WITHOUT ORIGINAL SEALED CERTIFICATE OF INSPECTION OR EQUIVALENT ACCEPTABLE FACSIMILE.

Revisions


2021—11—12 Mechanical Equipment Equals Addendum
2021—10—20 Issued for Tender, Permit, and Construction
Date Revision

Northern Sky Architecture Inc.

100—128 James Avenue Winnipeg, Manitoba, Canada R3B 0N8 contact@nsai.ca Fax 204.956.7979



PLUMBIN	NG EQUIPME	ENT SCHEDU	JLE				
TAG	TYPE	LOCATION	MANUFACTURER	MODEL	CAPACITY	ELECTRICAL	NOTES
HWT-1 (EXISTING)	HOT WATER HEATER TANK	SUSPENDED ABOVE MOP SINK	RHEEM	PROE30 1 CN53 POU	30 USG 1.5 KW	1.5 KW 120/1/60	EXISTING HOT WATER TANK TO BE RELOCATED AS INDICATED ON DRAWINGS. PROVIDE WITH NEW DRAIN FOR T&P RELIEF DOWN TO MOP SINK.
P-1	GRINDER PUMP	EXISTING SEWAGE TANK	FRANKLIN ELECTRIC 'FPS'	IGP-A231-20 #515862 *CONFIRM MATCHES EXISTING PRIOR TO ORDERING*	20 GPM 100' HEAD *CONFIRM MATCHES EXISTING PRIOR TO ORDERING*	2 HP 240/1/60 *CONFIRM MATCHES EXISTING PRIOR TO ORDERING*	AUTOMATIC GRINDER, 20FT CORD, 1-1/4" DISCHARGE. CAST IRON WITH EPOXY COATING MOTOR COVER, NITRILE MOTOR COVER O-RING, SINGLE PHASE, CAPACITOR START, CAPACOTIR RUN MOTOR DESIGN, INTEGRAL OVERLOAD PROTECTION, SS MOTOR SHAFT, BRASS IMPELLER, 2 BLADE SS ROTATING CUTTER, SS STATIONARY CUTTER.  PROVIDE PUMP COMPLETE WITH CUSTOM ALDERON CONTROL PANEL. PROGRAM CONTROL PANEL PLC AS INACTIVE DURING SCHEDULE OCTOBER - MAY (CONFIRM EXACT DAYS WITH OWNER). PROGRAM CONTROL PANEL TO ENERGIZE PUMP EVERY 72 HOURS FOR 15 SECONDS DURING INACTIVE SCHEDULE TO EXERCISE PUMP.

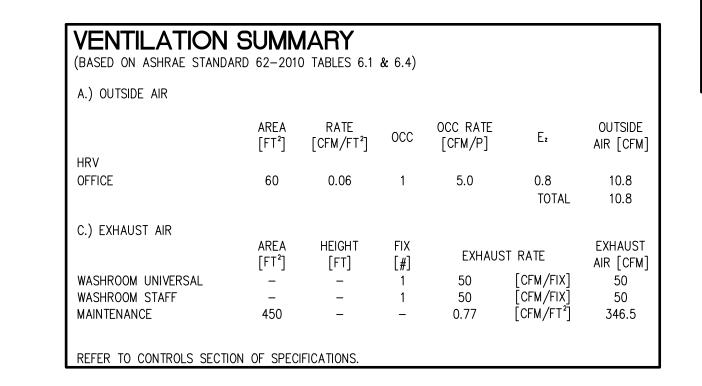



Project

City of Winnipeg Churchill Park Maintenance Building Renovation

> 430 Churchill Dr Winnipeg, Manitoba

drawing titl MECHA		HANICAL SCHEDULI
scale	as noted	designed by HC
date	2021-11-12	drawn by HC
project no.	21.190	reviewed by JHG
reference no	).	sheet MO.0