


B SIZE - 279mm x 432mm

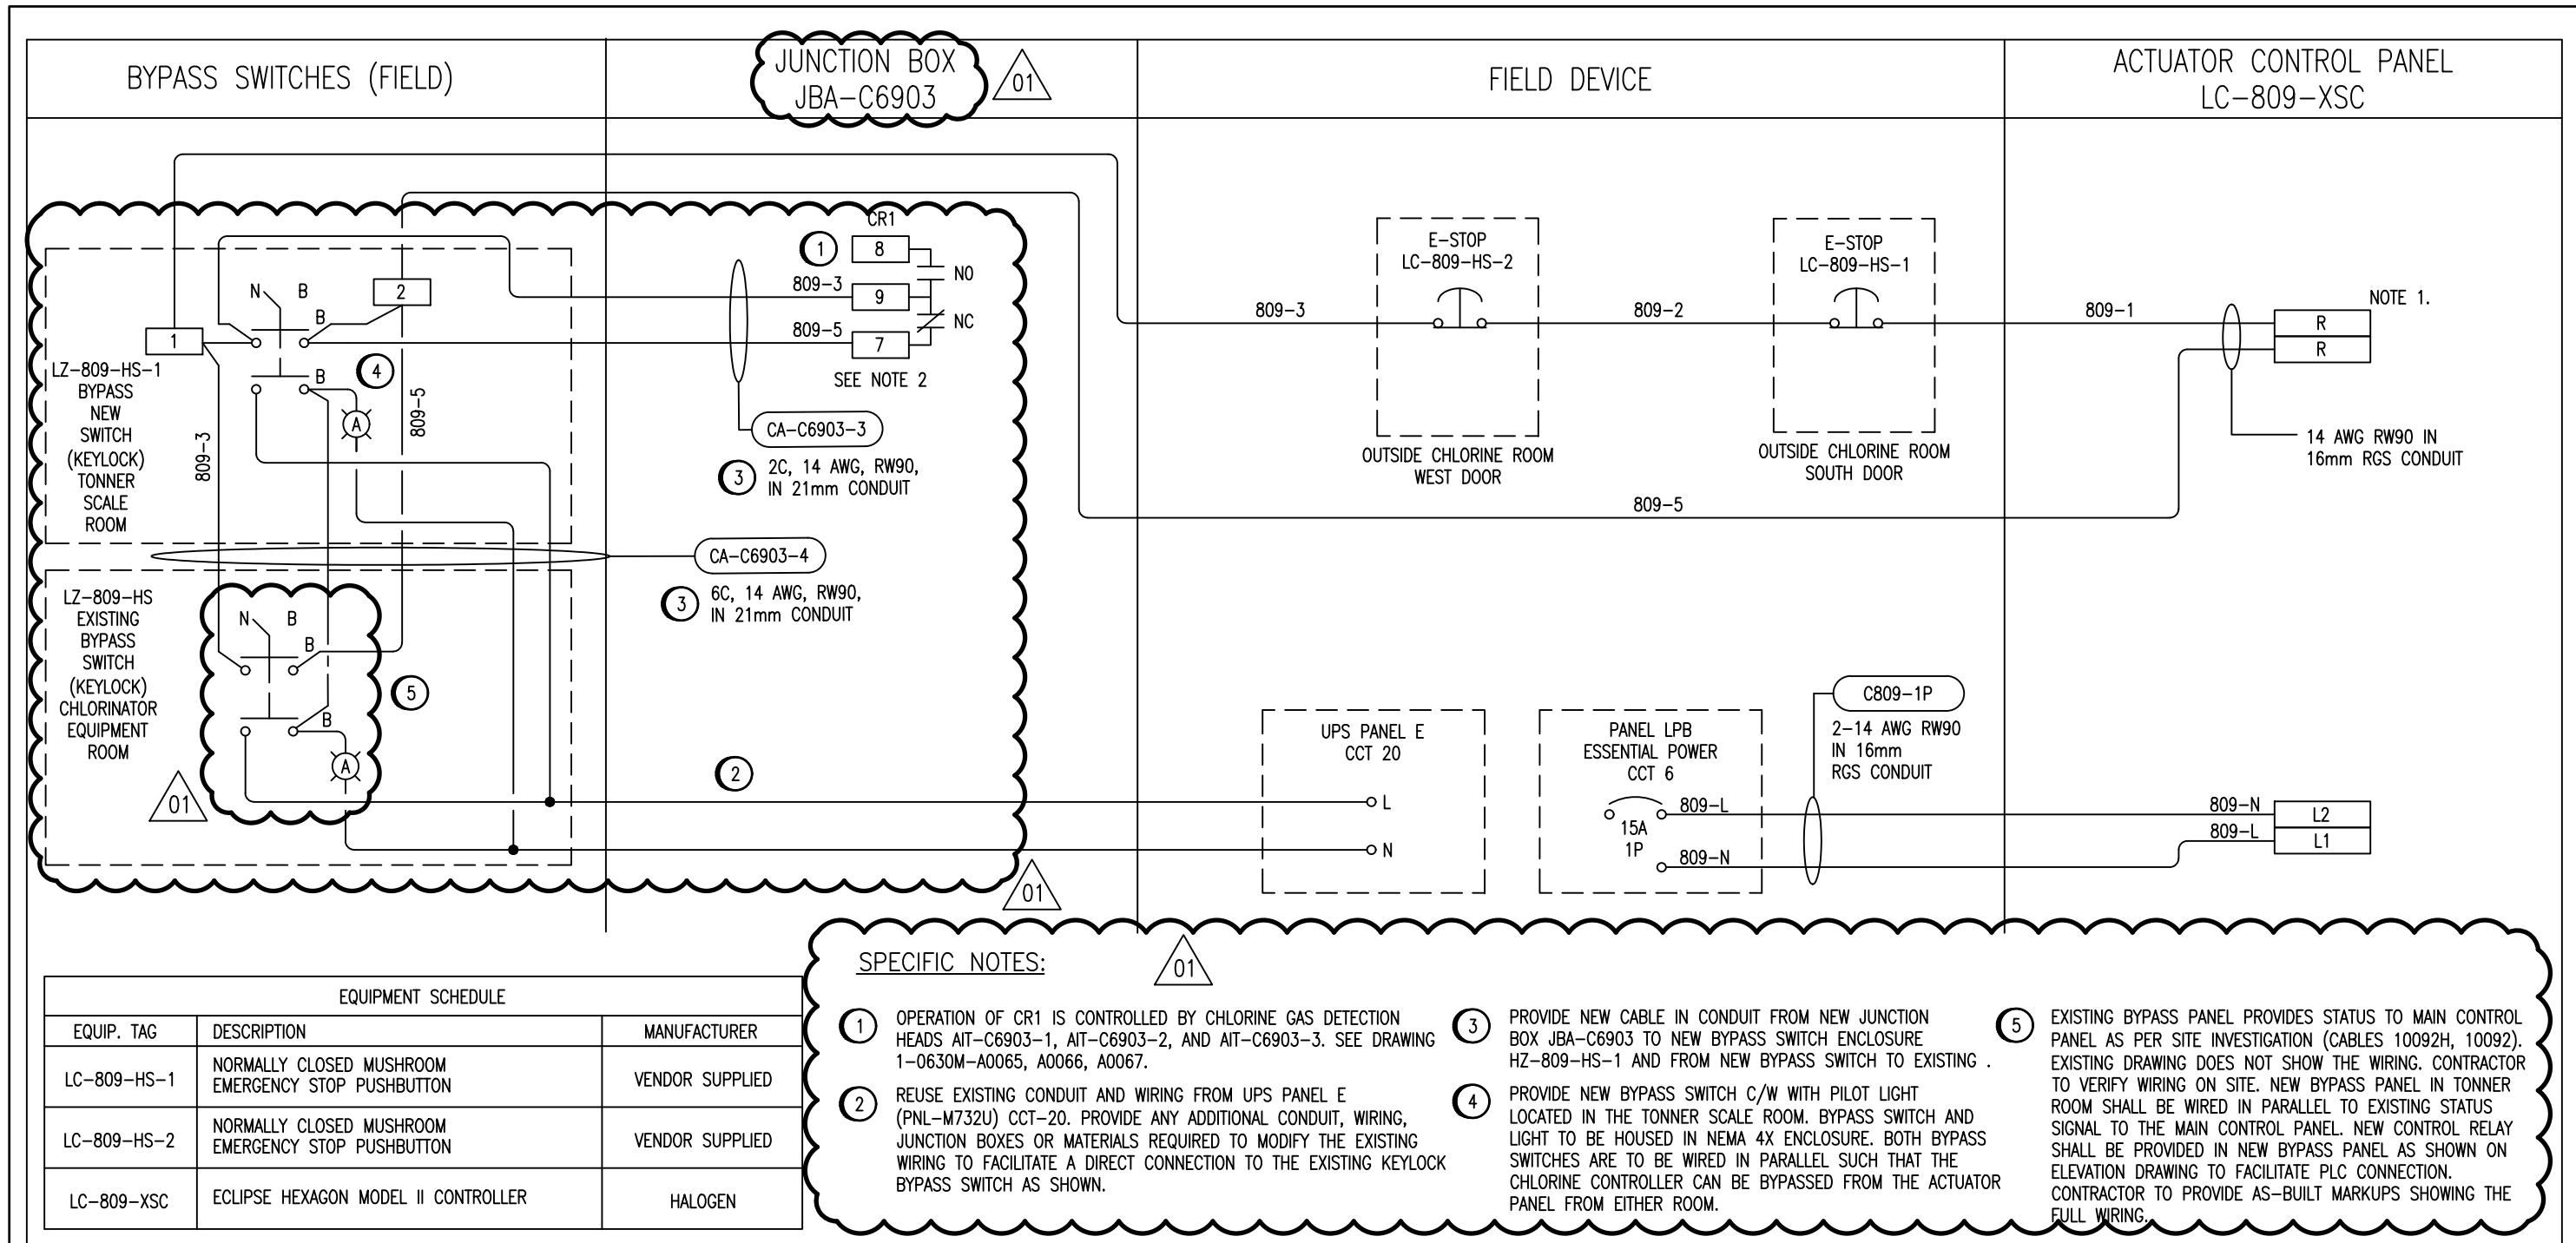

NOTES:

1. SETTED JUMPER JP2 ON ACTUATOR CONTROL PANEL LC-809-XSC TO ACCEPT 'NORMALLY CLOSED' DEVICES (JUMPER ON PINS 1 & 2).
2. ALARM CONTACTS CONFIGURED FOR FAIL-SAFE OPERATION.
3. REFER TO DRAWING 1-0630M-A0070 FOR JBA-C6903 LAYOUT DRAWING.
4. REFER TO DRAWING 1-0630M-A0073 FOR BYPASS SWITCH HZ-809-HS-1 LAYOUT DRAWING.



		AtkinsRéalis		148 Nature Park Way Winnipeg, Manitoba Canada R3P 0X7 204-786-8080		ENGINEER'S SEAL
				DESIGNED BY: D. BECKER	CHECKED BY: C.J. REIMER	
				DRAWN BY: D. BECKER	APPROVED BY: D.A. CROCKER	
				SCALE: N.T.S.	DATE: 2006/10/06	
				ISSUED FOR CONSTRUCTION BY: M. SKINNER	DATE: 2025/04/30	
01		ISSUED FOR TENDER AND CONSTRUCTION 025/04/30		VE	VE	
00		RECORD DRAWING 08/10/23		AEO		
NO.		REVISIONS	DATE	DESIGN	CHECK	
CONSULTANT NO.: 112958-0000						
CITY DRAWING NUMBER 1-0630M-A0026						
SHEET 001						
REV. 01						
SIZE B						

THE CITY OF WINNIPEG
WATER AND WASTE DEPARTMENT

MACLEAN PUMPING STATION
CHLORINE EMERGENCY ISOLATION SYSTEM
INSTRUMENT LOOP DIAGRAM
LC-809-XSC MANUAL / AUTOMATIC SHUTDOWN