


D SIZE 22" x 34" (569mm x 864mm)

UMA FILE NAME: OVERALL_RX.DWG 2004-04-23 1:27pm WJD

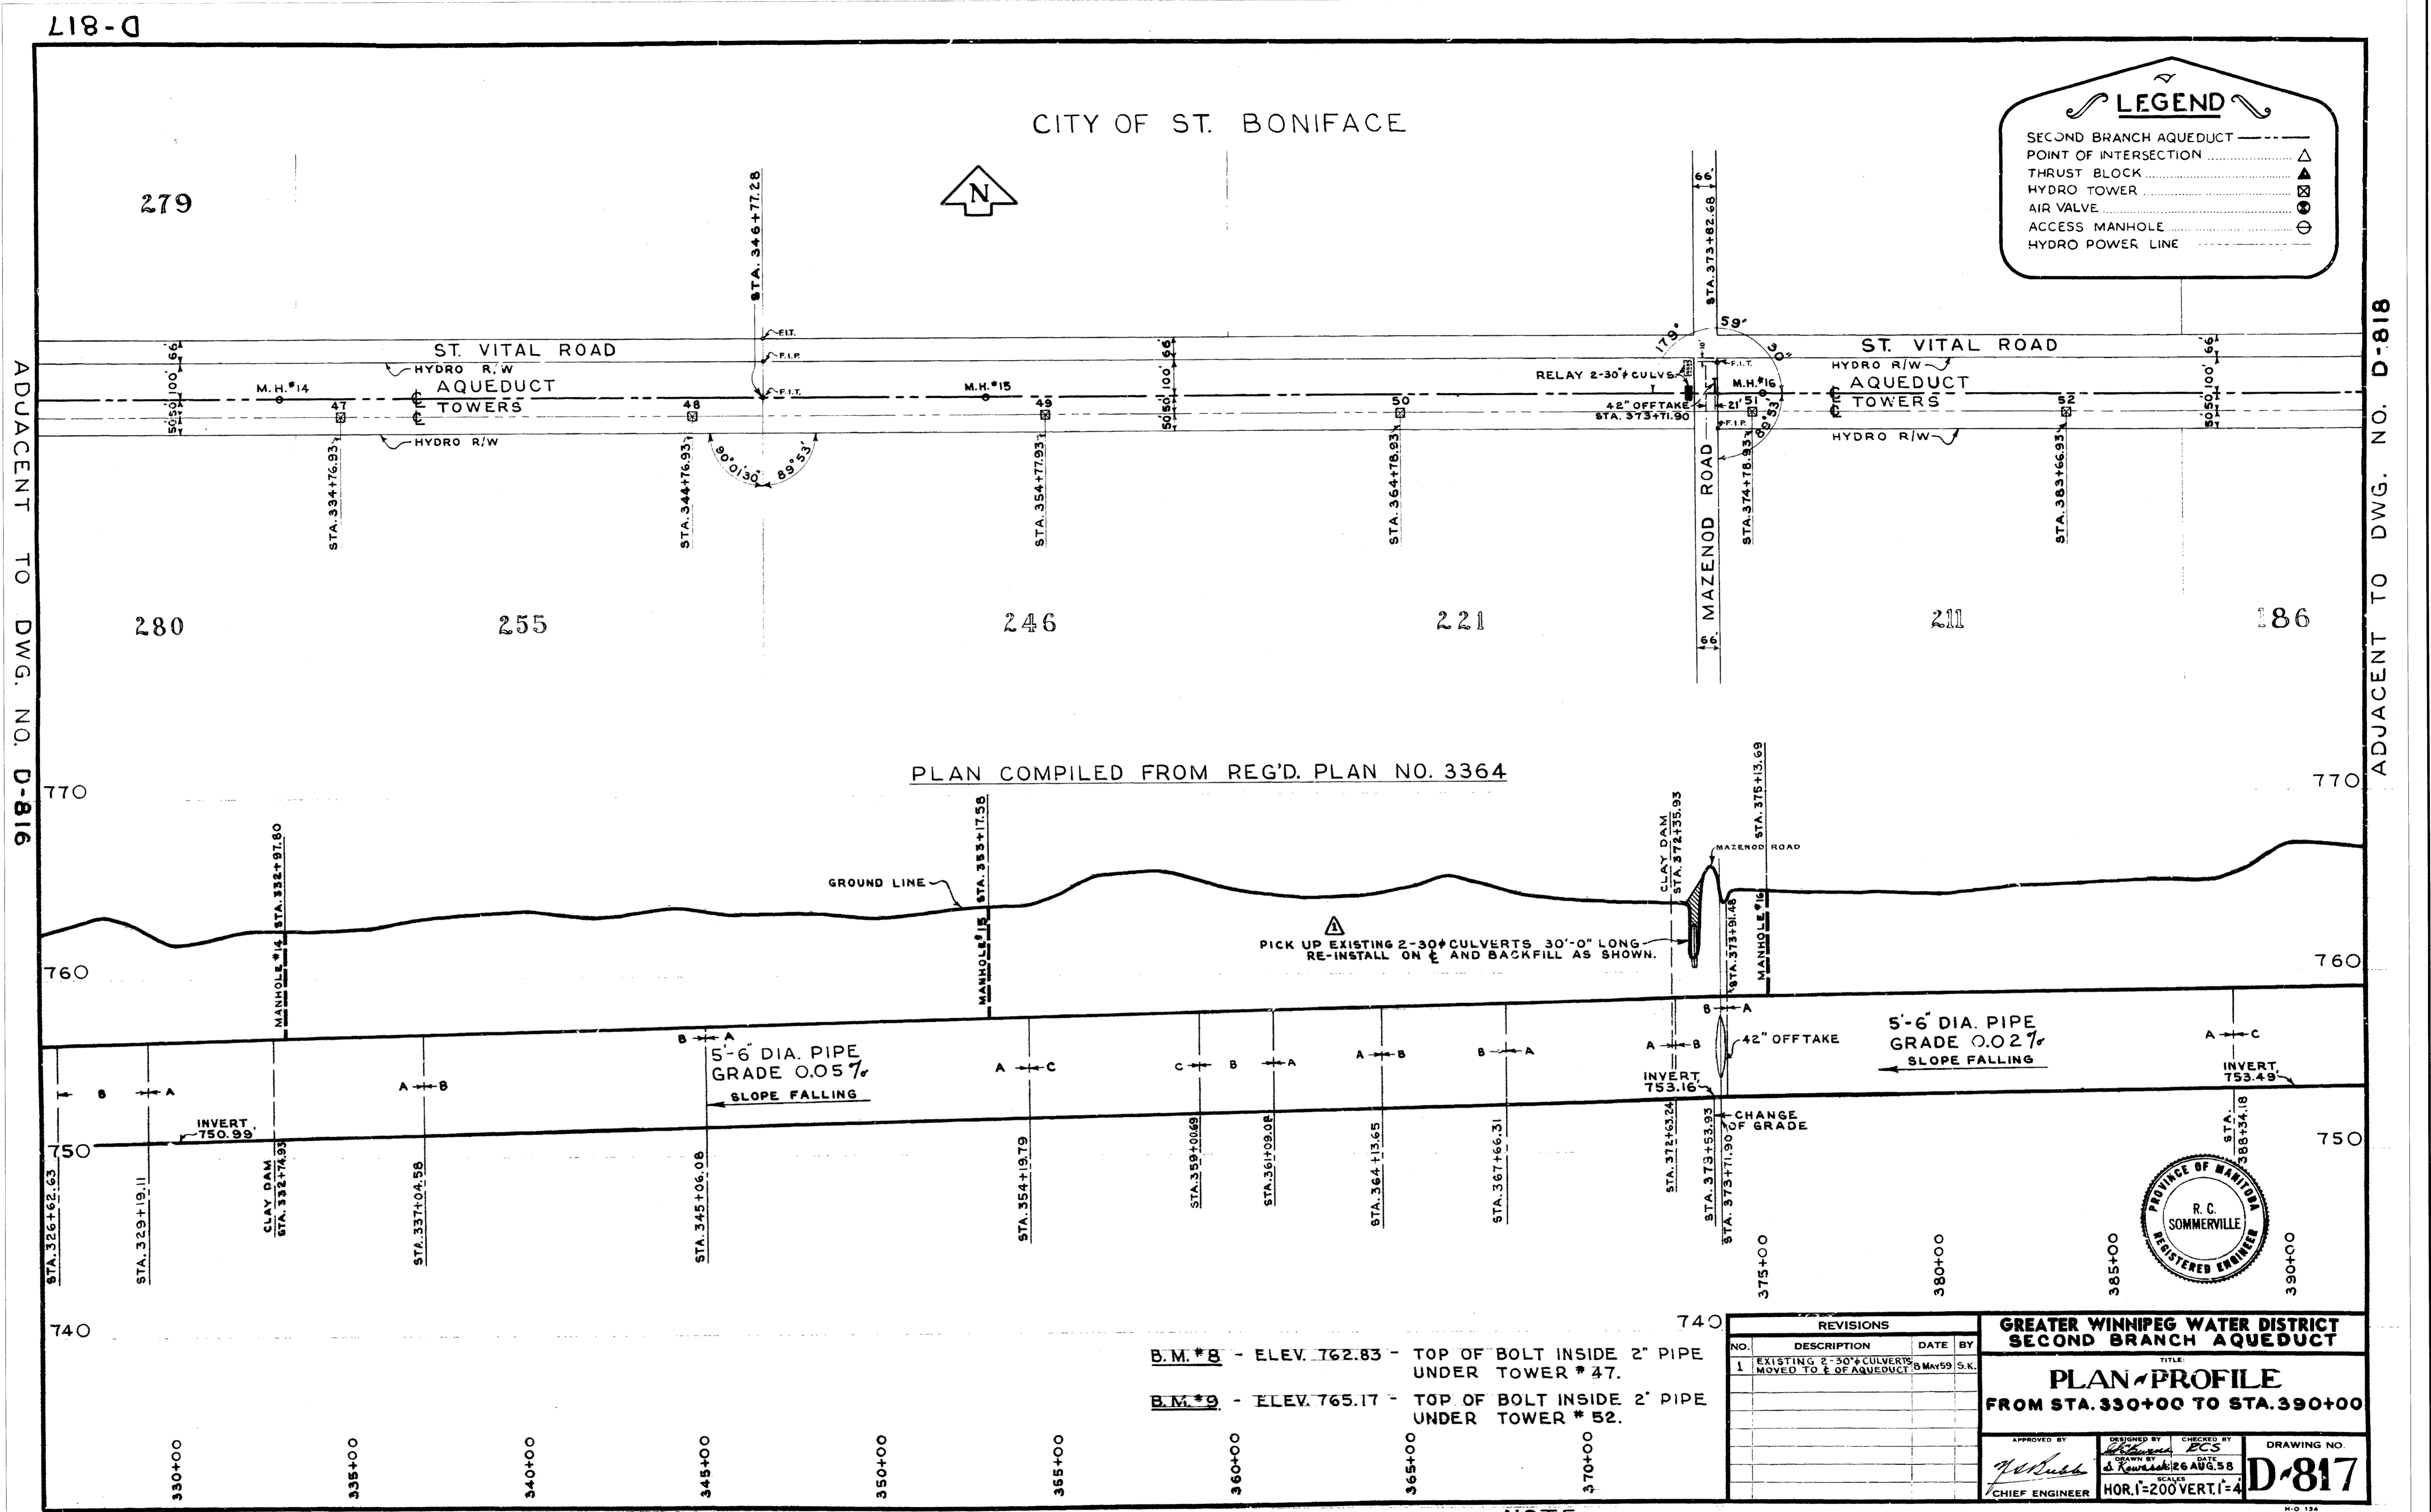

LEGEND

- SECOND BRANCH AQUEDUCT
- POINT OF INTERSECTION
- THRUST BLOCK
- HYDRO TOWER
- AIR VALVE
- ACCESS MANHOLE
- HYDRO POWER LINE

CITY OF ST. BONIFACE

PLAN COMPILED FROM REG'D. PLAN NO. 3364

B.M. #8 - ELEV. 762.83 - TOP OF BOLT INSIDE 2" PIPE UNDER TOWER # 47.

B.M. #9 - ELEV. 765.17 - TOP OF BOLT INSIDE 2" PIPE UNDER TOWER # 52.

| REVISIONS | | |
|-----------|---|---------------|
| NO. | DESCRIPTION | DATE BY |
| 1 | EXISTING 2'-30" CULVERTS MOVED TO E OF AQUEDUCT | 8 MAY 99 S.K. |

**GREATER WINNIPEG WATER DISTRICT
SECOND BRANCH AQUEDUCT**

PLAN & PROFILE
FROM STA. 330+00 TO STA. 390+00

APPROVED BY: *[Signature]* DATE: 26 NOV 99
DESIGNED BY: *[Signature]* DATE: 26 NOV 99
CHECKED BY: *[Signature]* DATE: 26 NOV 99

PROFESSIONAL ENGINEER
R.C. SOMMERVILLE
REGISTERED ENGINEER

DRAWING NO. **D-817**

NOTE: ALL CHAINAGES REVISED TO FINAL (AS CONSTRUCTED) CHAINAGES. 23 SEPT 00 - S.K.

AS CONSTRUCTED - 26 NOV 99 - S.K.

BID OPPORTUNITY 215-2004

LOCATION APPROVED UNDERGROUND STRUCTURES

SUPR. U/G STRUCTURES DATE COMMITTEE

NOTE: LOCATION OF UNDERGROUND STRUCTURES AS SHOWN ARE BASED ON THE BEST INFORMATION AVAILABLE. BUT NO GUARANTEE IS GIVEN THAT ALL EXISTING UTILITIES ARE SHOWN OR THAT THE GIVEN LOCATIONS ARE EXACT. CONFIRMATION OF EXISTENCE AND EXACT LOCATION OF ALL SERVICES MUST BE OBTAINED FROM THE INDIVIDUAL UTILITIES BEFORE PROCEEDING WITH CONSTRUCTION.

| NO. | REVISIONS | YYMMDD | BY |
|-----|-----------|--------|----|
| | | | |

uma
www.umagroup.com

2004 UMA ENGINEERING LTD. ALL RIGHTS RESERVED.

| | | | |
|-------------|-------|---------------------------|--|
| DESIGNED BY | MGM | CHECKED BY | |
| DRAWN BY | WJD | APPROVED BY | |
| HOR. SCALE | 1:500 | RELEASED FOR CONSTRUCTION | |
| VERT. SCALE | 1:50 | | |
| DATE | | DATE | |

PROFESSIONAL'S SEAL

CONSULTANT DRAWING NO. D265-182-00

THE CITY OF WINNIPEG

BRANCH II AQUEDUCT INTERCONNECTOR - VALVE CHAMBER

HISTORICAL DRAWING (FOR INFORMATION ONLY)

SHEET OF

CITY DRAWING NUMBER **D-817**

REV