

MANHOLE

30" DIA CONCRETE

TOTAL P. 02




GRADE 1
0-1

8 9 10

PLAN 2038

8

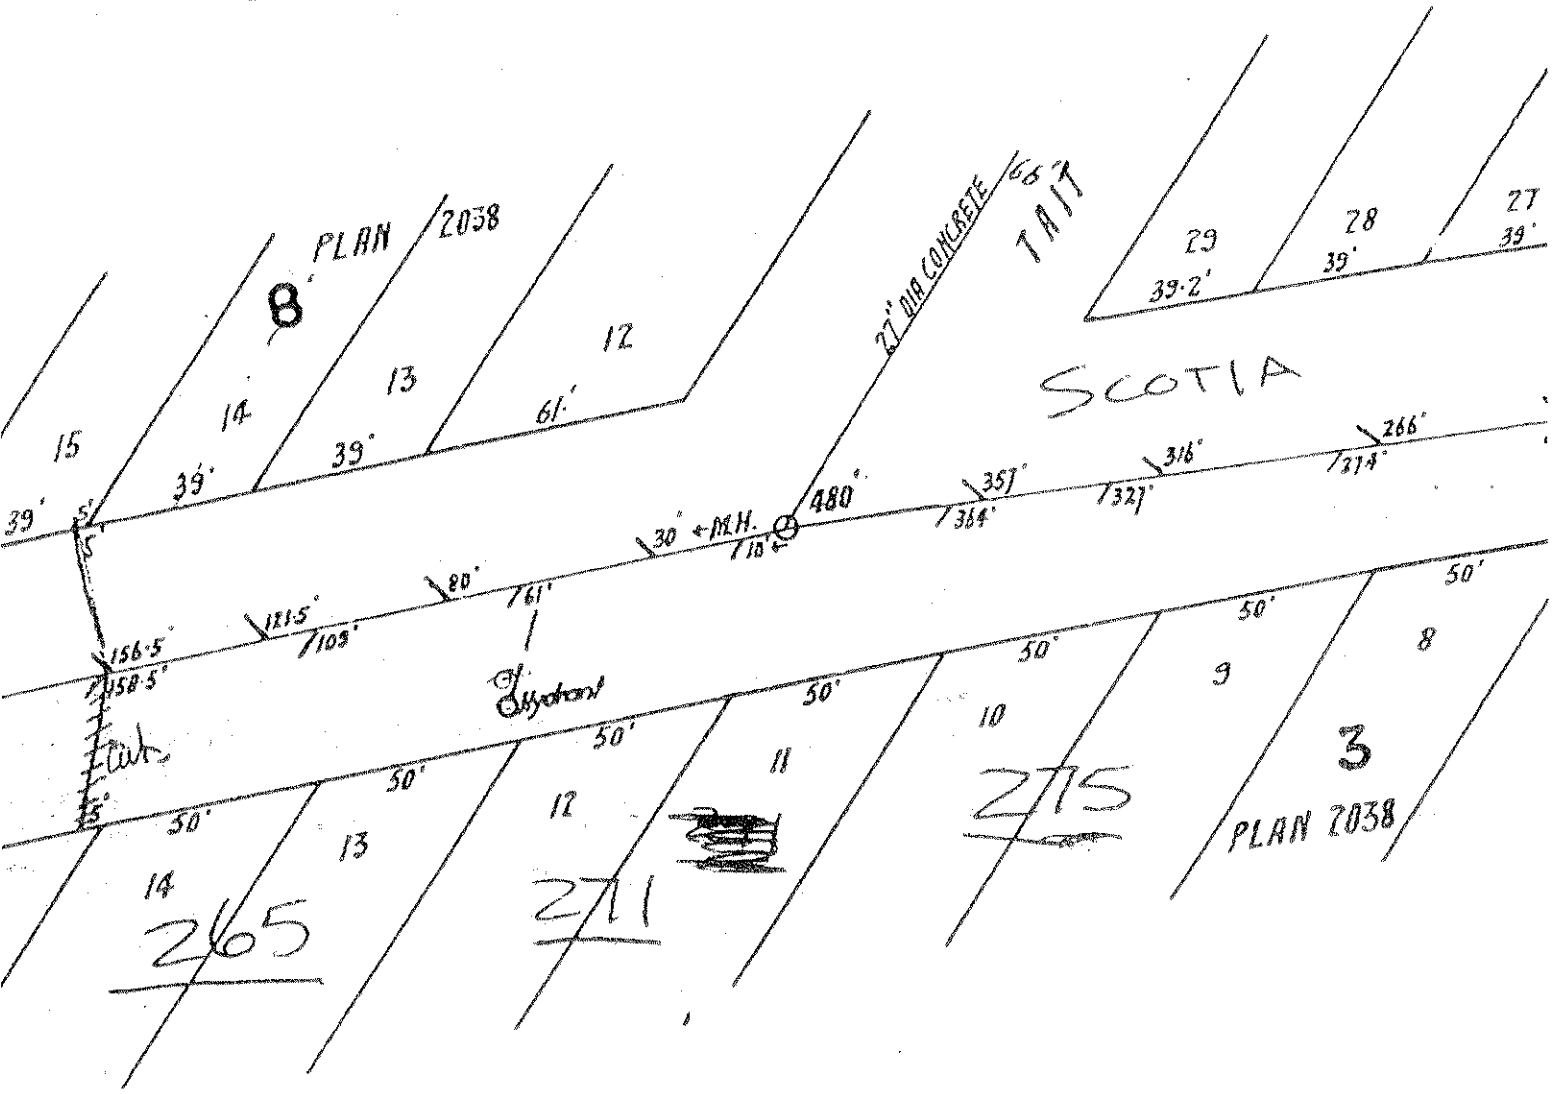

PLAN 2038

8

29

28

27

SCOTIA

39-2'

39'

39'

30" M.H.

480'

357'

327'

316'

266'

214'

121.5'

710.5'

80'

761'

156.5'

158.5'

Hydrant

50'

50'

50'

50'

265

271

275

3
PLAN 2038

14

13

12

11

10

9

8

15

14

13

12

39'

39'

39'

61'

39-2'

39'

39'

27" DIA CONCRETE
TRAIL

Flats

CITY OF WINNIPEG - ENGINEERING DEPT. - WATER WORKS OPERATING DIVISION

APPLICANT		PERMIT NO.	LOT	BLK.	PLAN.	METER NO.	SIZE	OUT	ON	OFF
			11/12	3	2030	2-2-67 1018975	5/8 in.			
NATURE OF BUILDING		NATURE OF SERVICE		DATE LAID						
House		Domestic		Jul. 27, 1942						
C. FROM STREET LINE		SIZE OF SERVICE		KIND OF PIPE						
3'6" centre		3/4"		LEAD						
LOCATION: 12'6" N.O. the Hyd. S. of Scotia & Tait										
S.C. 1 1/4' S.N.L. of House										
LOCATION: SAME AS S.C.										
LENGTH SERVICE TO ST. LINE		LENGTH PIPE INSTALLED		DISTANCE FROM MAIN TO ST. LINE						
DEPTH SERVICE AT S.C.		DEPTH SERVICE AT MAIN		AVERAGE DEPTH		DEPTH OF W.M.				
CONNECTED TO: COPPER - LEAD PIPE ON PROPERTY IN SEWER TRENCH										
SERIAL: 3/4		CORP. COCK		3/4 STOP COCK						
C TO		L ADAPTORS		L - S: SING - DBL: BOX, BLK. DBL. NEW TYPE						
L TO		C ADAPTORS		L - S: SING - DBL: BOX, BLK. DBL. OLD TYPE						
C TO		C ADAPTORS		COPPER PIPE			FT.			
COUPLINGS		LEAD PIPE		3/4			LBS.			
REMARKS: LEAD										
SKETCH: YES		NO		PAVED		GRADED		UNGRADED		
NUMBER		STREET		SERVICE NO.		SIGNAL		METER TEST		
671		Scotia Street				BOX LOW'D W. ON		1 2 3 4 5 6 7 8 9 0		

265 SCOTIA ST
SEWER 26' S of N/L
OF HOUSE.

221-18 FT S of T
N/L of HOUSE.

HUB-T-2004 11.4.5
 LUGL WHICK & SEWER TEND
 2004 300 (0) 0
 F. 02/02

Post-it™ Fax Note	7671E	Date	# of pages
To	JEFF TALON	From	552 PULQUET
Co/Dept		Co.	
Phone #	UMA	Phone #	996-7619
Fax #		Fax #	

CITY OF WINNIPEG - ENGINEERING DEPT. - WATER WORKS OPERATING DIVISION										
APPLICANT		PERMIT NO.	LGT	BLK.	PLAN.	METER NO.	SIZE	OUT	ON	OFF
HOUSE			?	3	2034	30-8-58	5/8	130		
NATURE OF BUILDING		NATURE OF SERVICE		DATE LAID		10000000	1/2	75		
S.C. FROM STREET LINE		SIZE OF SERVICE		KIND OF PIPE		31-7-75	3/8			
34' centre		1 1/2"		LEAD		21371369	7/8			
POSITION F.S.C.		POSITION F.S.C.		POSITION F.S.C.						
165' N. of the Hyd. S. of Scotia & Tait		2'6" N.S.L. of House		SAME AS S/C						
LENGTH SERVICE TO ST. LINE		LENGTH PIPE INSTALLED		DISTANCE FROM MAIN TO ST. LINE						
DEPTH SERVICE AT S.C.		DEPTH SERVICE AT MAIN		AVERAGE DEPTH						
CONNECTED TO:		COPPER - LEAD PIPE ON PROPERTY IN SEWER TRENCH		STOP COCK						
MATERIAL:		CORP. COCK		L - S: SING - DBL: BOX, BLK, BBL, NEW TYPE						
C TO		L ADAPTORS		L - S: SING - DBL: BOX, BLK, BBL, OLD TYPE						
L TO		C ADAPTORS		COPPER PIPE						
C TO		C ADAPTORS		LEAD PIPE 1 1/2"						
COUPLINGS				FT.						
				LBS.						
REMARKS:										
SKETCH: YES		NO		PAVED		GRADED		UNGRADED		
NUMBER		STREET		SERVICE NO.		SIGNAL		METER TEST		
275		SCOTIA STREET				BOX LOW'D W. ON		1 2 3 4 5 6 7 8 9 0		

JEFF TALON
265-361-01

WATER SERVICE ONLY FOR 275