


REF. or DRAWING No. **SEP 424**
DETAILS *file # SU10231*

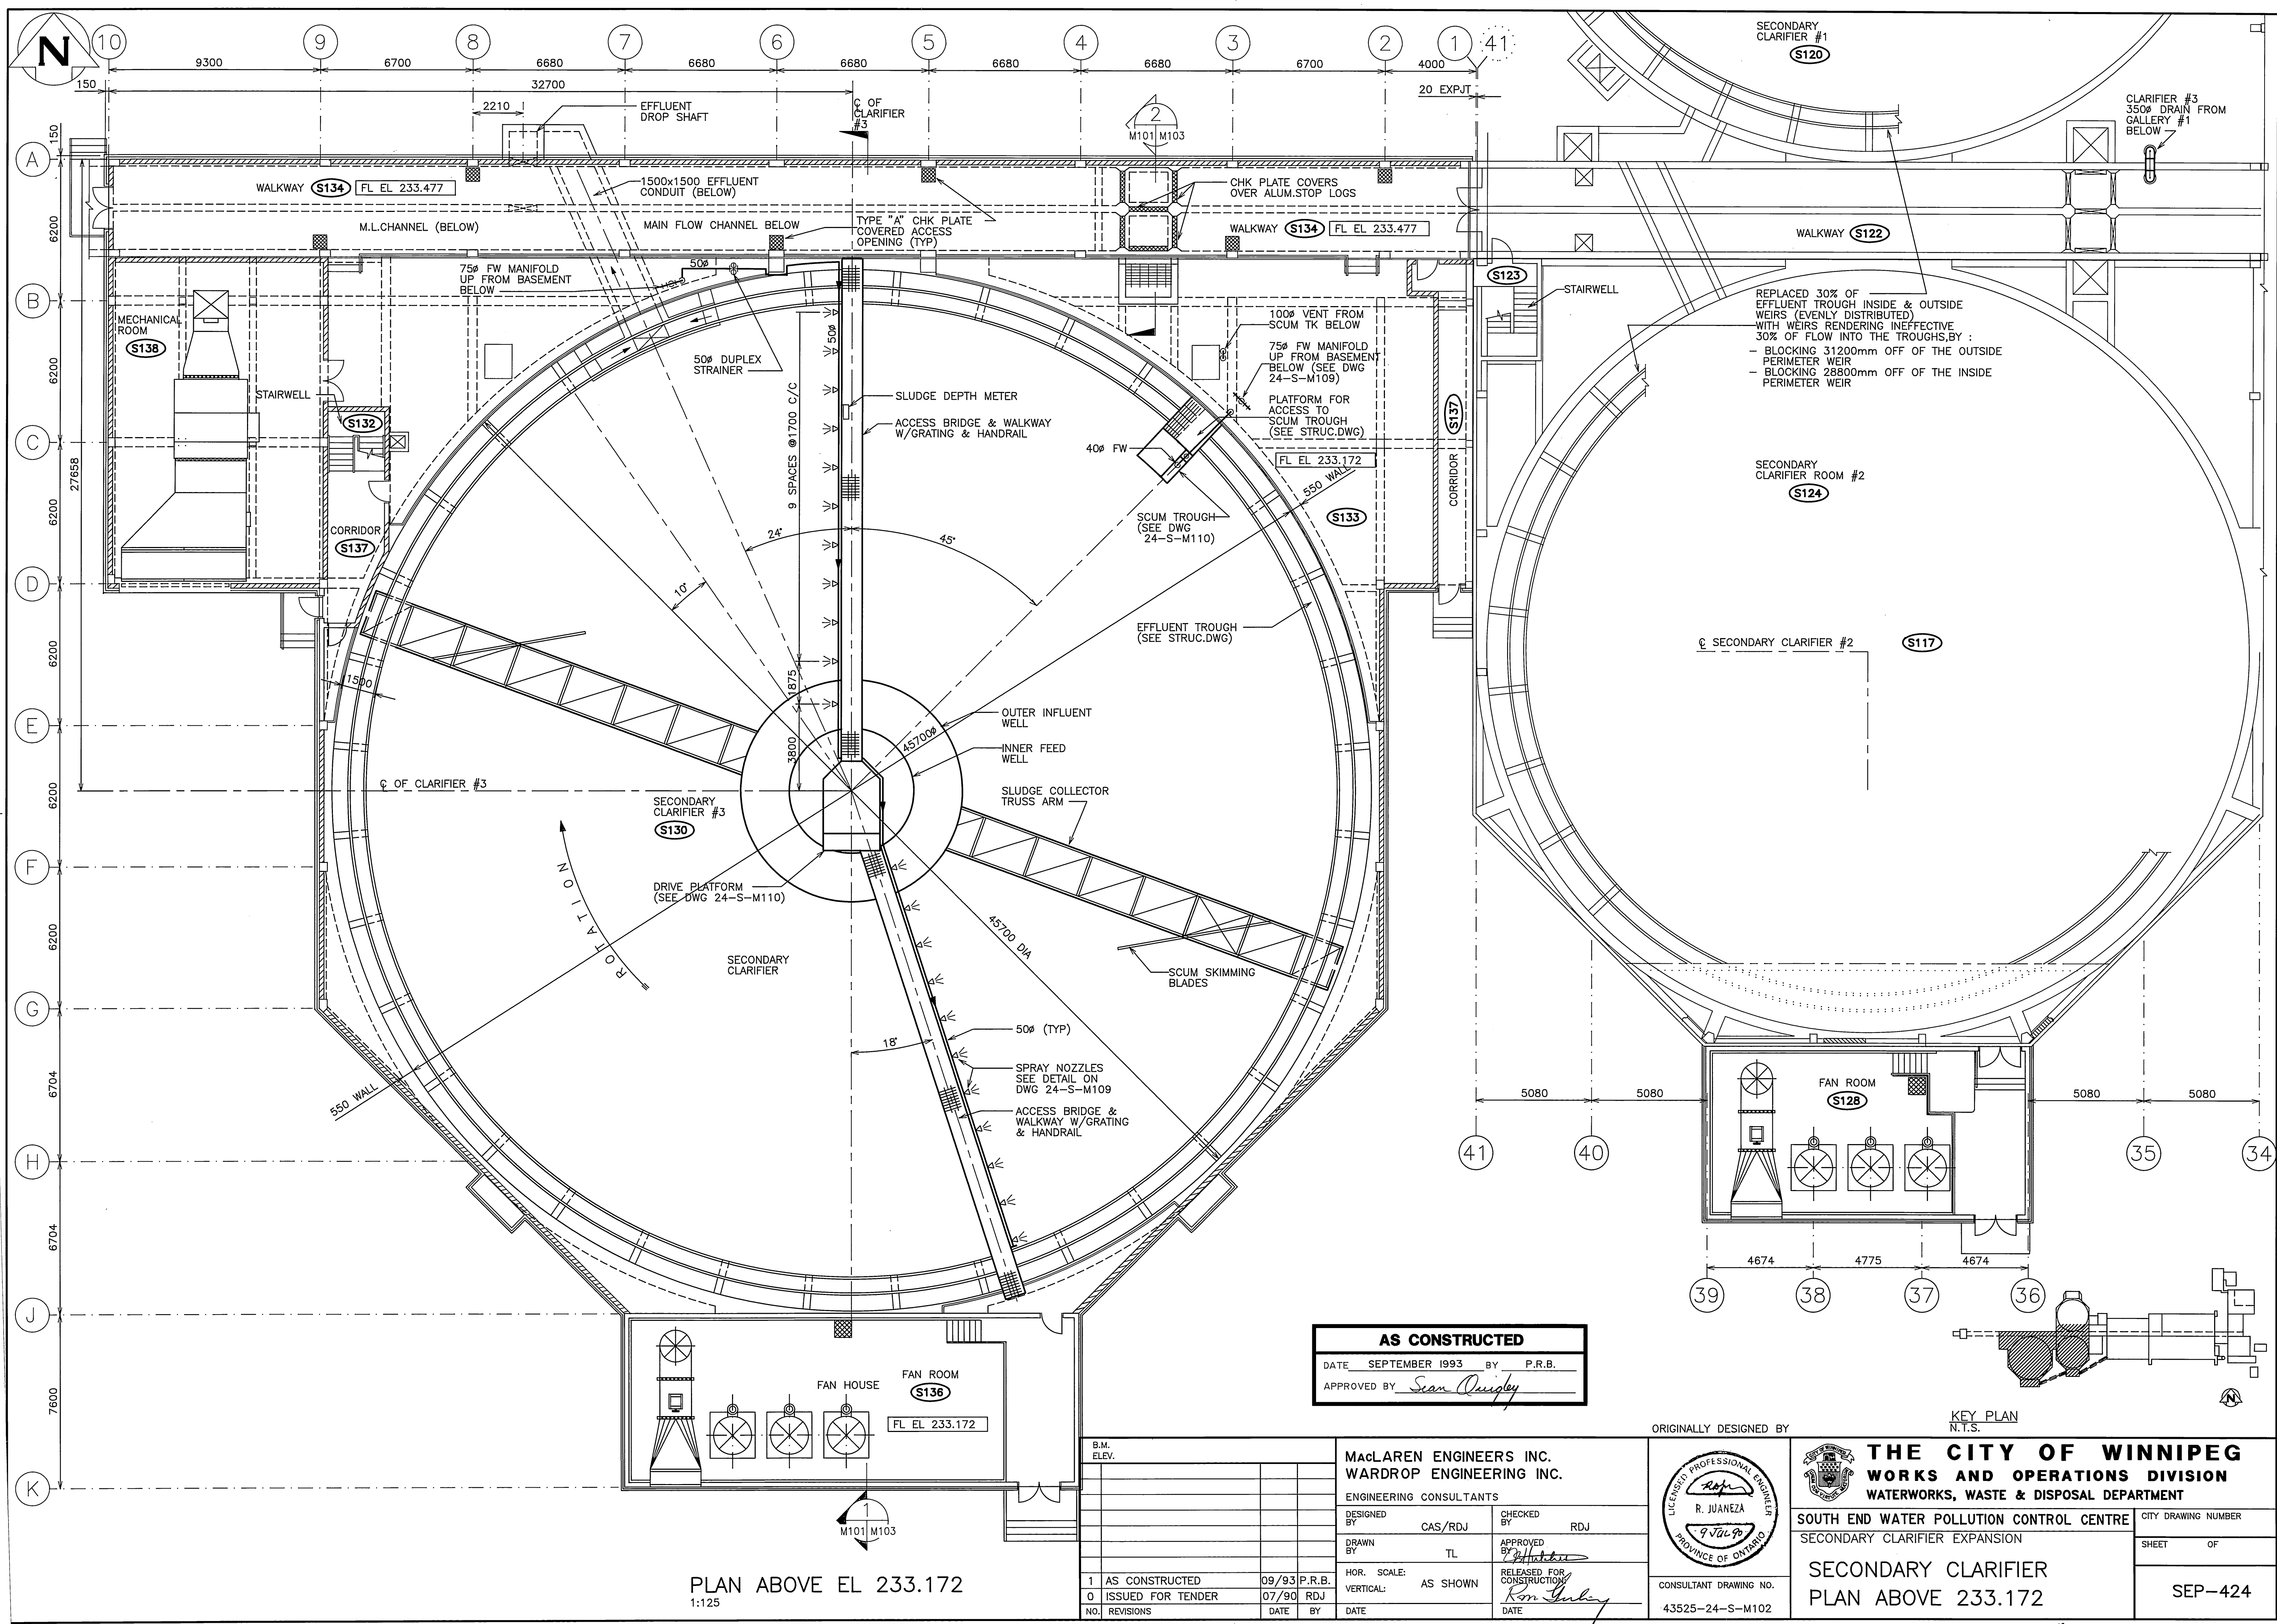

PLAN ABOVE EL 233.172
1:125

AS CONSTRUCTED
DATE SEPTEMBER 1993 BY P.R.B.
APPROVED BY *Sean Quigley*

B.M. ELEV.		MacLAREN ENGINEERS INC. WARDROP ENGINEERING INC.	
		ENGINEERING CONSULTANTS	
DESIGNED BY	CAS/RDJ	CHECKED BY	RDJ
DRAWN BY	TL	APPROVED BY	<i>[Signature]</i>
1 AS CONSTRUCTED	09/93 P.R.B.	HOR. SCALE:	AS SHOWN
0 ISSUED FOR TENDER	07/90 RDJ	VERTICAL:	AS SHOWN
NO. REVISIONS	DATE BY	DATE	DATE

ORIGINALLY DESIGNED BY
[Signature]
R. JUANEZA
PROVINCE OF ONTARIO
CONSULTANT DRAWING NO.
43525-24-S-M102

THE CITY OF WINNIPEG
WORKS AND OPERATIONS DIVISION
WATERWORKS, WASTE & DISPOSAL DEPARTMENT

SOUTH END WATER POLLUTION CONTROL CENTRE
SECONDARY CLARIFIER EXPANSION

CITY DRAWING NUMBER
SHEET OF
SECONDARY CLARIFIER
PLAN ABOVE 233.172
SEP-424

KEY PLAN
N.T.S.

FILE # SU 10231