


SHOP DRAWING REFERENCE		
DESCRIPTION	SUPPLIER	NUMBER
Sealants	Grace	2286
Metal Access Hatches	BBC Distributors	2291

REVISED AS CONSTRUCTED
DATE FEB 14/84 BY CSA
CHECKED BY CAZIANI

E. J. GABOURY AND ASSOCIATES
ARCHITECTS AND URBAN DESIGNERS

NO.	REVISIONS	DATE	APP.
1	ISSUED FOR TENDER	82/05/10	
2	FOR CLIENT'S REVIEW	22/01/82	

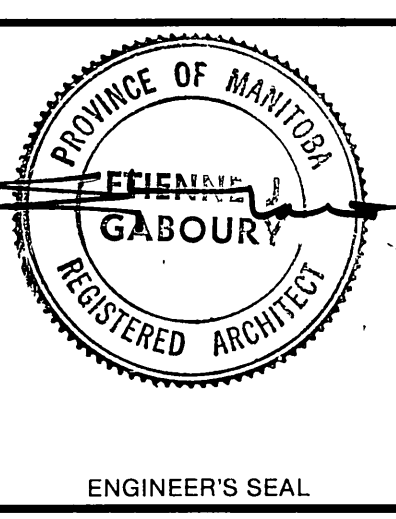

W. L. WARDROP & ASSOCIATES LTD.
MacLAREN ENGINEERS, PLANNERS & SCIENTISTS INC.

DESIGNED BY: D.C., E.J.G.
DRAWN BY: E

CHECKED BY: D.C.
DATE: 82.03.19

APPROVED BY: [Signature]
DATE: Mar/82

THE CITY OF WINNIPEG
WORKS & OPERATIONS DIVISION
WATERWORKS, WASTE & DISPOSAL DEPARTMENT

**NORTH END WATER POLLUTION CONTROL CENTRE
SECONDARY TREATMENT EXPANSION
MAIN BUILDING EXPANSION
ARCHITECTURAL - ROOF DRAINAGE
& CRAWL SPACE PLANS**

RELEASED FOR CONSTRUCTION DATE: 1982.05.07
SCALE: AS NOTED
DRAWING NO.: NEP 1017

METRIC
WHOLE NUMBERS INDICATE MILLIMETRES
DECIMALIZED NUMBERS INDICATE METRES

NR 1193