


# INSTRUMENT LOOP DIAGRAM

LOOP NO.

A-030-ZID    A-030-VB    A-030-ZSB  
 A-030-ZIB    A-030-HS-1    A-030-ZSD  
 A-030-VD    A-030-HS-2

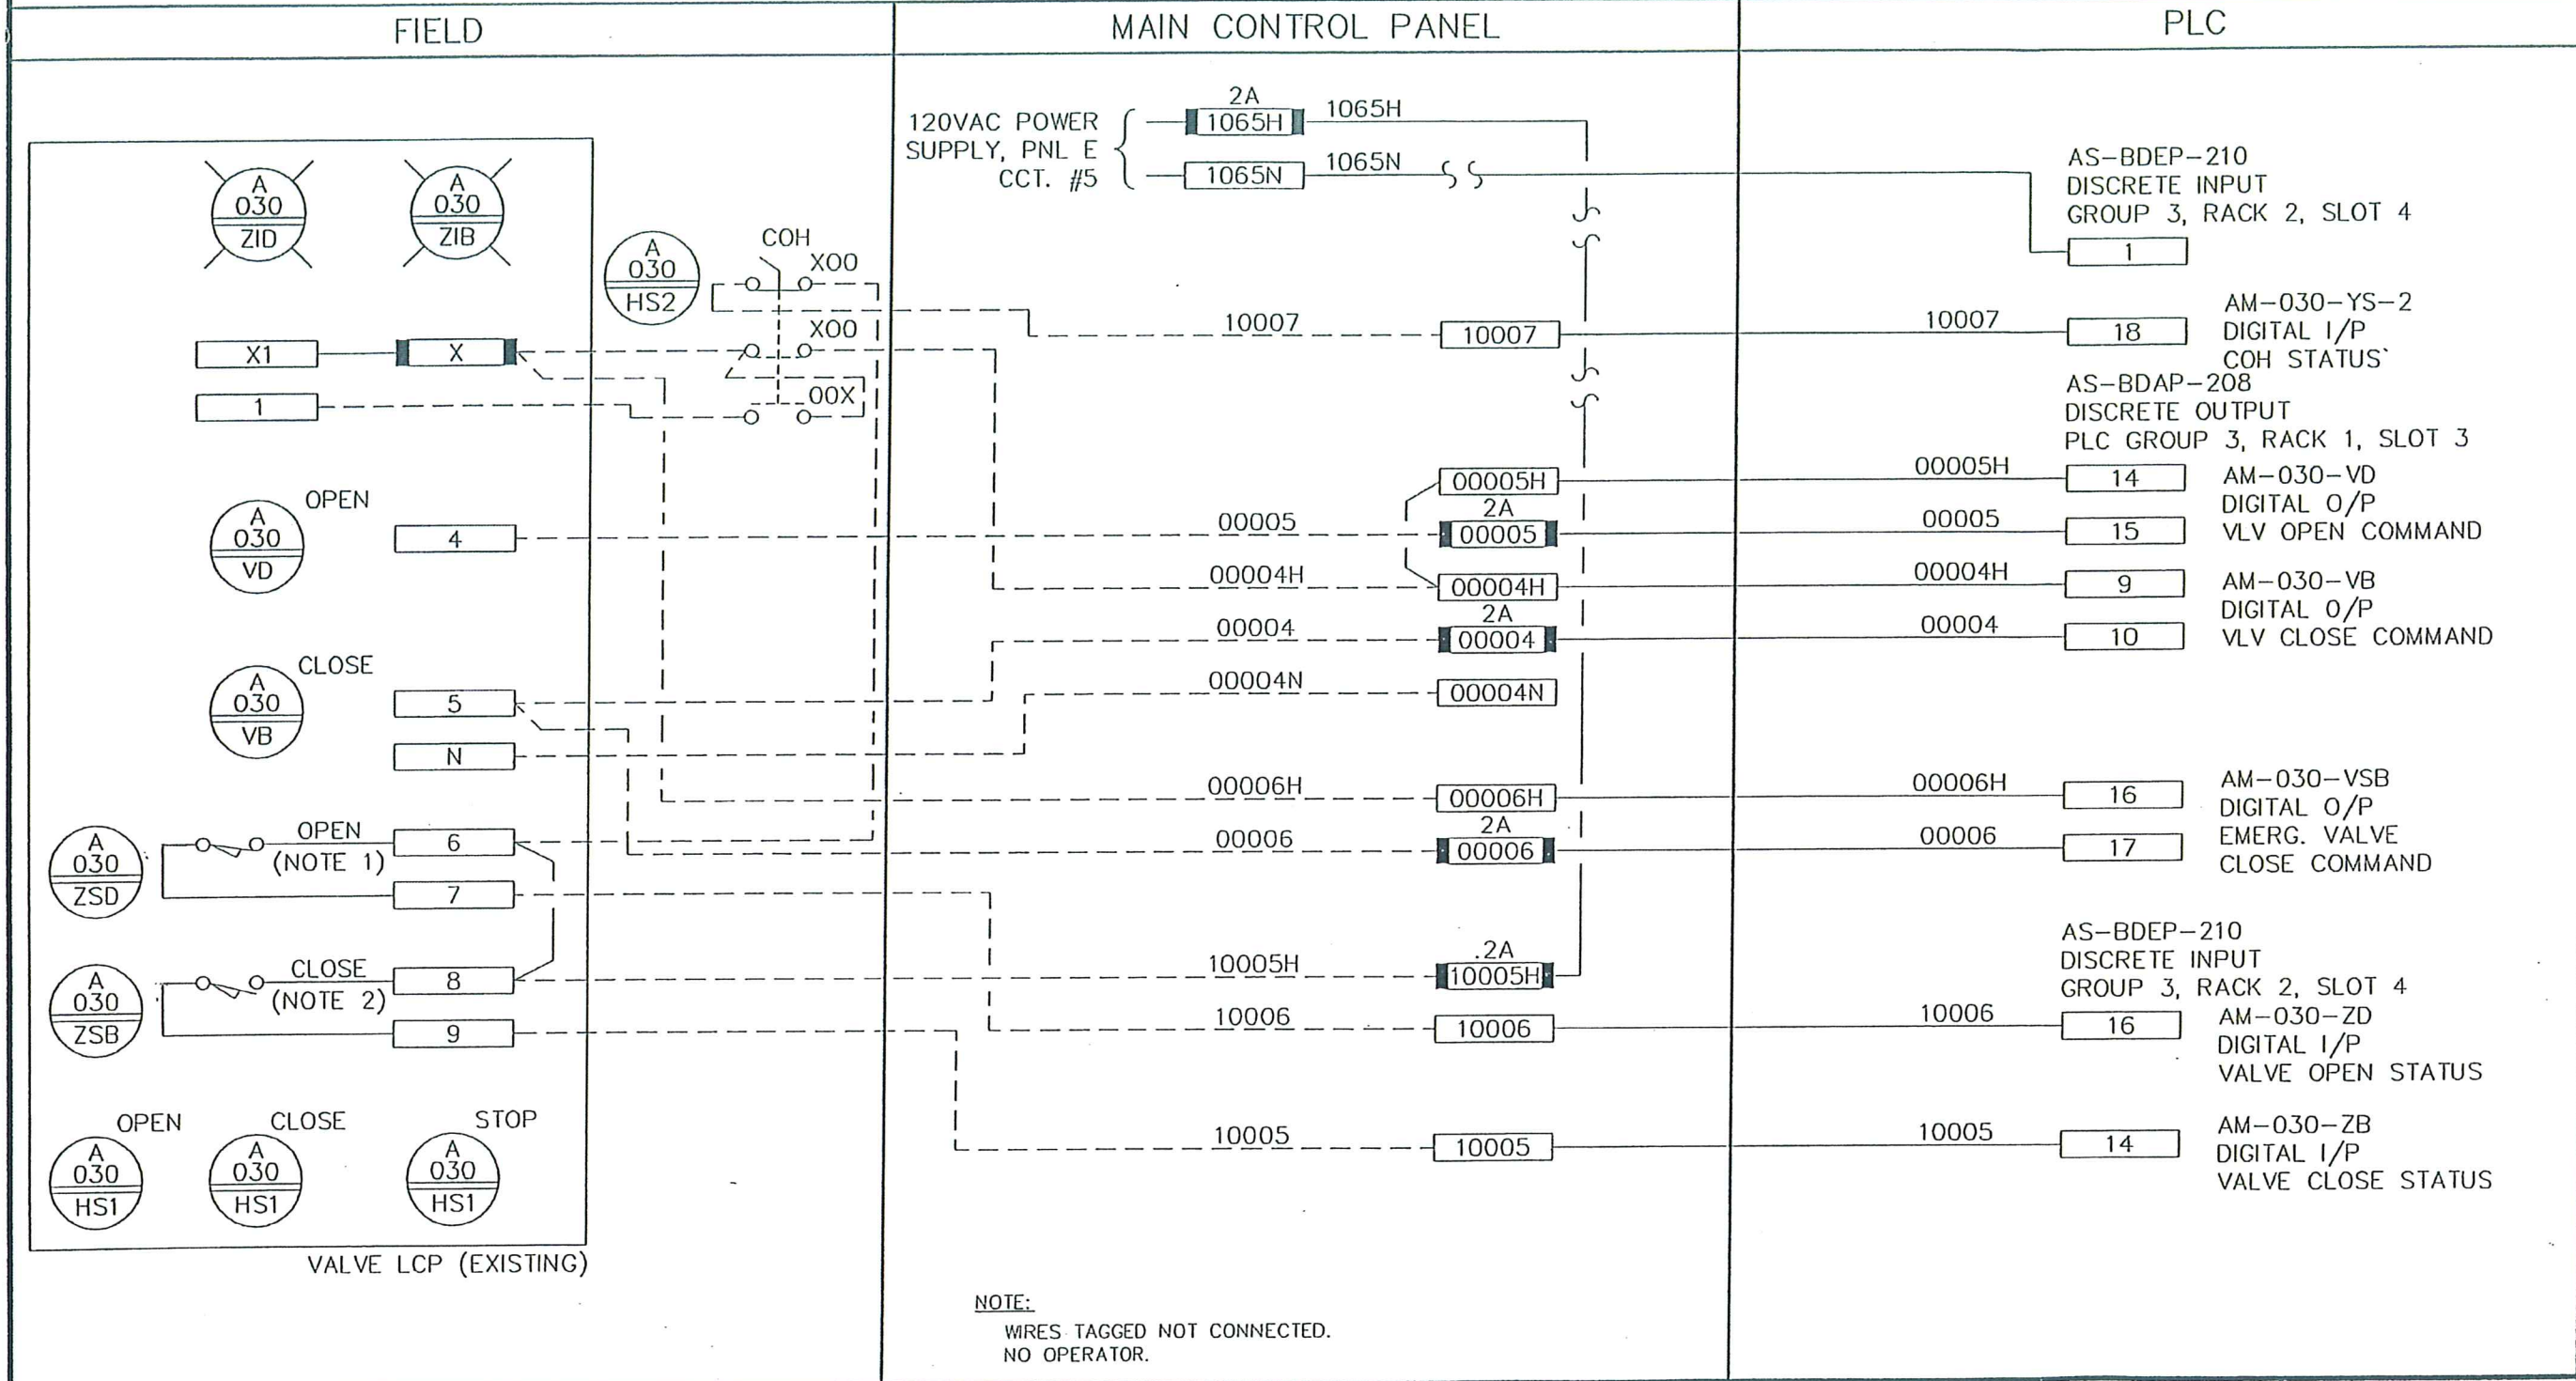

**NOTE:**

1. CONTACT CLOSED WHEN VALVE FULL OPEN.
2. CONTACT CLOSED WHEN VALVE FULL CLOSED.

	JOB NO. 3153
Kenonic Controls Ltd. Calgary, Alberta	FILENAME D2851
95.06.30 1 AS-BUILT	PL
94.09.14 0 ISSUED FOR CONST.	PL
94.08.17 A ISSUED FOR APPROVAL	PL
DATE REVISION	APP.

**THE CITY OF WINNIPEG**  
 REGIONAL WATER SUPPLY SYSTEM  
 INSTRUMENTATION CONTROL AND DATA ACQUISITION

DEACON BOOSTER PUMPING STATION - MCP  
 VC-6 VALVE

SCALE \_\_\_\_\_

DATE 94.08.17

DES PL DWN LFB

CKD DN APP LK

DRAWING NO.  
D-2851