


INSTRUMENT LOOP DIAGRAM

LOOP NO. DD-256-LT

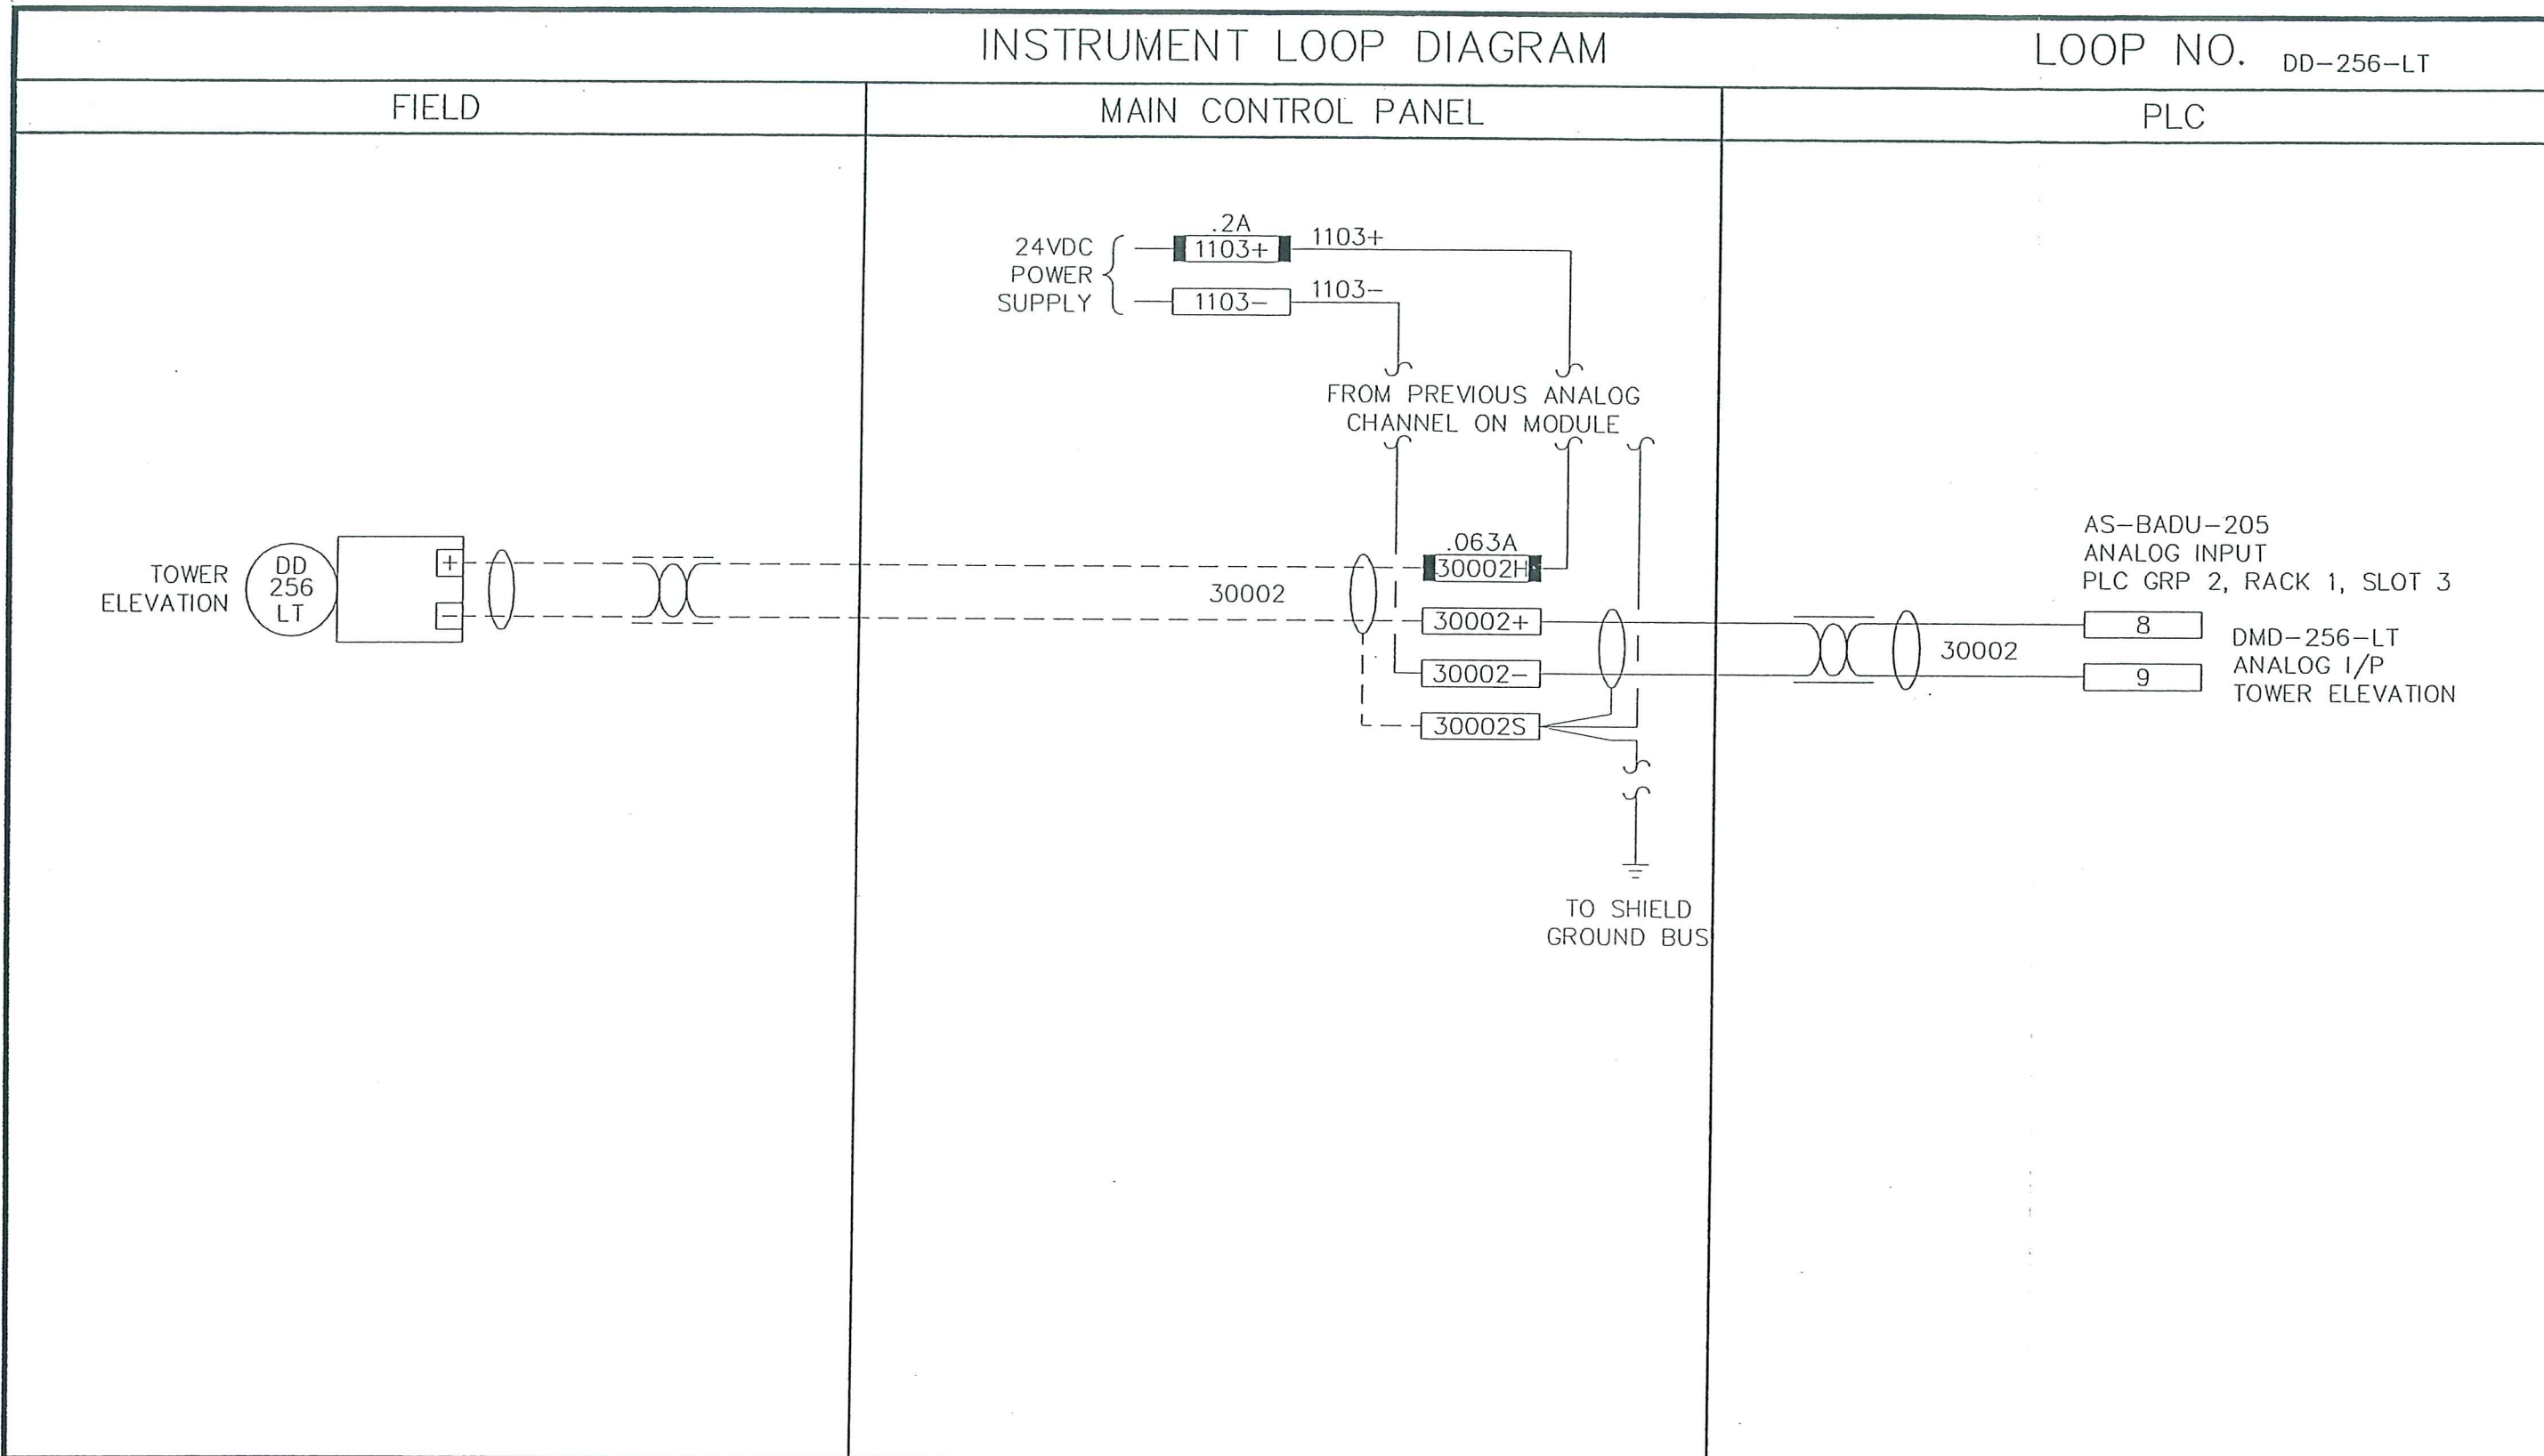

NOTE:

Kenonic Controls Ltd. <small>Calgary, Alberta</small>		JOB NO. 3153
		FILENAME D2863
95.06.30 1 AS-BUILT	PL	
94.09.14 0 ISSUED FOR CONST.	PL	
94.08.10 A ISSUED FOR APPROVAL	PL	
DATE	REVISION	APP.



THE CITY OF WINNIPEG
REGIONAL WATER SUPPLY SYSTEM
INSTRUMENTATION CONTROL AND DATA ACQUISITION

DEACON BOOSTER PUMPING STATION - MCP
TOWER ELEVATION

SCALE _____
DATE 94.08.17
DES PL DWN LFB
CKD DN APP LK

DRAWING NO.
D-2863