

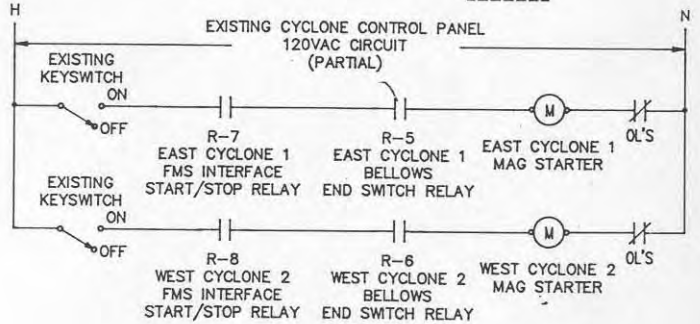
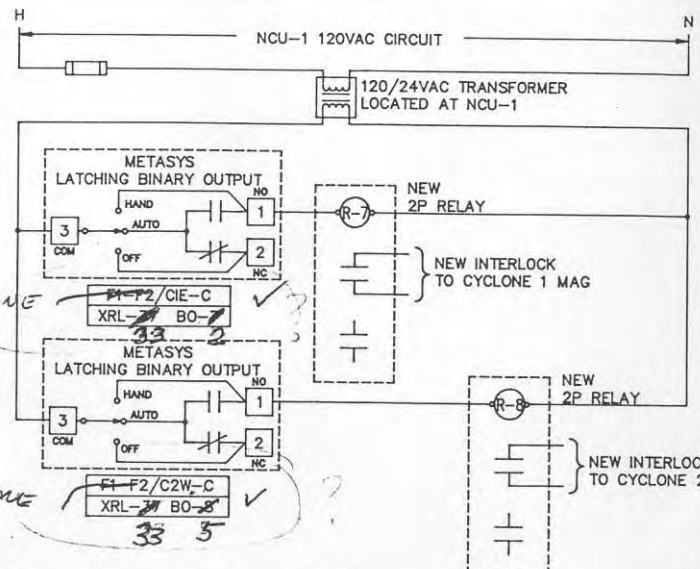


NEW FMS INTERFACE RELAY ENCLOSURE
120VAC CIRCUIT

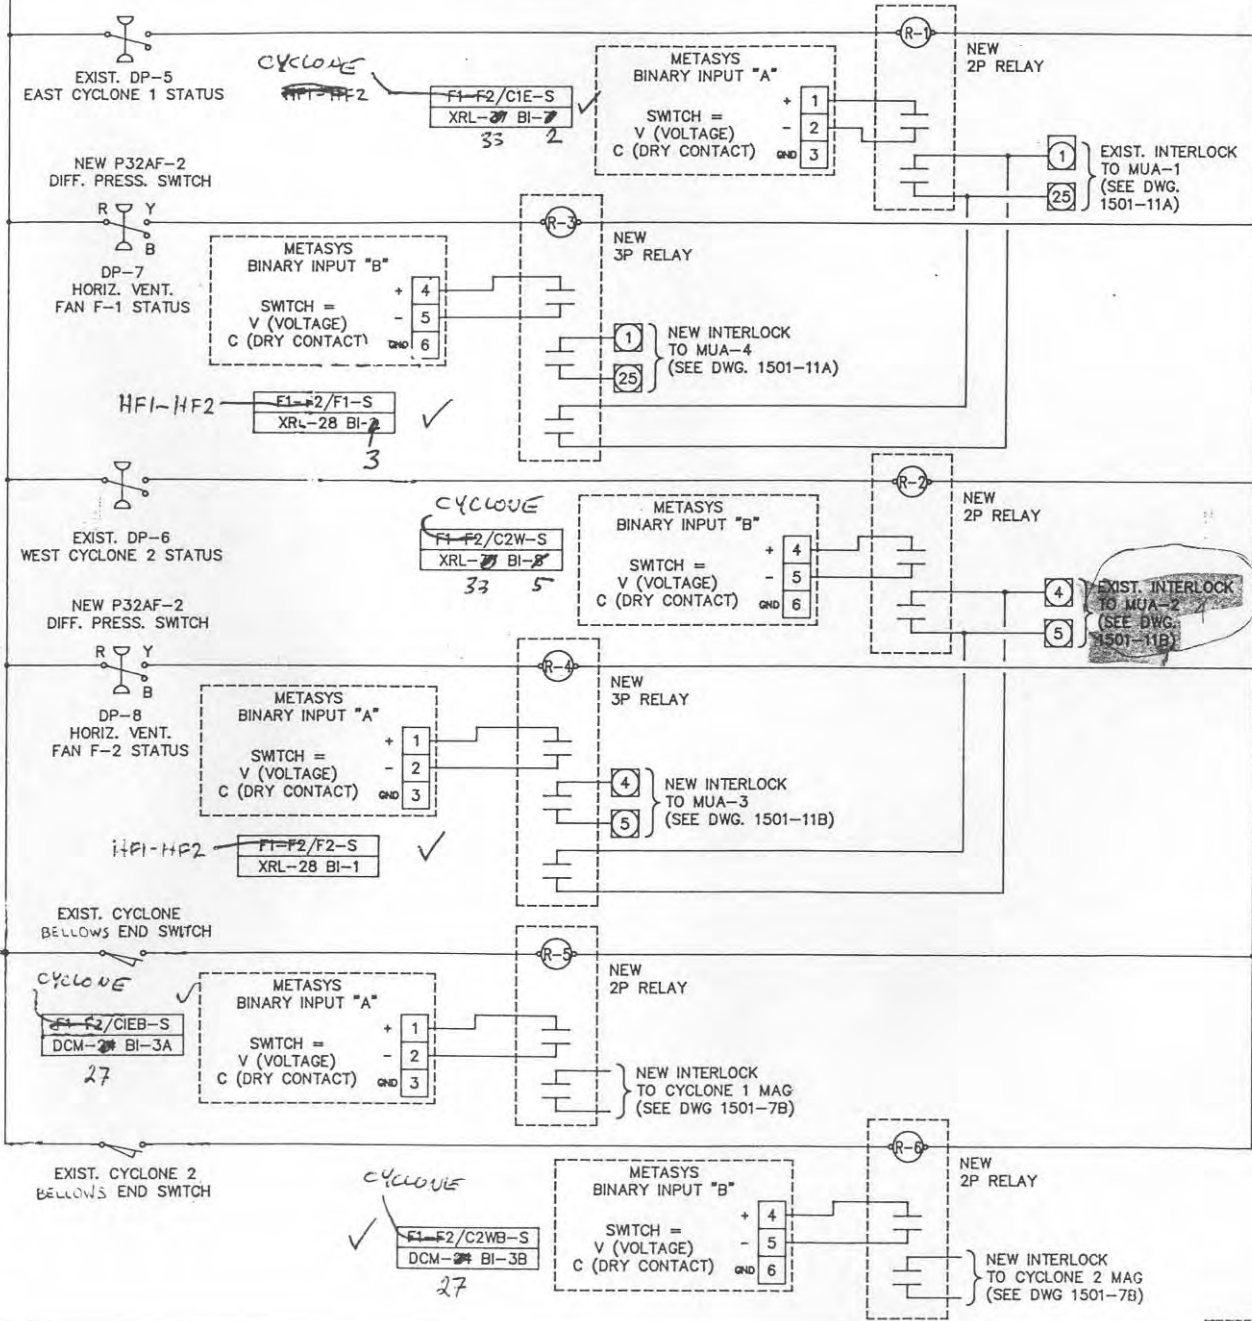

- LEGEND**
- n EXISTING M.C.C. TERMINALS
 - n METASYS BASEFRAME TERMINALS
 - nm WIRE/CABLE NUMBER

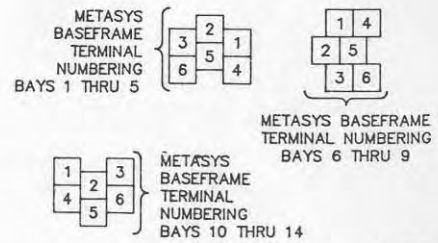

DRAWING TITLE		3 AS BUILT		FILE: VENTIFAN
FT. ROUGE BUS GARAGE		2 CYCLONE SST ADD		06/28/77 JHF
HORIZONTAL VENTILATION SYSTEM, MAKE-UP AIR UNIT & CYCLONE INTERLOCKING WIRING		1 WR. DETL. ADDED		12/09/76 JHF
PROJECT		MINNAPAC TRANSIT METASYS FACILITY MANAGEMENT SYSTEM		06/13/76 JHF
SALES ENGINEER		DRAWN		DATE BY
BH		JHF		05/17/90 JHF
CONTRACT NUMBER		90098-0310		DRAWING NUMBER
1501-7A		JOHNSON CONTROLS Systems & Services Division		1501-7A