


DELETED

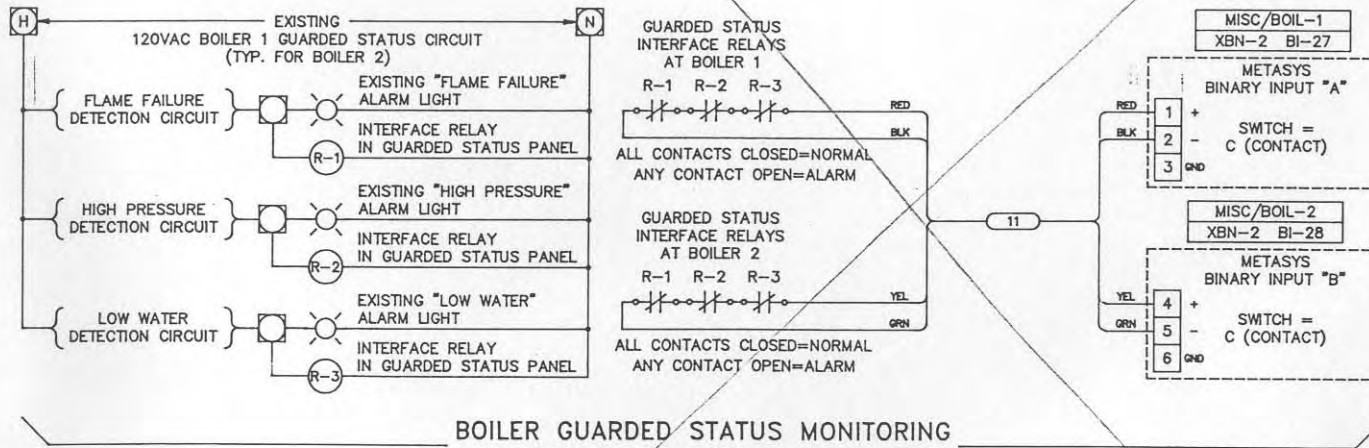

LEGEND

n EXISTING M.C.C. TERMINALS

n METASYS BASEFRAME TERMINALS

nn WIRE/CABLE NUMBER

METASYS BASEFRAME TERMINAL NUMBERING BAYS 1 THRU 5

3	2
5	1
6	4

METASYS BASEFRAME TERMINAL NUMBERING BAYS 6 THRU 9

1	4
2	5
3	6

METASYS BASEFRAME TERMINAL NUMBERING BAYS 10 THRU 14

1	3
2	6
4	5

DRAWING TITLE NORTH BUS GARAGE BOILER STATUS WIRING DETAIL				FILE: N-BOILER	
PROJECT WINNEPEG TRANSIT METASYS FACILITY MANAGEMENT SYSTEM		1 AS BUILT		DATE BY	
SALES ENGINEER PROJECT MANAGER BH DM JHF		REVISION-LOCATION DRAWN		DATE BY	
CONTRACT NUMBER 90098-0310		APPROVED		DATE	
DRAWING NUMBER 1501-21		JOHNSON CONTROLS Systems & Services Division		BY CH DATE 06/25/90	