


DOORS/
 XBN-2 BI 1 to 16

- LEGEND
- n EXISTING M.C.C. TERMINALS
 - n METASYS BASEFRAME TERMINALS
 - nn WIRE/CABLE NUMBER

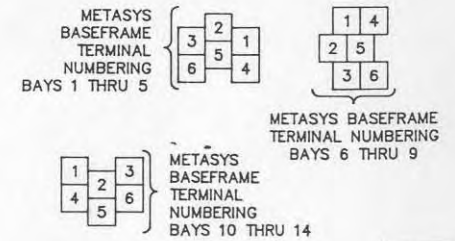

DRAWING TITLE
NORTH BUS GARAGE
OVERHEAD DOOR STATUS
METASYS INTERFACE

PROJECT
WINNIPEG TRANSIT
METASYS FACILITY
MANAGEMENT SYSTEM

		FILE: N-DDCDOR	
REFERENCE DRAWING NO.	1 AS BUILT	DATE	BY
SALES ENGR PROJECT NO.	REASON-LOCATION	ECN	DATE
BH	DM	BY	DATE
JOHNSON CONTROLS		CONTRACT NUMBER	
Systems & Services Division		90098-0310	
		DRAWING NUMBER	
		1501-23	