


Hauptman

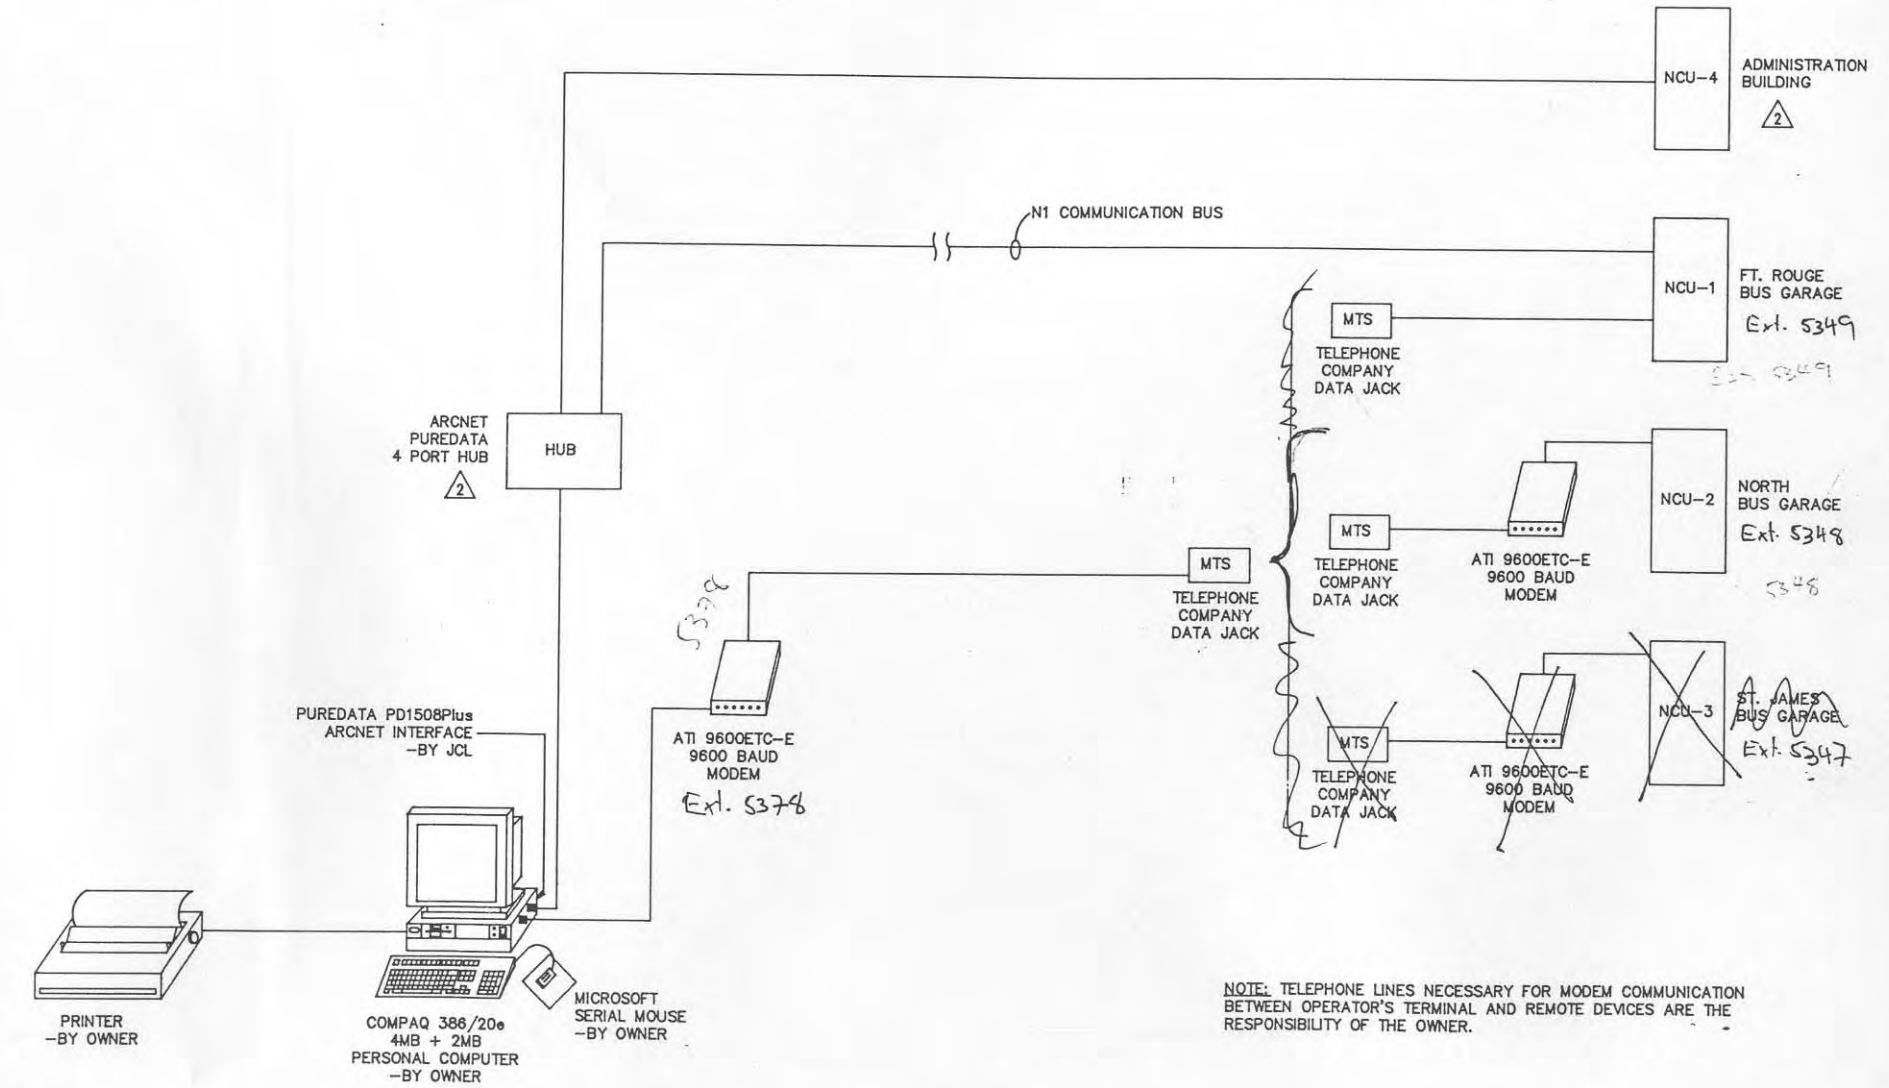

FMS OPERATOR'S TERMINAL EQUIPMENT
LOCATED IN WINNIPEG TRANSIT OFFICES (421 OSBORNE ST.)

NOTE: TELEPHONE LINES NECESSARY FOR MODEM COMMUNICATION BETWEEN OPERATOR'S TERMINAL AND REMOTE DEVICES ARE THE RESPONSIBILITY OF THE OWNER.

DRAWING TITLE FACILITY MANAGEMENT SYSTEM OPERATOR INTERFACE		AS BUILT 2 1098-5006		08/17/92 CMR	
AS BUILT 1 0098-0310		REVISION-LOCATION		08/28/91 JF	
PROJECT WINNIPEG TRANSIT METASTIS FACILITY MANAGEMENT SYSTEM		SALES ENGR PROJECT MGR APPL ENGR BH DM JIF		DRAWN BY APPROVED	
PROJECT		DATE 05/28/92		DATE	
JOHNSON CONTROLS LTD 800 MURRAY STREET WINNIPEG, MANITOBA R3U 3Y9		CONTRACT NUMBER 90098-0310		DRAWING NUMBER 1501-47	
JOHNSON CONTROLS Systems & Services Division		204-885-8380			