


JOHNSON CONTROLS AS-UNT111-0 CONTROLLER

ADDR #16
SF-2 SYSTEM

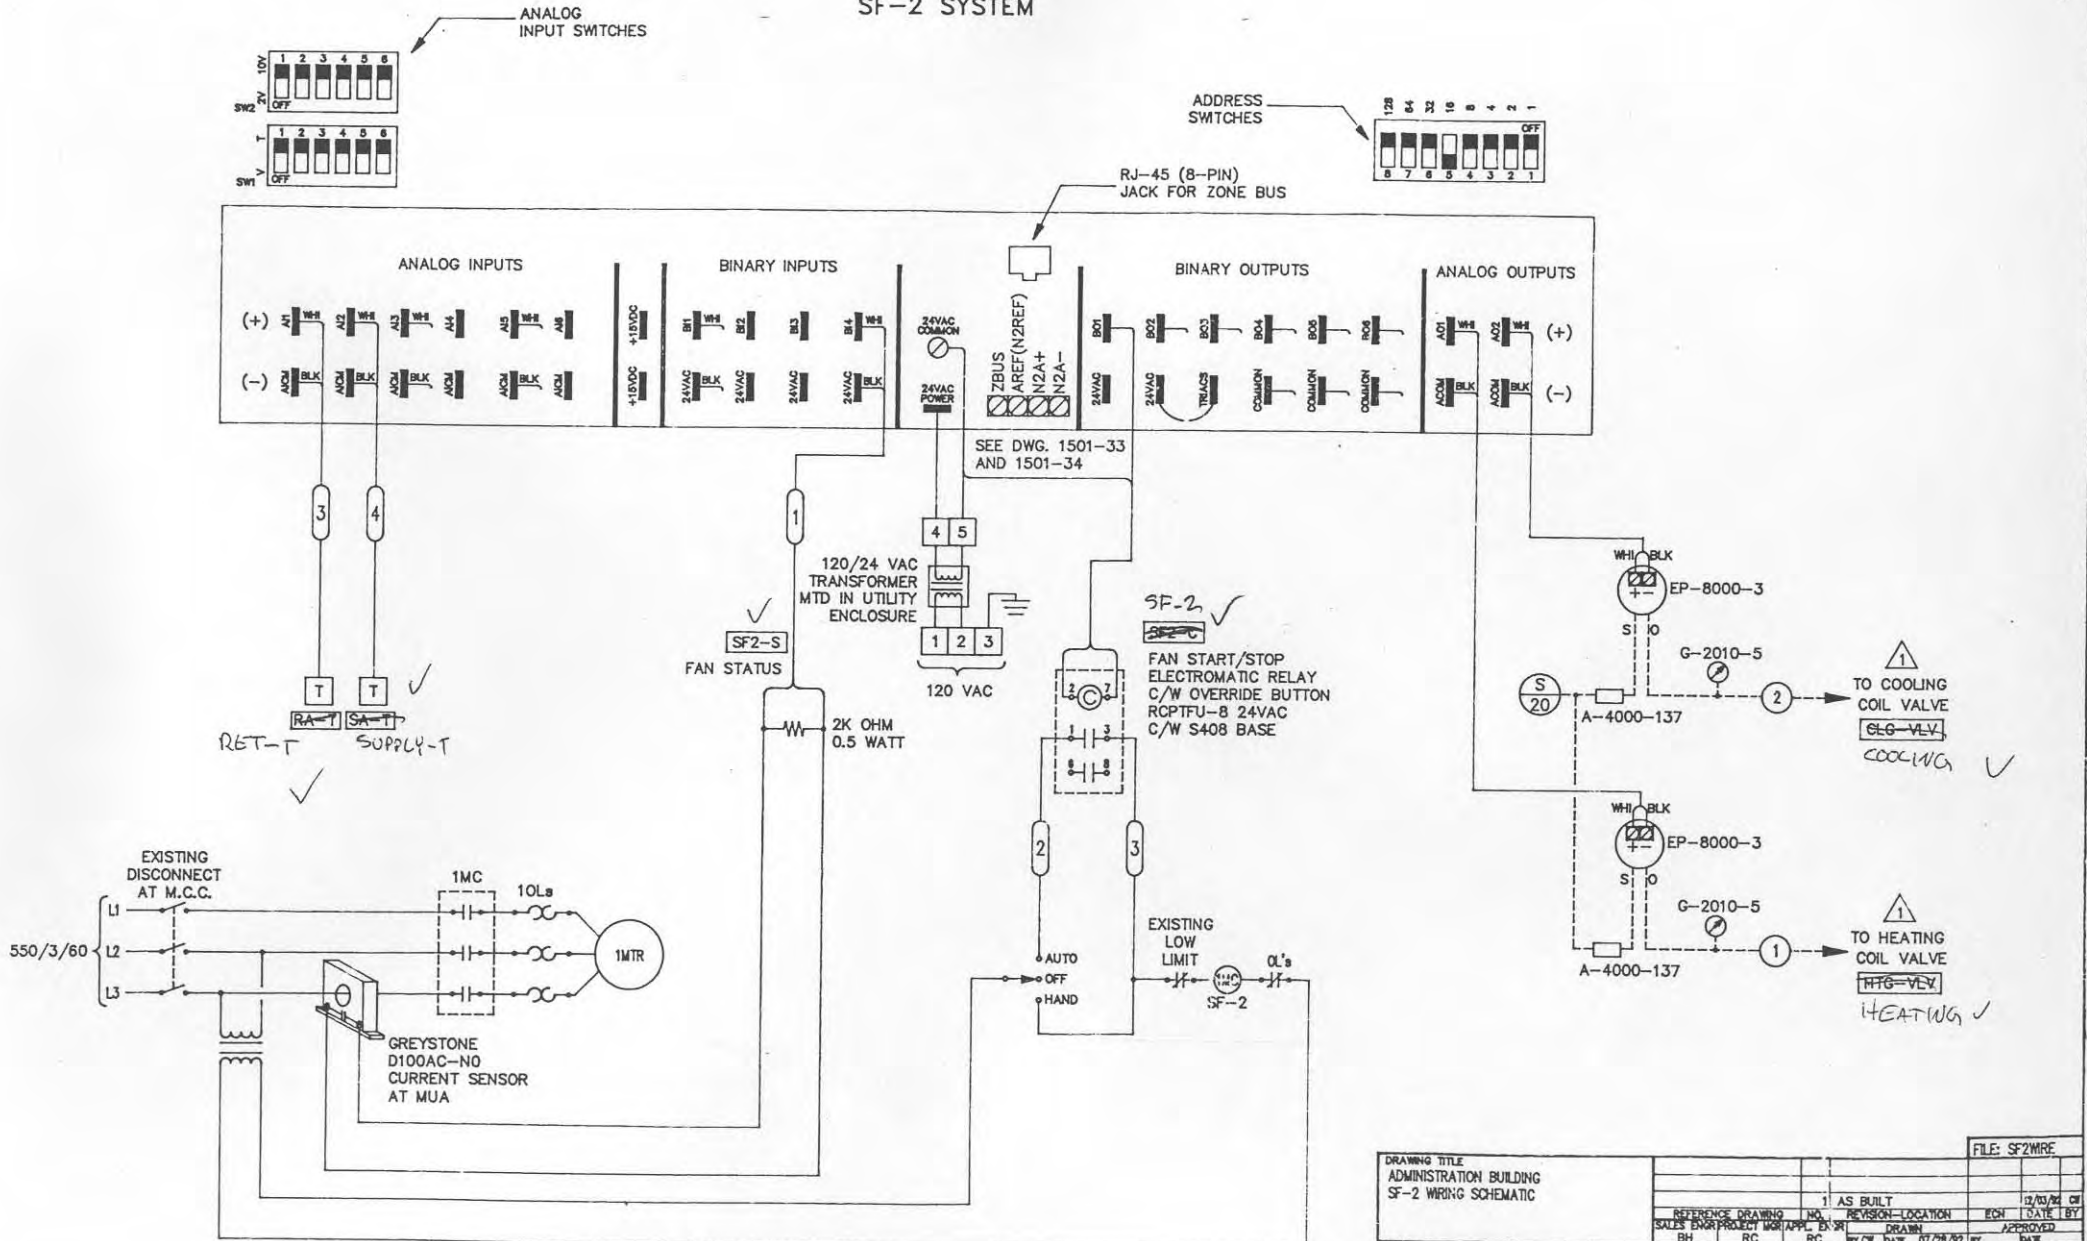

DRAWING TITLE		FILE: SF2WRE	
ADMINISTRATION BUILDING			
SF-2 WIRING SCHEMATIC			
REFERENCE DRAWING NO.	1 AS BUILT	DATE	12/10/82
SALES ENGR PROJECT MGR/APPL ENGR	REVISION-LOCATION	ECN	DATE BY
BH	RC	RC	DATE 07/28/82 BY
PROJECT	JOHNSON CONTROLS LTD	CONTRACT NUMBER	
WINNEPEG TRANSIT	800 WYAT STREET	92098-5007	
INFRARED AND SF-2	WINNEPEG, MANITOBA	DRAWING NUMBER	
421 OSBORNE STREET	R3J 3V9	1501-49	
WINNEPEG, MANITOBA	Systems & Services Division	204-885-9380	