
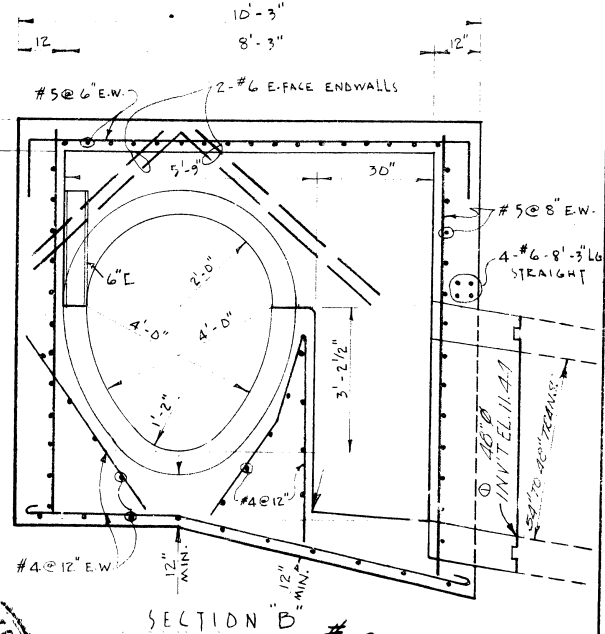



**REVISED AS
CONSTRUCTED**

BY *E.J.* DATE *15/4/56*
 CHECKED BY *A.* DATE *28 APR 66*

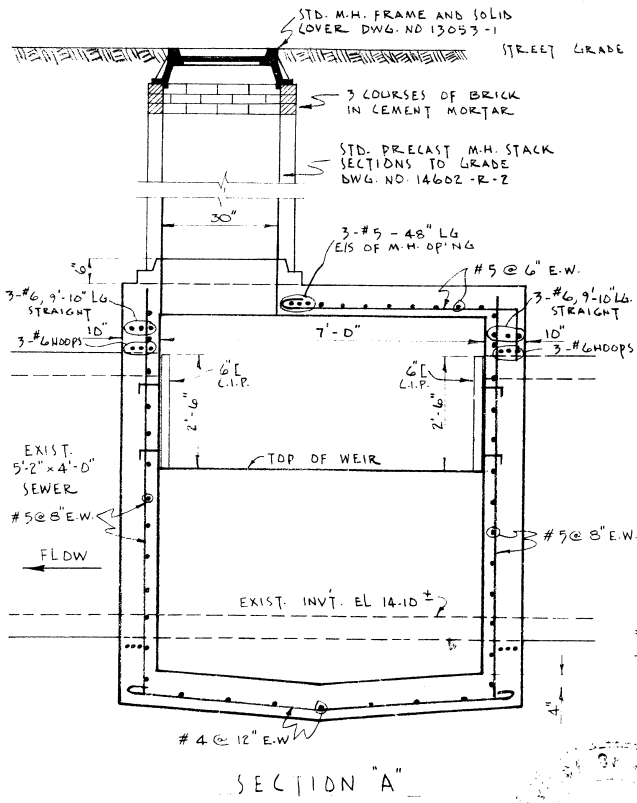

METRO APPROVAL REC'D

W.W. ENCASE DISINFECTANT *L.A.* DATE *8 JUNE 65*

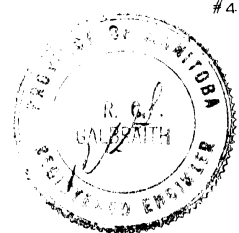

SC15720

REVISIONS			
NO	BY	DATE	REF.
1	HLB	25/7/65	INV'T. EL. 14.11

SPECIAL OVERFLOW SEWER A

CITY OF WINNIPEG - ENGINEERING DEPT.

DRAWN BY *D.G.* DATE *APRIL '65*
 TRACED BY *RCG*
 CHECKED BY *2/5/65*
 APPROVED *[Signature]*

SCALE 3/8" = 1'-0"