


FOR CONTINUATION SEE
DWG. N° NEP- 1262

AS CONSTRUCTED
APPROVED BY
DATE

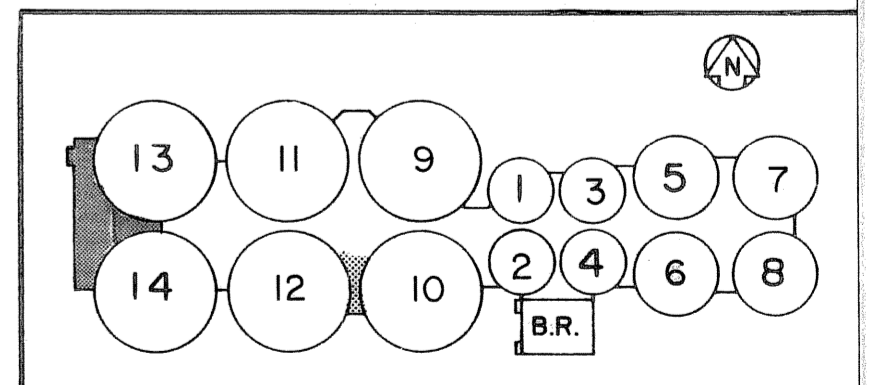


PLAN AT ELEV. 237.000

LEGEND

FOR SHOP DRAWING INFORMATION
REFER TO THE SHOP DRAWING
CROSS REFERENCE INDEX

"TO OBTAIN PLANT DATUM SUBTRACT 221.764 METRES"

A DESIGNATION
B ITEM ORIGIN
C ITEM LOCATION

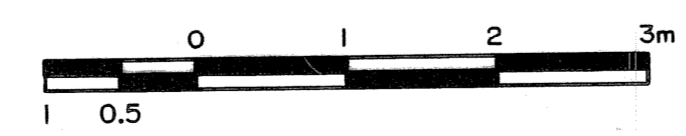

NO.	REVISIONS	DATE	APP.
A	REVISED TO AS CONSTRUCTED	10/21/85	

REGISTERED PROFESSIONAL ENGINEER
G. G. POWELL
PROVINCE OF ONTARIO
A.P.E.M. - 112-84 (R)
EXP. DATE: 85-10-15

Underwood McLellan Ltd.
Consulting Engineers and Planners
GORE & STORRIE LIMITED
CONSULTING ENGINEERS
DESIGNED BY: J. CHENG
DRAWN BY: C.L. S.C.
CHECKED BY: J. CHENG
DATE: JUNE / 85
APPROVED BY: [Signature]
DATE: JUNE / 85

THE CITY OF WINNIPEG
WORKS & OPERATIONS DIVISION
WATERWORKS, WASTE & DISPOSAL DEPARTMENT

NORTH END WATER POLLUTION CONTROL CENTRE
SLUDGE DIGESTION EXPANSION
DIGESTION GALLERY No. 7
PROCESS (LEVEL 233.820)
PLAN
RELEASED FOR CONSTRUCTION: [Signature]
DATE: 17/6/85
SCALE: AS NOTED
DRAWING NO: NEP-1264