


- NOTES**
1. LEGEND XXXXX DENOTES NEW CONC. BLK IN EXISTING STRUCTURES
 2. FOR GENERAL NOTES REFER TO DWG. 76012-03-512

FLOOR PLAN AT EL. 33.50'
1/16" = 1'-0"

MICROFILMED MAR 31 1980

NO.	DATE	DESCRIPTION
0	AS BUILT CSA	
1	ISSUED FOR TENDER	

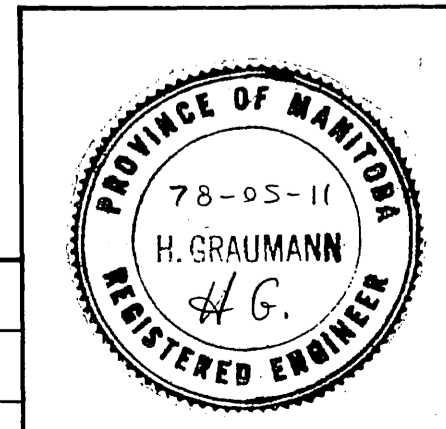

REV.	DATE	DESCRIPTION
0	AS BUILT CSA	
1	ISSUED FOR TENDER	

W. L. WARDROP & ASSOCIATES LTD.
JAMES F. MACLAREN LIMITED
ENGINEERING CONSULTANTS

DRAWN BY: R.N. DESIGNED BY: J.K.
CHECKED BY: A.G. APPROVED BY: [Signature]

THE CITY OF WINNIPEG
WORKS & OPERATIONS DEPARTMENT
WATERWORKS, WASTE & DISPOSAL DIVISION

NORTH END WATER POLLUTION CONTROL CENTRE
PRIMARY CLARIFIER ADDITION
ARCHITECTURAL
FLOOR PLAN & SECTIONS

SCALE: AS SHOWN
DATE: MAY 1978
CONSULTANT DRAWING NO. 76012-05-A101
CITY DRAWING NO. NEP-924

NR 11100