



2 SECTION THRU CANOPY
UA4/UA1 SCALE 1:10

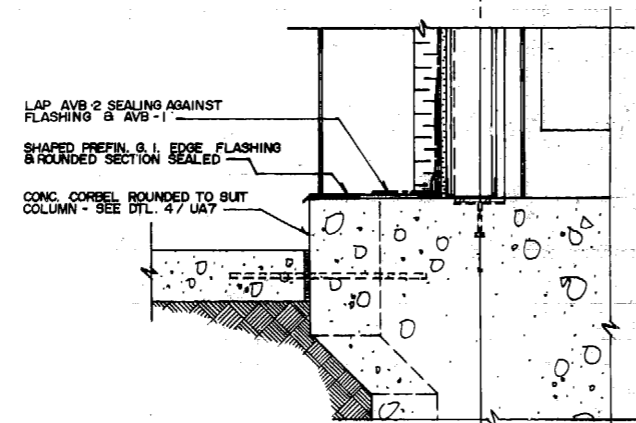

3 SECTION THRU CIRCULAR COLUMN
UA4/UA7 SCALE 1:10

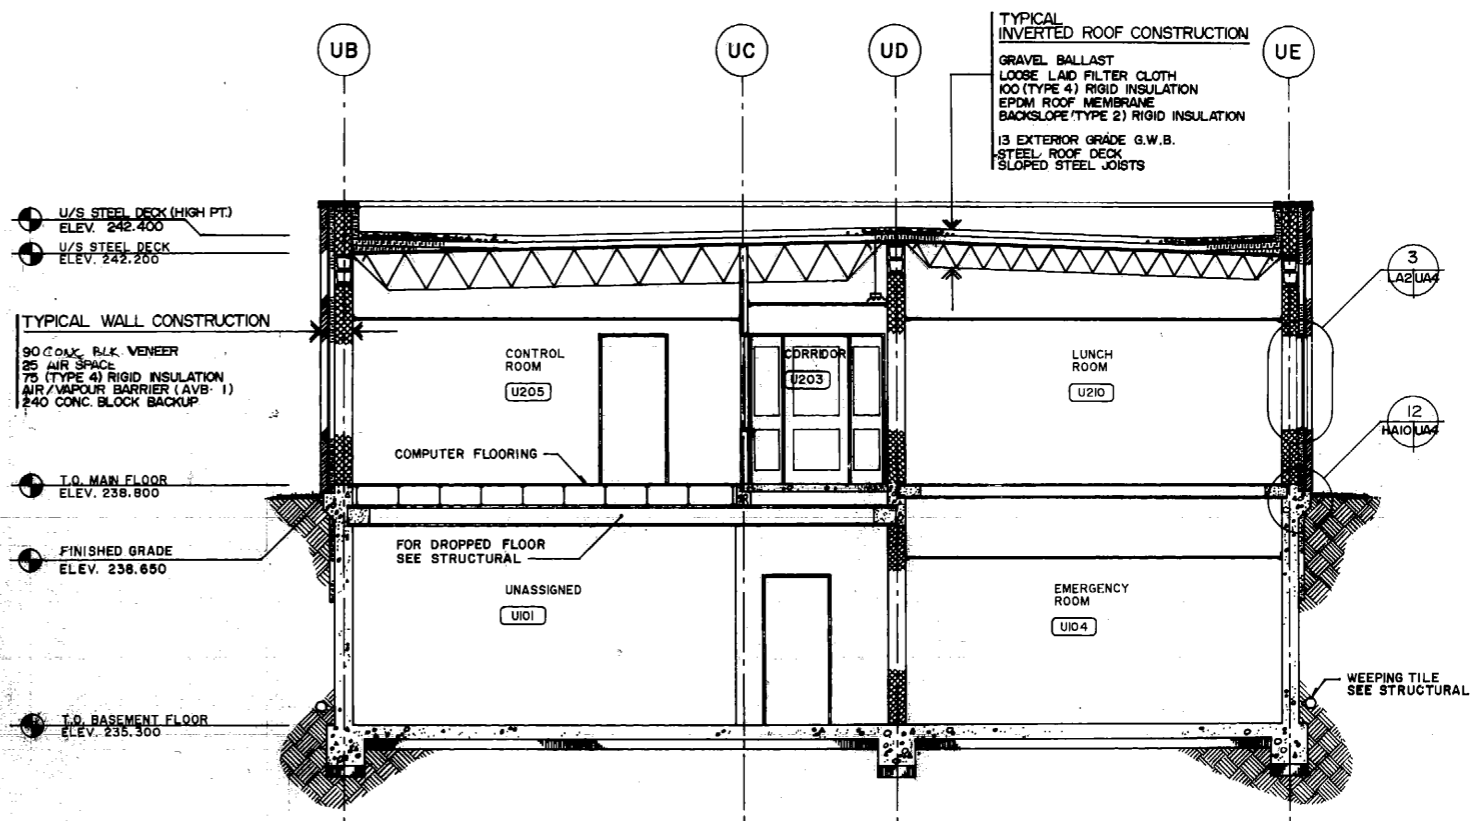

1 BUILDING SECTION
UA4/UA1 SCALE 1:50

U/S STEEL DECK (HIGH PT)
ELEV. 242.400
U/S STEEL DECK
ELEV. 242.200
TYPICAL WALL CONSTRUCTION
90 CONC. BLK. VENEER
25 AIR SPACE
75 (TYPE 4) RIGID INSULATION
AIR/VAPOUR BARRIER (AVB-1)
240 CONC. BLOCK BACKUP
T.O. MAIN FLOOR
ELEV. 238.800
FINISHED GRADE
ELEV. 238.650
T.O. BASEMENT FLOOR
ELEV. 236.300

TYPICAL INVERTED ROOF CONSTRUCTION
GRAVEL BALLAST
LOOSE LAID FILTER CLOTH
100 (TYPE 4) RIGID INSULATION
EPDM ROOF MEMBRANE
BACKSLOPE (TYPE 2) RIGID INSULATION
13 EXTERIOR GRADE G.W.B.
STEEL ROOF DECK
SLOPED STEEL JOISTS

REID, CROWTHER & PARTNERS LIMITED
WINNIPEG
AS CONSTRUCTED
SIG. *[Signature]* DATE *[Date]*

detail symbol
A detail number
B drawing where detail shown
C cross reference to drawing where detail taken

B.M. ELEV.			THE CITY OF WINNIPEG WORKS AND OPERATIONS DIVISION WATERWORKS WASTE AND DISPOSAL DEPT.		CITY DRAWING NUMBER SHEET OF
			WEST END WATER POLLUTION CONTROL CENTRE AREA U - ADMINISTRATION BUILDING		
DESIGNED BY		CHECKED BY		CONSULTANT DRAWING NO. 60910 - UA4	
DRAWN BY	K9/DJP/MAP	APPROVED BY		RELEASED FOR CONSTRUCTION DATE 01-03-13	
HOR. SCALE	AS NOTED	VERTICAL SCALE	AS NOTED	DATE 90-09-13	

File # WS 10333