




**ROOF PLAN**  
1:20

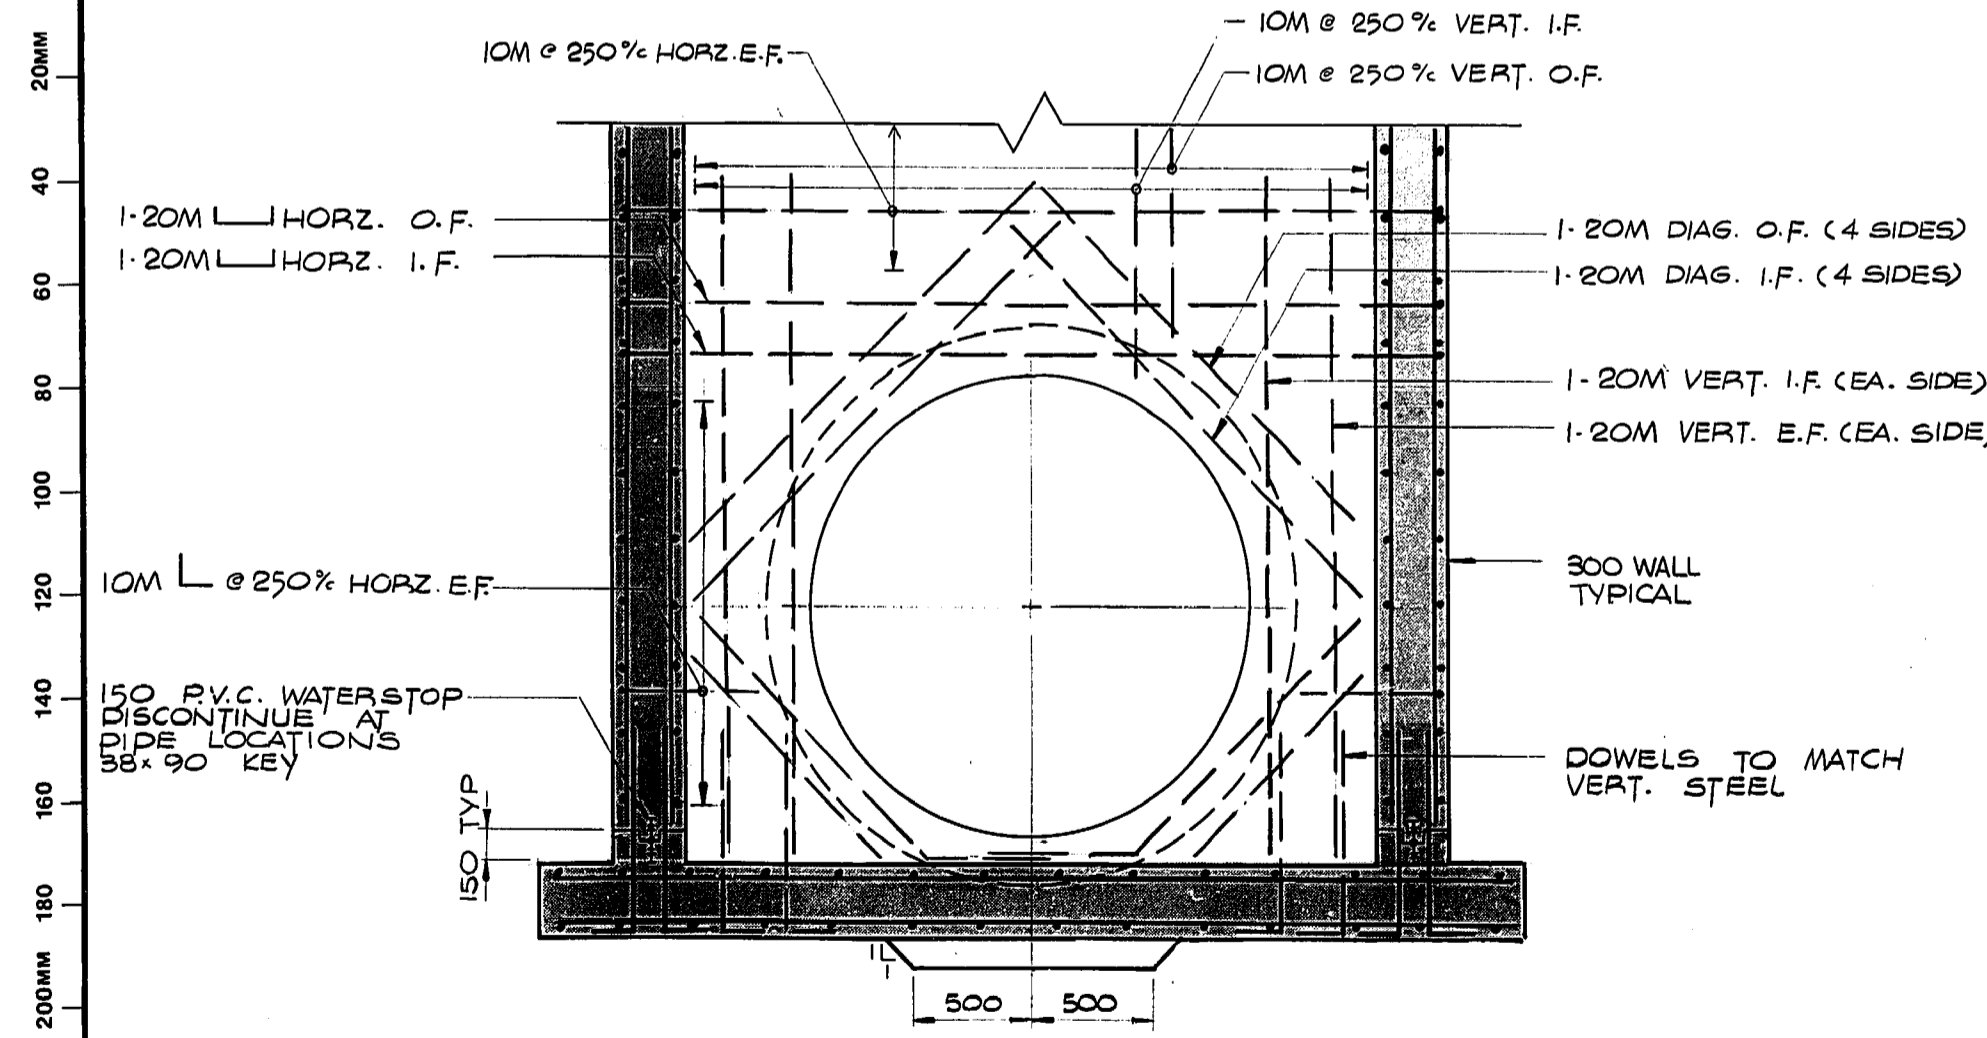

**SECTION 1**  
1:20

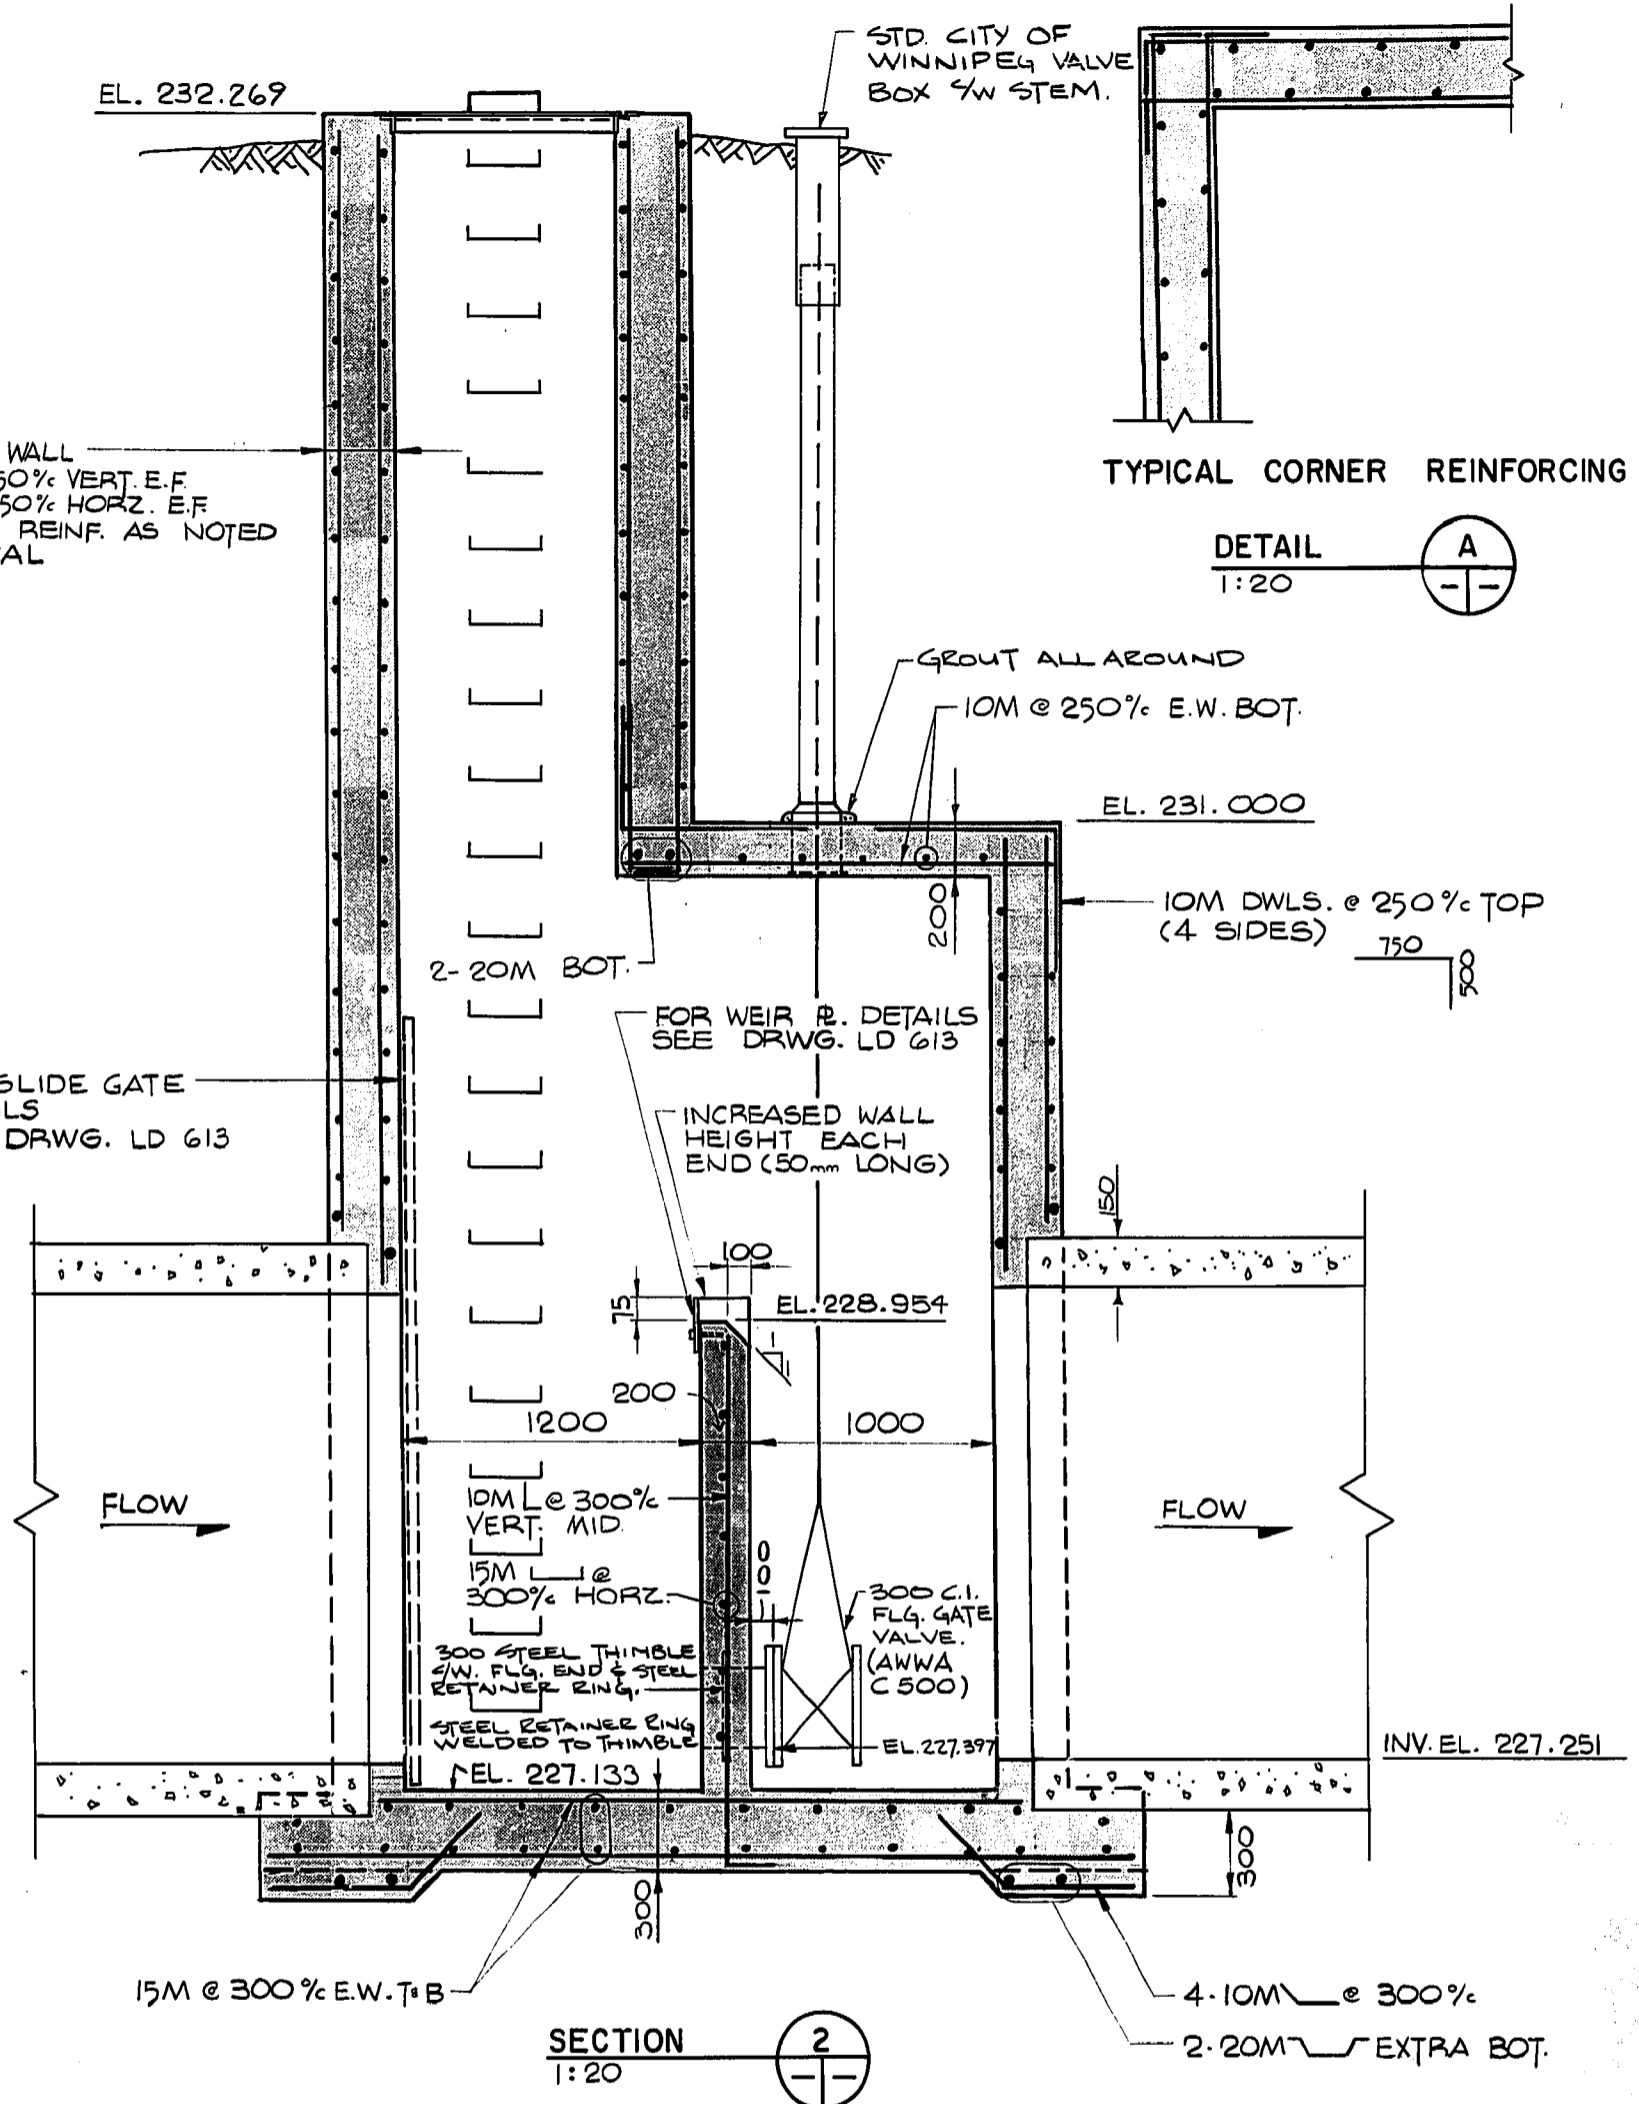

**SECTION 2**  
1:20

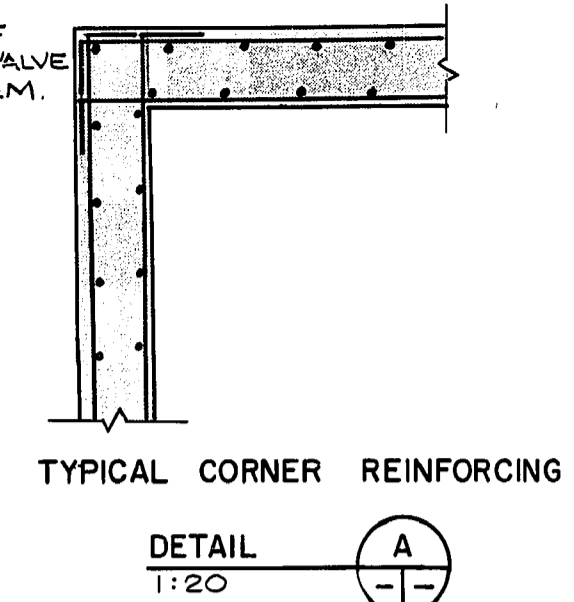



**TYPICAL CORNER REINFORCING**  
DETAIL A  
1:20

**THIS DRAWING IS METRIC RECORD DRAWING**

MICROFILMED

SHEET 5 of 13

REV.	DESCRIPTION	DWN.	APP.	DATE
B	REV. TO RECORD DRWG.	GDF		21-07-82
A	REV. ELEVATIONS & TOP LADDER RUNG ADDED	GDF		19/06/81

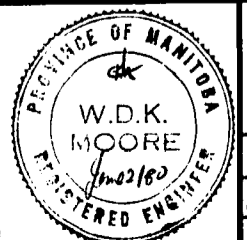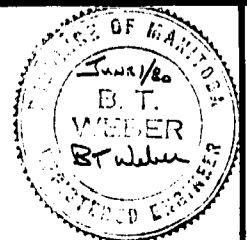

**Underwood McLellan Ltd.**  
Consulting Engineers and Planners  
APPROVED BY: *[Signature]* DATE: 03 JUN 80  
DRAWN BY: T.H. DESIGNED BY: I. McK., T.H.  
CHECKED BY: *[Signature]* CHECKED BY: *[Signature]*  
SCALE: 1:20 JOB No. 02-1393-007-12



THE CITY OF WINNIPEG  
DISTRICT 6  
**CAIRNS HOMES LTD.**  
LOT 16 LAKES  
CONTROL MANHOLE  
STRUCTURAL PLAN, SECTIONS AND DETAILS  
AB21 B  
DWG. No. REV.