

EXIST. CITY OFFICE

NOTE: FOR UNDERGROUND SERVICES: REFER TO DWGS. NEP-1297 TO 1299 FOR DETAILS.

NOTE:  
B.M. DERIVED FROM GEODETIC EL. 231.261, W. SIDE OF MAIN ST. ON THE NORTH END TREATMENT PLANT, TBLT., ON TOP OF CONC PIT IN FRONT OF MAIN BLDG., 22.3m E. OF LINE OF MOST ELY. WALL AND 18.8m S. OF MOST NLY. WALL OF MAIN BLDG. (TIES TO TBLT.)

ROAD RELOCATION  
(REFER TO DWG. NEP-1299 FOR DETAILS)


SOUTH PROPERTY LINE

304 SLUDGE FORCEMAIN

FOR SHOP DRAWING INFORMATION REFER TO THE SHOP DRAWING CROSS REFERENCE INDEX


AS CONSTRUCTED  
APPROVED BY: [Signature]  
DATE: 88-03-28

"TO OBTAIN PLANT DATUM SUBTRACT 221.764 METRES"

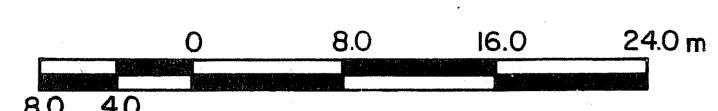

A	DESIGNATION
B	ITEM ORIGIN
C	ITEM LOCATION

NO.	REVISIONS	DATE	APP.
A	REVISED TO AS CONSTRUCTED	88/03/28	[Signature]

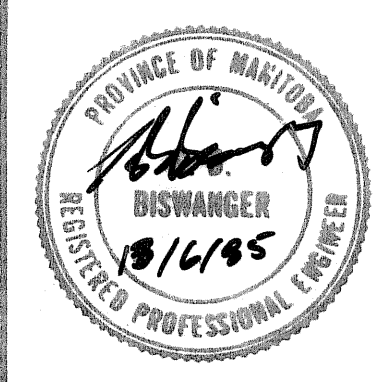

Underwood McLellan Ltd. Consulting Engineers and Planners	
GORE & STORRIE LIMITED CONSULTING ENGINEERS	
DESIGNED BY: B. BISWANGER	DRAWN BY: B.D.
CHECKED BY: D. ROGOWSKY	DATE: FEB./85
APPROVED BY: [Signature]	DATE: JUNE/85

**THE CITY OF WINNIPEG**  
WORKS & OPERATIONS DIVISION  
WATERWORKS, WASTE & DISPOSAL DEPARTMENT

NORTH END WATER POLLUTION CONTROL CENTRE SLUDGE DIGESTION EXPANSION	
<b>SITE PLAN</b>	
RELEASED FOR CONSTRUCTION:	DATE: 17/16/85
SCALE: AS SHOWN	DRAWING NO.: NEP-1187