

- WORK ROOM LIST
- A. D-182, D-183, V-229
  - B. D-184, D-185
  - C. D-186, D-187
  - D. D-188, D-189
  - E. D-191, D-192
  - F. D-190, D-195
  - G. D-193, D-194

MAIN FLOOR PLAN  
 SCALE 1:200

**SMS ENGINEERING**

SMS Engineering Ltd. Consulting Engineers  
 770 Bloor Street West, Suite 1000  
 Telephone: 204.775.5291 Fax: 204.772.2150  
 www.smseng.com

02-019-01

Drawings and specifications, as instruments of service, are the property of the architect. The copyright in the same being reserved to him. No reproduction may be made without the permission of the architect and when made, must bear his name. All rights are reserved to the architect.

The contractor shall verify dimensions and data noted herein with conditions on the site and will be responsible for reporting any discrepancy to the architect for adjustment.

This drawing shall not be used for building purposes until countersigned by:

THE CITY OF WINNIPEG


OFFICE ADDITION AND RENOVATIONS  
 1155 PACIFIC AVENUE  
 WINNIPEG, MANITOBA

**RECORD DRAWING**

CONTRACTOR: **Alec Electrical Limited**  
 930 BRADFORD STREET  
 WINNIPEG, MANITOBA  
 (204) 697-1000

DATE COMPLETED: \_\_\_\_\_ SIGNED BY: \_\_\_\_\_

NOTICE: THIS RECORD DRAWING HAS BEEN PREPARED, BASED UPON INFORMATION FURNISHED BY OWNER. WHILE THIS INFORMATION IS BELIEVED TO BE RELIABLE, THE CONSULTANT CANNOT ASSURE ITS ACCURACY, AND THIS IS NOT RESPONSIBLE FOR ANY ERRORS OR OMISSIONS WHICH MAY HAVE BEEN INCORPORATED INTO IT AS A RESULT.

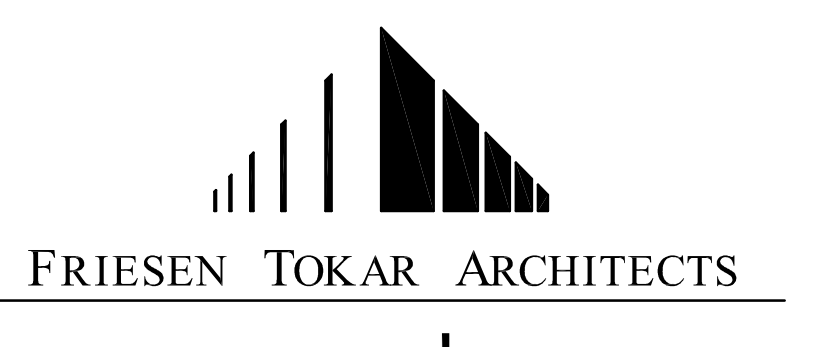

FRIESEN TOKAR ARCHITECTS

MAIN FLOOR PLAN  
 VOICEDATA LAYOUT

**E3.3**