
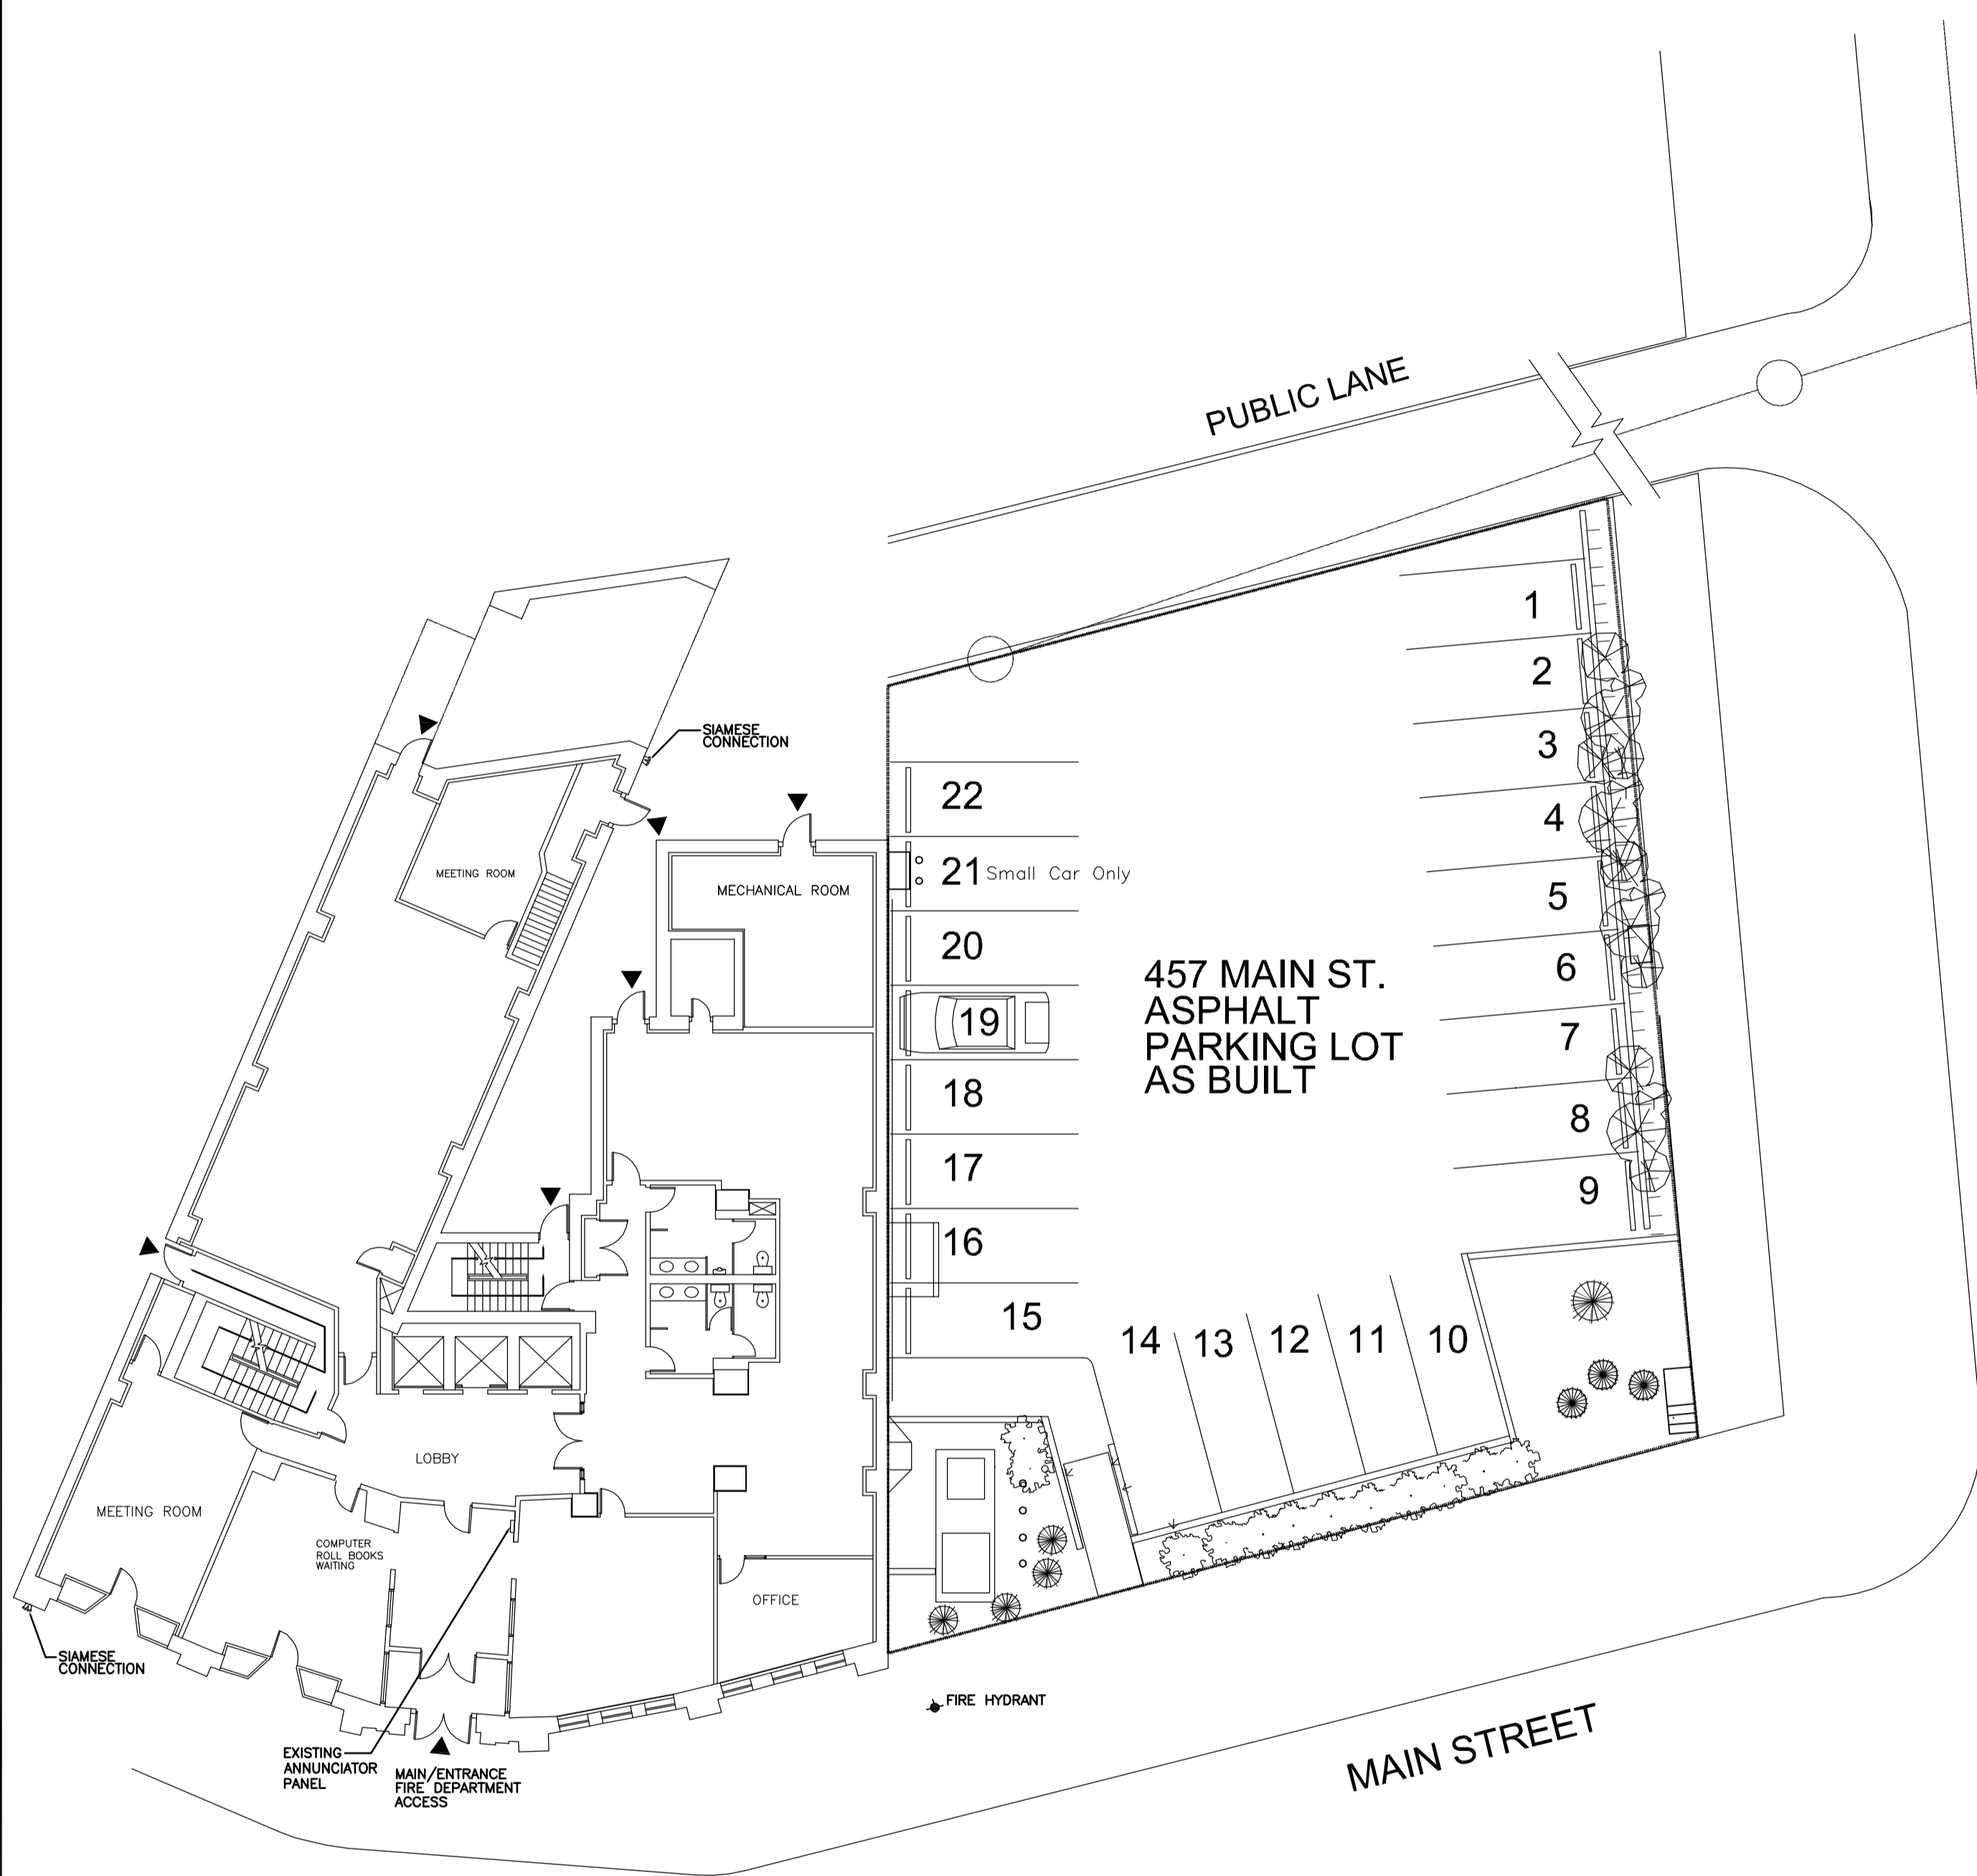


FILE NAME: 757-2008-A01-R1
 DATE: 2008.11.04
 DESCRIPTION: SITE PLAN LIFE SAFETY PLAN
 PROJECT NO.: 105111
 ADDRESS: 457 MAIN STREET

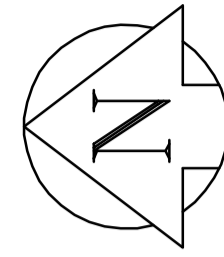

SITE PLAN - LIFE SAFETY PLAN
 SCALE: NTS

- NOTES :
- DENOTES EXITS FROM BUILDING
 - FIRE HYDRANT
 - STANDPIPE SIAMESE

2005 NATIONAL BUILDING CODE MATRIX

ITEM 457 MAIN ST. CONFEDERATION BUILDING, CITY OF WINNIPEG				NBC REFERENCE	
1. PROJECT DESCRIPTION:	STORAGE ROOM IN BASEMENT CONVERTED INTO ELECTRICAL AND MECHANICAL ROOMS IN AN EXISTING OFFICE BUILDING.	<input type="checkbox"/> NEW <input type="checkbox"/> ADDITION	<input checked="" type="checkbox"/> ALTERATION <input type="checkbox"/> CHANGE OF USE	<input checked="" type="checkbox"/> PART 3, 2.1.1 <input type="checkbox"/> PART 11, 11.1 - 11.4	
2. MAJOR OCCUPANCY(S):	D - OFFICE BUILDING			3.1.17 & 3.2.2	
3. BUILDING AREA:	EXISTING	NEW	TOTAL	1.4.1.2	
	630	-	630 SQ.M.		
4. GROSS AREA:	EXISTING	NEW	TOTAL	1.4.1.2	
	6272	-	6272 SQ.M.		
5. NUMBER OF STOREYS:	ABOVE GRADE	11	BELOW GRADE	1	1.4.1.2 & 3.2.2.15
6. HEIGHT OF BUILDING (M) (ASSUME 4 M PER FLOOR X 11 FLOORS + ROOF OF PH) =	48 M			3.2.2.5 & 3.2.6	
7. NUMBER OF STREETS/FIRE FIGHTER ACCESS:	1			3.2.2.10 & 3.2.5	
8. BUILDING CLASSIFICATION:	GROUP D, ANY HEIGHT, ANY AREA, SPRINKLERED			3.2.2.49	
9. SPRINKLER SYSTEM EXISTING:	<input checked="" type="checkbox"/> ENTIRE BUILDING <input type="checkbox"/> BASEMENT ONLY <input type="checkbox"/> IN LIEU OF ROOF RATING <input type="checkbox"/> NOT REQUIRED			3.2.2.49	
10. STANDPIPE EXISTING:	<input checked="" type="checkbox"/> YES <input type="checkbox"/> NO EXISTING (2) AS INDICATED ON SITE PLAN			3.2.5.8	
11. FIRE ANNUNCIATOR EXISTING:	<input checked="" type="checkbox"/> YES <input type="checkbox"/> NO FIRE ANNUNCIATOR PANEL AT THE VESTIBULE			3.2.4	
12. WATER SERVICE/SUPPLY IS ADEQUATE:	<input checked="" type="checkbox"/> YES <input type="checkbox"/> NO ASSUMED			3.2.5.7	
13. HIGH BUILDING	<input checked="" type="checkbox"/> YES <input type="checkbox"/> NO			3.2.6	
14. PERMITTED CONSTRUCTION:	<input type="checkbox"/> COMBUSTIBLE <input checked="" type="checkbox"/> NON-COMBUSTIBLE <input type="checkbox"/> BOTH			3.2.2.49	
ACTUAL CONSTRUCTION:	<input type="checkbox"/> COMBUSTIBLE <input checked="" type="checkbox"/> NON-COMBUSTIBLE <input type="checkbox"/> BOTH			RECORD DRAWINGS (C.1908) SHOW REINF. CONCRETE COLUMNS & FLOORS	
15. MEZZANINE(S) AREA:	N/A SQ.M.				
16. OCCUPANT LOAD BASED ON:	<input type="checkbox"/> SQ.M./PERSON <input checked="" type="checkbox"/> BUILDING DESIGN				
	OCCUPANCY	LOAD (IN PERSONS)		EXISTING CITY OCCUPANTS	
	BASEMENT	-			
	1ST FLOOR	-			
	2ND FLOOR	-			
	3RD FLOOR	-			
17. TRAVEL DISTANCE:	2 MEANS OF EXITS FROM EVERY FLOOR AREA PROVIDED VIA EXIT STAIRS			3.4.2.5	
	MAXIMUM DISTANCE 40m				
18. BARRIER-FREE DESIGN:	<input type="checkbox"/> YES <input checked="" type="checkbox"/> NO N/A (EXISTING BUILDING DESIGN); BUILT 1900'S			3.8	
19. HAZARDOUS SUBSTANCES:	<input type="checkbox"/> YES <input type="checkbox"/> NO *INFORMATION NOT AVAILABLE				
20. REQUIRED FIRE RESISTANCE RATINGS (FRR):	*INFORMATION NOT AVAILABLE				
21. FIRE RATED SEPARATIONS:	FIRE SEPARATION REQUIRED (HRS)			3.6.2 FIRE SEPARATION REQUIRED (HRS)	
	NEW MECHANICAL, ELECTRICAL AND VESTIBULE ROOM. THERE IS A NATURAL GAS FIRE BOILER UNIT IN THE MECHANICAL ROOM.	1		1	
	FLOOR ASSEMBLY	2			
21. FIRE STOPPING:	ALL SERVICES PENETRATING FIRE RATED WALLS, CEILING AND THROUGH THE FLOOR REQUIRE 2 HR ULC FIRE STOPPING. THE CORRIDOR LEADING TO THE FIRE EXITS ARE ASSUMED TO HAVE 1 HR FIRE RATED WALLS, BUT NOT CONFIRMED.			3.1.11	
22. POST-DISASTER BUILDING	<input type="checkbox"/> YES <input checked="" type="checkbox"/> NO			TABLE 4.1.2.1	

1	ISSUED FOR ADDENDUM 4	GGP	2008.01.06
0	ISSUED FOR ADDENDUM 1	DC	2008.12.05
NO.	REVISION/DESCRIPTION	BY	DATE

SEALS

EARTH TECH | AECOM

SHAW ARCHITECT

DRAWN BY	SIC	CHECKED BY	APPROVED
DATE	2008.11.26	USER APPROVAL	

CITY OF WINNIPEG
 PLANNING, PROPERTY AND
 DEVELOPMENT DEPARTMENT
 CIVIC ACCOMMODATIONS DIVISION
 300 - 65 GARRY ST. R3C 4K4

PROJECT
 CONFEDERATION BUILDING
 SUPPLEMENTARY HEATING UPGRADES
 PHASE 1 - CITY BID OPP. NO. 757-2008
 457 MAIN STREET, WINNIPEG, MANITOBA

SHEET TITLE
 SITE PLAN
 LIFE SAFETY PLAN

APEGM
 Certificate of Authorization
 Earth Tech Canada Inc.
 No. 730 Expiry: April 30, 2009

AECOM

© 2008 EARTH TECH (CANADA) INC. ALL RIGHTS RESERVED.
 THIS DOCUMENT IS PROTECTED BY COPYRIGHT LAW AND MAY NOT BE USED, REPRODUCED OR MODIFIED IN ANY MANNER OR FOR ANY PURPOSE EXCEPT WITH THE WRITTEN PERMISSION OF EARTH TECH (CANADA) INC. DOING BUSINESS AS AECOM (AECOM) OR A PARTY TO WHICH ITS COPYRIGHT HAS BEEN ASSIGNED. AECOM ACCEPTS NO RESPONSIBILITY, AND DENIES ANY LIABILITY WHATSOEVER, TO ANY PARTY THAT USES, REPRODUCES, MODIFIES, OR RELIES ON THIS DOCUMENT WITHOUT AECOM'S EXPRESS WRITTEN CONSENT.

SCALE	PROJECT NO.	SHEET NO.
AS SHOWN	105111	A01