

**APPENDIX B**

**PRE-PURCHASED EQUIPMENT SHOP DRAWINGS (SEE 011100)**


**IQS35B4 WT actuator for existing IW11R2160 gearbox  
 (ON-OFF service)**

<b>Max. rating</b>	<b>actuator</b>	<b>135 Nm</b>	<b>100 Ft.lbs</b>
	<b>combination</b>	<b>115,425 Nm</b>	<b>85,500 Ft.lbs</b>
<b>Weight</b>	<b>actuator</b>	<b>69 Kg</b>	<b>152 lbs</b>
	<b>combination</b>	<b>375 Kg</b>	<b>825 lbs</b>
<b>Actuator speed</b>		<b>173 RPM</b>	
<b>Operating time (combination)</b>		<b>190 seconds</b>	
<b>Max. bore</b>	<b>actuator</b>	<b>44 mm</b>	<b>1-3/4"</b>
	<b>gearbox</b>	<b>203 mm</b>	<b>8"</b>
<b>Voltage</b>		<b>230 V / 1 ph / 60 Hz</b>	
<b>Wiring diagram</b>		<b>3001-000</b>	
<b>Amperage</b>	<b>rated torque</b>	<b>19 Amps</b>	
	<b>locked rotor</b>	<b>56 Amps</b>	

Provide mounting &  
 base details

Submission No. :	<b>SUBMITTAL REVIEW</b>		AECOM
Project No. :	D265-234-00		
Discipline :			
<input checked="" type="checkbox"/> Reviewed - No Comment	<input type="checkbox"/> Reviewed - Review and Resubmit		
<input checked="" type="checkbox"/> Reviewed - As Noted	<input type="checkbox"/> Review by Consultant Not Required		
<p>Review is solely for general conformity with contract. The Consultant does not warrant or represent that information in this submittal is accurate or complete. Review does not relieve Contractor of responsibility for errors/omissions in designs, including this submittal, that are the Contractor's responsibility, and for conforming/consolidating with all quantities/dimensions, performing the Work, selecting performance means/methods, coordinating with other parts of the Work/between trades, and performing the Work safely. Notwithstanding this review, Contractor remains solely responsible for contract compliance.</p>			
By :	[Signature]		Date : APR 24/09

CIRCUIT DRAWN WITH POWER SUPPLY OFF

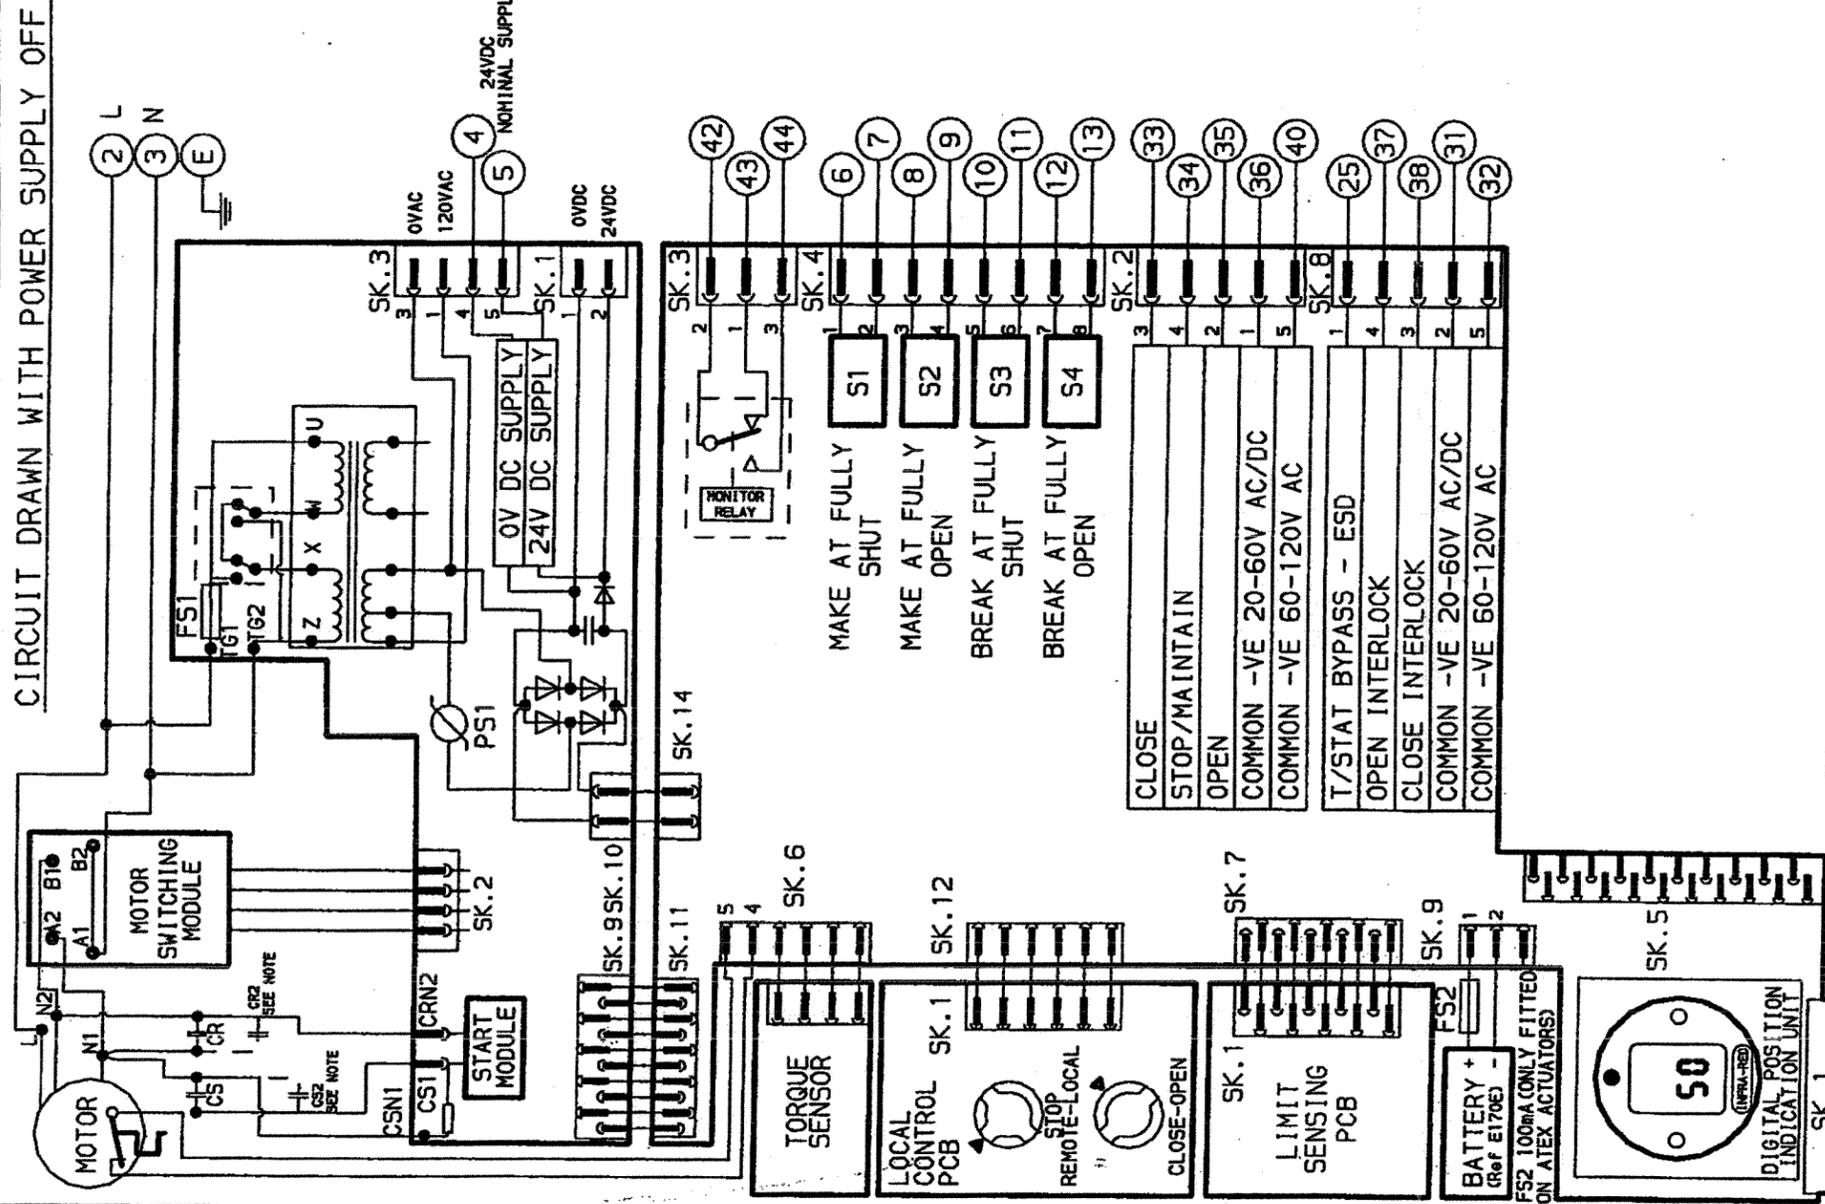

FOR TYPICAL REMOTE CONTROL DETAILS SEE DOCUMENT RWS300

TRANSFORMER TAPPING OPTIONS

VOLTAGE	50HZ	60HZ
LOW	92-135	92-135
HIGH	184-270	184-270

FUSE FS1 - 500mA ANTI-SURGE  
ALL TRANSFORMER TYPES - PS1 SELF RESETTING FUSE

CAPACITOR START/RUN (CS/CS2 and CR/CR2) COMBINATIONS & VALUES VARY WITH SUPPLY VOLTAGE & ACTUATOR SIZE.

NOTE

REFER TO PUBLICATION E170E FOR APPROVED FUSES FS1 AND FS2.

MAX EXTERNAL LOAD ON TERMINALS 4 & 5 TO BE 5W.

CONTROL SIGNAL THRESHOLD VOLTAGES TO BE MINIMUM 'ON' 20V AC/DC  
MAXIMUM 'OFF' = 3V  
MINIMUM CONTROL SIGNAL DURATION TO BE 300ms.

CURRENT DRAWN FROM EACH REMOTE CONTROL SIGNAL IS 5mA ON 24V DC OR 12mA ON 120V AC

WIRES ARE IDENTIFIED AT EACH END BY TERMINAL No. OR TAG No.

INDICATION CONTACTS S1-S4 ARE SHOWN IN THEIR DEFAULT CONFIGURATION. CONTACTS MAY BE CONFIGURED FOR ANY OF THE FUNCTIONS DESCRIBED IN E170E

Submission No.: **SUBSTANTIAL REVIEW** | ACCOM

Project No.: **D265-234-00** Discipline:

Reviewed - No Comment

Reviewed - As Noted

Reviewed - Review and Resubmit

Reviewed by Consultant Not Required

Review is solely for general conformity with contract. The Consultant does not warrant or represent that information in this submission is accurate or complete. Review does not relieve Contractor of responsibility for errors/omissions in designs, including this submission, that are the Contractor's responsibility, and for conforming/compliance with all qualifications/conditions, performing the Work, selecting performance means/methods, coordinating with other parts of the Work/between trades, and performing the Work safely. Notwithstanding this review, Contractor remains solely responsible for contract compliance.

By: *B. Moore* Date: *April 24/09*

No	06
DATE	301004
REVISION DETAILS	
DIAGRAM RE-FORMATTED TO SEPERATE REMOTE CONTROL CIRCUITRY (See 'RMS' Ref)	




<b>www.rotork.com</b>	
ROTORK CONTROLS LTD	ROTORK CONTROLS INC
BATH, BA1 3JG	ROCHESTER
ENGLAND	NY 14624, USA
Tel: 01225-733200	Tel: 585-328-1550

CONFIG BY	PRE
DATE	081004
CHECKED	PJW
BASE WD	--
JOB No	--
M.I.No	--
IQ	
SINGLE PHASE	
CIRCUIT DIAGRAM No -REV 102	
<b>3001-000-06</b>	
B1 C1 B2 C2	

MAX BORE SQ KEY	
STD BORE	KEY
BS42.35	-
BS46	-
ANSI B17.17.375 1.3/4 SQ	

MAX BORE RECTANGULAR KEY	
STD BORE	KEY
BS42.35	50 x 28
BS46	7.625 2 x 1.3/8
ANSI B17.17.625 12 x 1.1/2	


VIEW SHOWING HAND OPERATED UNIT  
RATIOS 180, 240, 360, 480, 540, 720  
960, 1080, 2160, 2520 & 3000

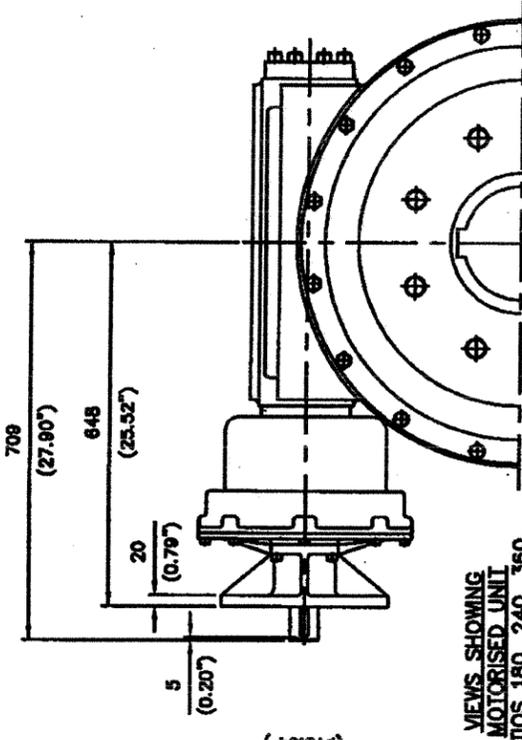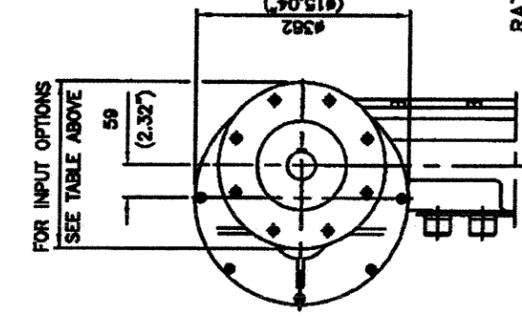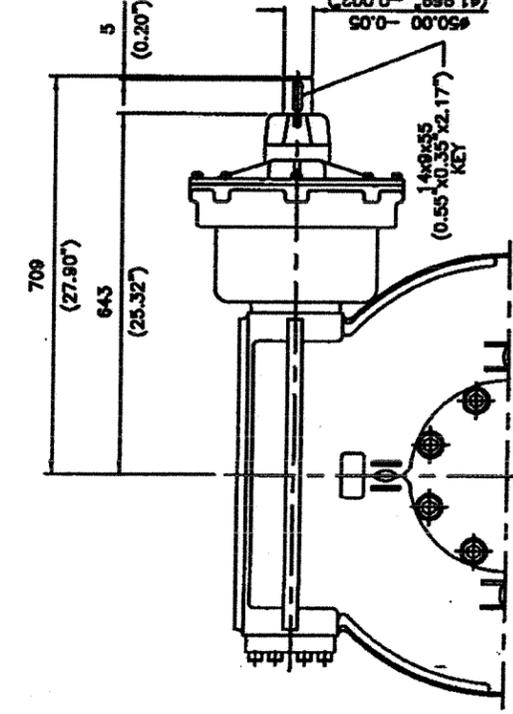

VIEW SHOWING  
MOTORISED UNIT

RATIOS 180, 240, 360,  
480, 540, 720, 960, 1080,  
1440, 2160, 2520 & 3000

INPUT FLANGE DETAILS (RATIO 60)				
FLANGE O/DIA.	SHAFT DIA.	RECESS DIA.	RECESS DEPTH	KEY DETAILS
ISO F26 #418 (#11.81")	#50.00 (#1.968")	#200.10 (#7.874")	5 (0.20")	14x8x100 (0.55"x0.35"x3.94")
FA26	#50.00 (#1.968")	#192.30 (#7.571")	5 (0.20")	14x8x100 (0.55"x0.35"x3.94")
ISO F30	#50.00 (#1.968")	#230.10 (#9.059")	5 (0.20")	14x8x100 (0.55"x0.35"x3.94")
ROTORK G30	#50.00 (#1.968")	#216.10 (#8.512")	5 (0.20")	14x8x100 (0.55"x0.35"x3.94")

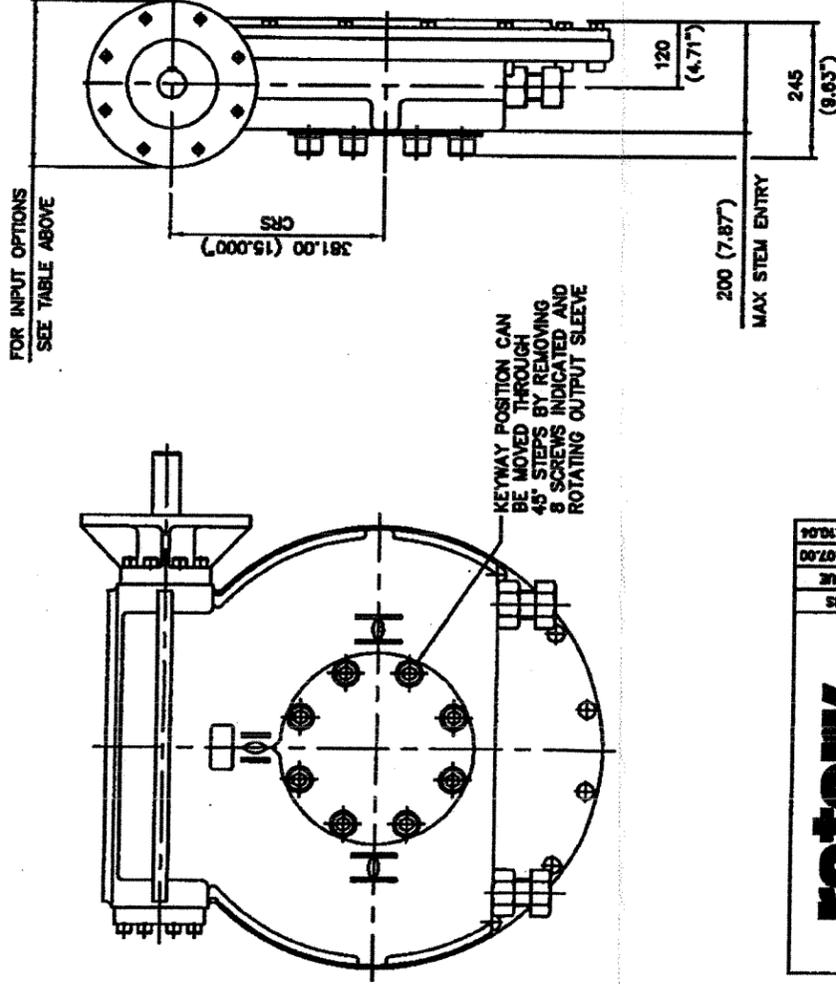

FOR INPUT OPTIONS  
SEE TABLE ABOVE

KEYWAY POSITION CAN  
BE MOVED THROUGH  
45° STEPS BY REMOVING  
8 SCREWS INDICATED AND  
ROTATING OUTPUT SLEEVE


200 (7.87")  
MAX STEM ENTRY

ISSUE	ALTERATIONS	DATE
1	ORIGINAL ISSUE	
2	CHANGED C/F 12.10.04	

**rotork  
gears**

VIEW SHOWING MOTORISED UNIT  
RATIO 60 ONLY

BASEPLATE DETAILS (ALL RATIOS) (ALTERNATIVES AVAILABLE ON REQUEST)	
ISO F40	HOLE DETAILS (22.5° OFF CENTRES)
F440	8 HOLES M36x36 (1.45") DEEP ON #406.0 (#15.98") P.C.
	8 HOLES 1.25"UNCx36 (1.45") DEEP ON #406.4 (#15.99") P.C.

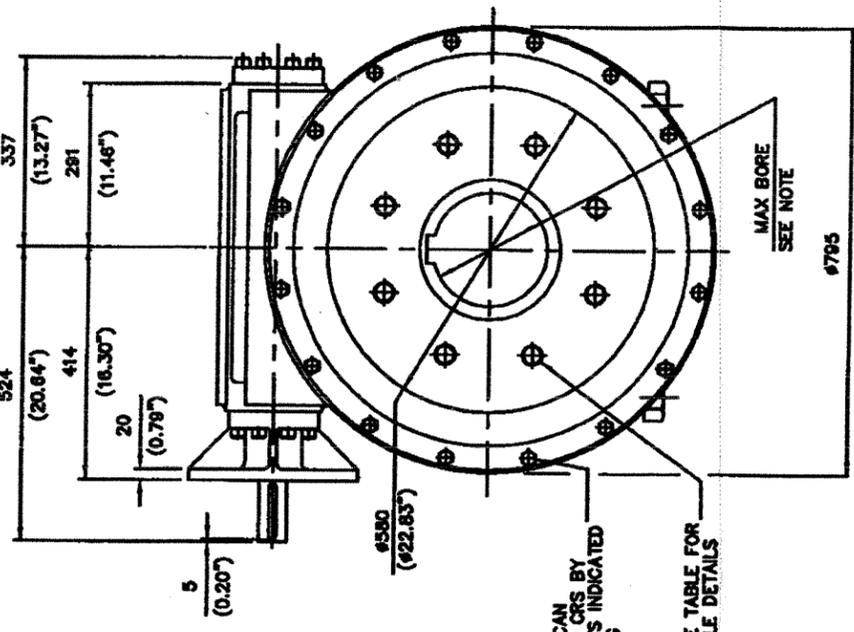

MOUNTING HOLES CAN  
BE POSITIONED ON CRS BY  
REMOVING 16 BOLTS INDICATED  
AND REPOSITIONING

SEE TABLE FOR  
HOLE DETAILS

524 (20.64")  
414 (16.30")  
20 (0.79")  
5 (0.20")  
337 (13.27")  
281 (11.46")  
6580 (#22.83")  
9795 (#31.30")  
MAX BORE  
SEE NOTE

Submission No.:	Project No.:	Checked:
1	2065-234-00	
Reviewed - No Comments	Reviewed - As Noted	Reviewed - Revises and Resubmits
Reviewed - As Noted	Reviewed - Revises and Resubmits	Reviewed by Consultant Not Required




DRAWN: S.M. 19.09.99  
OUTLINE DETAILS OF IW11  
& USA STANDARD  
PUB\IW11CD

For Garby  
for info only

Review is solely for general conformity with contract. The Consultant does not warrant or represent that information in this submittal is accurate or complete. Review does not relieve Contractor of responsibility for arrangements in designs, including this submittal, that are the Contractor's responsibility, and for conforming to all applicable codes, standards, specifications, and for selecting performance materials, methods, and performing the Work. Work between trades, and performing the Work safety. Notwithstanding this review, Contractor remains solely responsible for contract compliance.


By: *[Signature]* Date: Apr 24/09

IQ35 WITH OPTIONAL  
SIDE HANDWHEEL

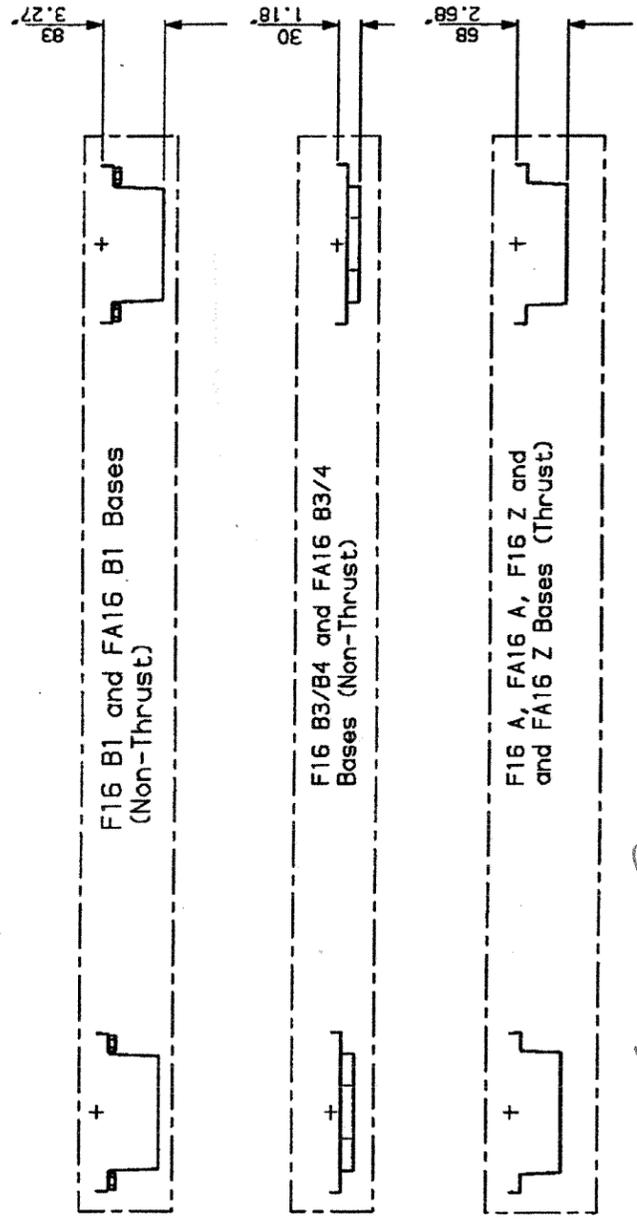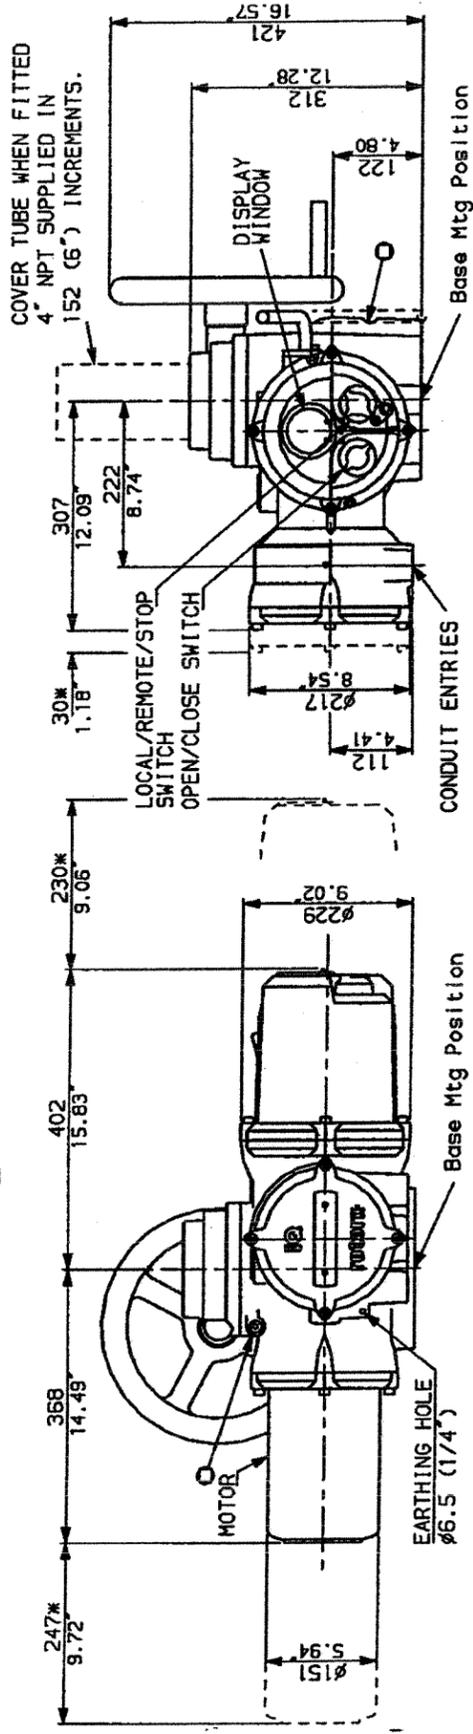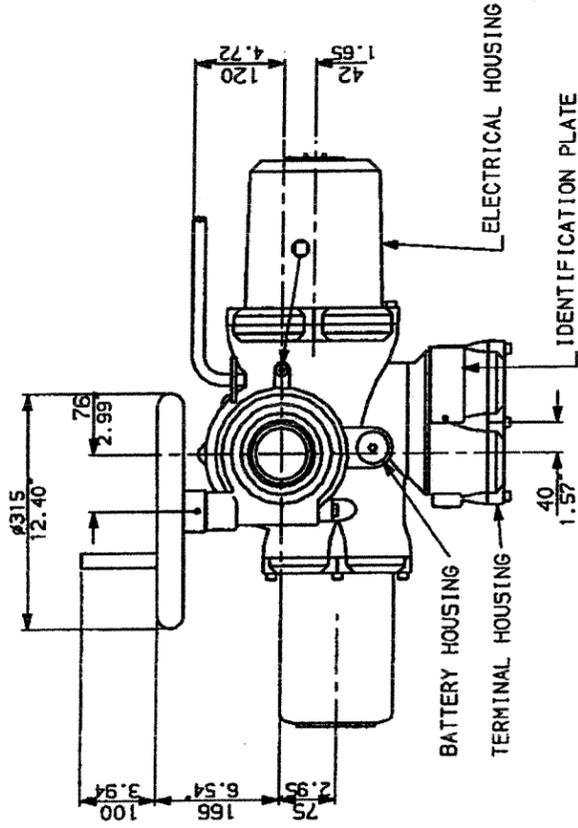

*Provide Remote Final Stop +  
Mounting Details*

CONDUIT ENTRIES

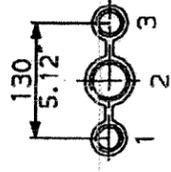

Nos. 1 & 3 TAPPED 1" NPT  
No. 2 TAPPED 1 1/2" NPT  
STANDARD ALTERNATIVES IF SPECIFIED  
2 X M25, 1 X M40  
2 X PG16, 1 X PG29

NOTES

Three BASE options are detailed to suit the relevant Coupling arrangement. The required BASE for the SIDE & END views should be loaded to position indicated.

Submission No.:	1	SUBMITTAL REVIEW	ACCOM
Project No.:	Discipline:		
Reviewed - No Comment	2065-234-00	Reviewed - Review and Resubmit	
Reviewed - As Noted		Reviewed by Consultant Not Required	

Review is solely for general conformity with contract. The Consultant does not warrant or represent that information in this submittal is accurate or complete. Review does not relieve Contractor of responsibility for errors/omissions in designs, including this submittal, that are the Contractor's responsibility, and for conforming/correlating with all quantities/dimensions, performing the Work, selecting performance means/methods, coordinating with other parts of the Work/between trades, and performing the Work safely. Notwithstanding this review, Contractor remains solely responsible for contract compliance.

By: *[Signature]* Date: *Apr 12 2009*

**rotork**

IQ35 (SHW) DATA

Date 011205 Scale 1:12


IQ\_355-3

**IQS20B4 WT actuator for existing IW11R1440 gearbox  
 (ON-OFF service)**

<b>Max. rating</b>	<b>actuator</b>	<b>100 Nm</b>	<b>74 Ft.lbs</b>
	<b>combination</b>	<b>57,154 Nm</b>	<b>42,180 Ft.lbs</b>
<b>Weight</b>	<b>actuator</b>	<b>46 Kg</b>	<b>101 lbs</b>
	<b>combination</b>	<b>350 Kg</b>	<b>775 lbs</b>
<b>Actuator speed</b>		<b>86 RPM</b>	
<b>Operating time (combination)</b>		<b>250 seconds</b>	
<b>Max. bore</b>	<b>actuator</b>	<b>30 mm</b>	<b>1-1/4"</b>
	<b>gearbox</b>	<b>203 mm</b>	<b>8"</b>
<b>Voltage</b>		<b>230 V / 1 ph / 60 Hz</b>	
<b>Wiring diagram</b>		<b>3001-000</b>	
<b>Amperage</b>	<b>rated torque</b>	<b>7.2 Amps</b>	
	<b>locked rotor</b>	<b>22 Amps</b>	

Submission No. :	<b>SUBMITTAL REVIEW</b>		AECOM
Project No. :	D265-234-00		
	Discipline :		
<input checked="" type="checkbox"/>	Reviewed - No Comment	Reviewed - Revise and Resubmit	
<input type="checkbox"/>	Reviewed - As Noted	Review by Consultant Not Required	
<p>Review is solely for general conformity with contract. The Consultant does not warrant or represent that information in this submittal is accurate or complete. Review does not relieve Contractor of responsibility for errors/omissions in designs, including this submittal, that are the Contractor's responsibility, and for conforming/correlating with all quantities/dimensions, performing the Work, selecting performance means/methods, coordinating with other parts of the Work/between trades, and performing the Work safely. Notwithstanding this review, Contractor remains solely responsible for contract compliance.</p>			
By :	_____ - 27		Date : APR 24/09



# IQ20-25 WITH OPTIONAL SIDE HANDWHEEL

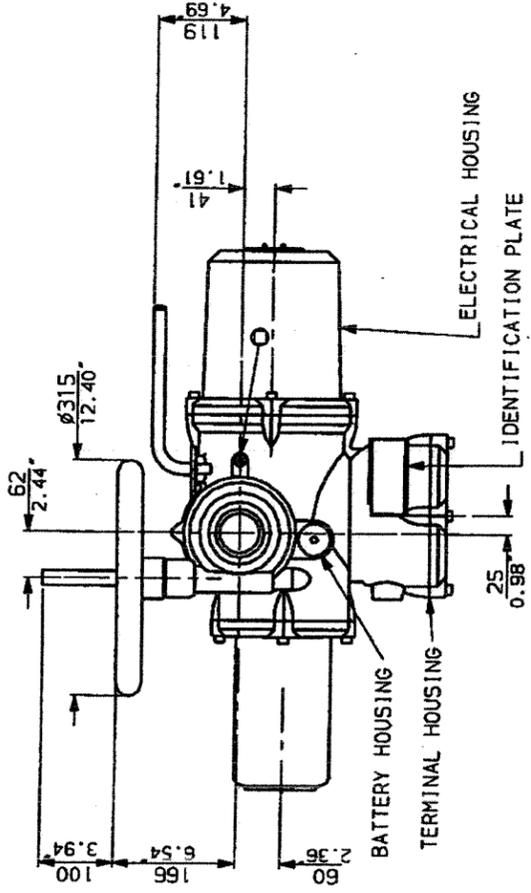


Submission No.:	<b>SUBMITTAL REVIEW</b>		AECOM
Project No.:	Discipline:		
D265-234-00			
Reviewed - No Comment	Reviewed - Revise and Resubmit		
Reviewed - As Noted	Reviewed by Consultant Not Required		

Review is solely for general conformity with contract. The Consultant does not warrant or represent that information in this submittal is accurate or complete. Review does not relieve Contractor of responsibility for errors/omissions in design, including this submittal, that are the Contractor's responsibility, and for conforming/coordinating with all quantified dimensions, performing the Work, selecting performance means/methods, coordinating with other parts of the Work/between trades, and performing the Work safely. Notwithstanding this review, Contractor remains solely responsible for contract compliance.


By: *[Signature]* Date: *Nrc 24/09*

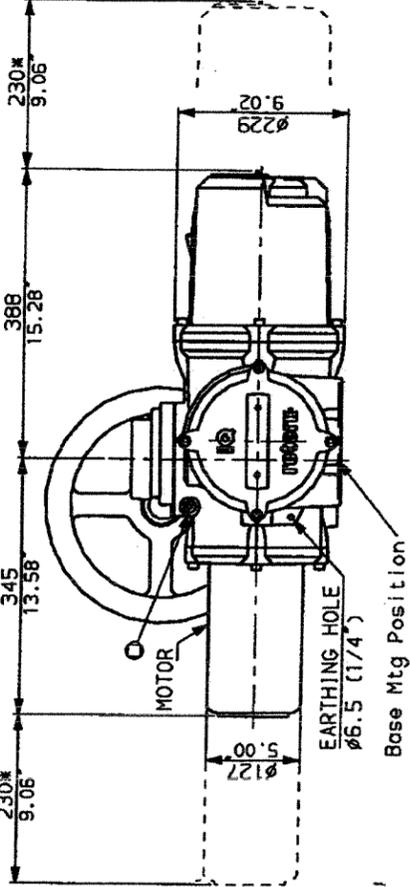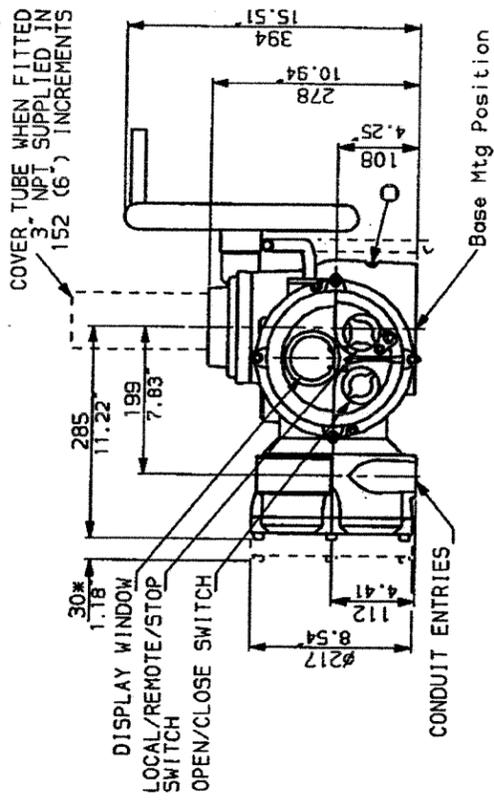

*Provide Remote Hand Start + remote Stop.*

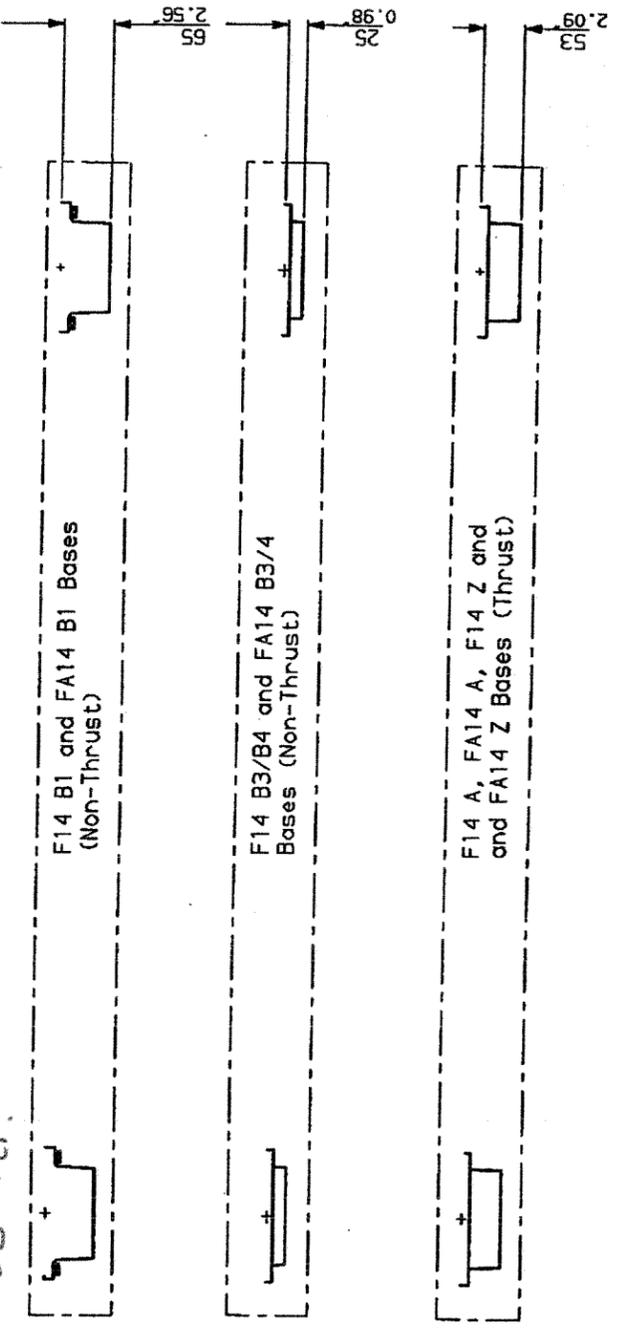

**CONDUIT ENTRIES**

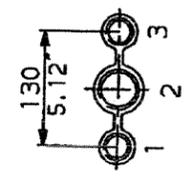

Nos. 1 & 3 TAPPED 1" NPT  
No. 2 TAPPED 1 1/2" NPT  
STANDARD ALTERNATIVES IF SPECIFIED  
2 X M25, 1 X M40  
2 X PG16, 1 X PG29

**NOTES**

Three BASE options are detailed to suit the relevant Coupling arrangement. The required BASE for the SIDE & END views should be loaded to position indicated.

**rotork**  
Rotork Controls Ltd.  
Bath, England BA1 3JQ  
Bath, (01225) 733200

**IQ20 (SHW) DATA**  
Date 090500 Scale 1:12

**IQ\_20S-2**

Submission No.:	SUBMITTAL REVIEW	ASCOM
Project No.:	Discipline:	
D265-234-00	Reviewed - Review and Resubmit	
Reviewed - No Comment	Reviewed - As Noted	
Reviewed - As Noted	Reviewed by Consultant Not Required	
<p>Review is solely for general conformity with contract. The Consultant does not warrant or represent that information in this submittal is accurate or complete. Review does not relieve Contractor of responsibility for errors/omissions in designs, including this submittal, that are the Contractor's responsibility, and for conforming/controlling with all quantities/dimensions, performing the Work, selecting performance measurement methods, coordinating with other parts of the Work between trades, and performing the Work safely. Notwithstanding this review, Contractor remains solely responsible for contract compliance.</p>		
By: <i>[Signature]</i>	Date: <i>Apr 20, 2019</i>	




*NKO only*  
*Goodbox Ex-isting*

MAX BORE SQ KEY	
STD BORE KEY	
BS4235	
BS46	
ANSI B17.1.7.3/5" 1.3/4"-SQ	

MAX BORE RECTANGULAR KEY	
STD BORE KEY	
BS4235	203.0 50 x 28
BS46	7.625" 2" x 1.3/8"
ANSI B17.1.7.3/25" 2" x 1.1/2"	

VIEW SHOWING HAND OPERATED UNIT  
RATIOS 180, 240, 360, 480, 540, 720  
960, 1080, 2160, 2520 & 3000


INPUT FLANGE DETAILS (RATIOS 180 TO 3000)				
FLANGE O/DIA	SHAFT DIA	RECESS DIA	RECESS DEPTH	KEY DETAILS
ISO F10	#125 (#4.921)	#70.05 +0.15 (#2.758" +0.006")	4 (0.16")	4 HOLES #10.5 (#0.411") ON #102.0 (#4.027") P.C.
FA10	#125 (#4.921)	#68.70 +0.15 (#2.311" +0.006")	4 (0.16")	4 HOLES #10.5 (#0.411") ON #102.0 (#4.027") P.C.
ISO F14	#175 (#6.887)	#100.05 +0.15 (#3.939" +0.006")	8 (0.20")	4 HOLES #11.5 (#0.453") ON #140.0 (#5.511") P.C.
FA14	#175 (#6.887)	#98.25 +0.15 (#3.790" +0.006")	8 (0.20")	4 HOLES #11.5 (#0.453") ON #140.0 (#5.511") P.C.
ISO F16	#210 (#8.271)	#130.05 +0.15 (#5.120" +0.006")	8 (0.20")	4 HOLES #12.5 (#0.491") ON #165.0 (#6.500") P.C.
FA16	#210 (#8.271)	#128.52 +0.15 (#4.997" +0.007")	8 (0.20")	4 HOLES #12.5 (#0.491") ON #165.0 (#6.500") P.C.
ISO F20	#300 (#11.811)	#200.10 +0.10 (#7.878" +0.004")	8 (0.20")	6 HOLES #15.5 (#0.610") ON #250.0 (#9.842") P.C.
FA20	#300 (#11.811)	#198.30 +0.10 (#7.807" +0.004")	8 (0.20")	6 HOLES #15.5 (#0.610") ON #250.0 (#9.842") P.C.

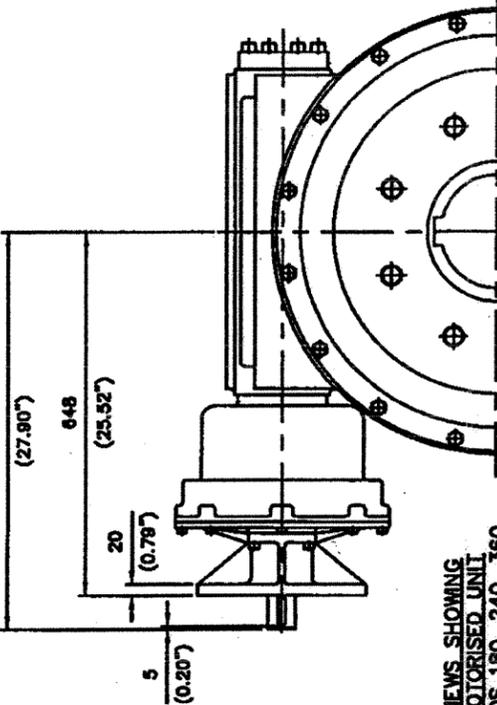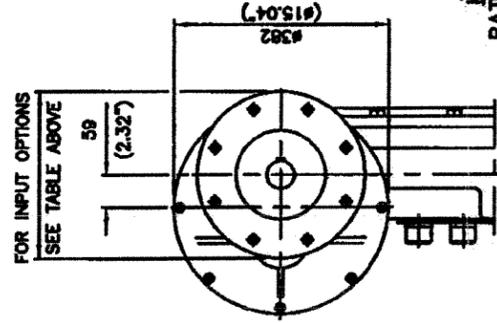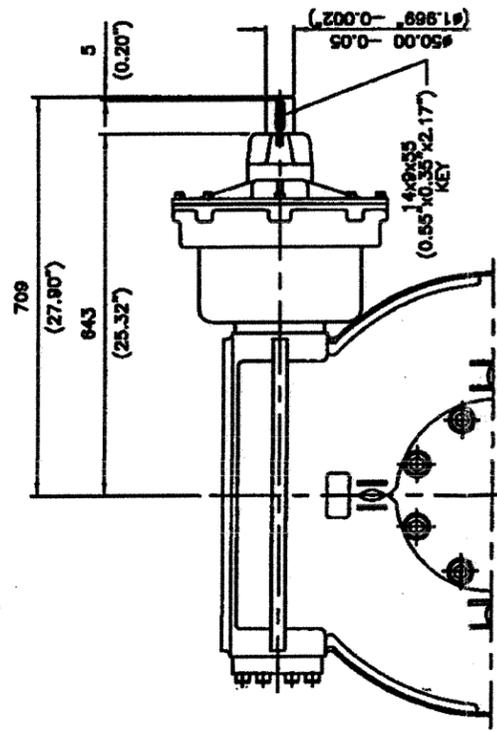



VIEW SHOWING  
MOTORISED UNIT  
RATIOS 180, 240, 360,  
480, 540, 720, 960, 1080,  
1440, 2160, 2520 & 3000

INPUT FLANGE DETAILS (RATIO 60)				
FLANGE O/DIA	SHAFT DIA	RECESS DIA	RECESS DEPTH	KEY DETAILS
ISO F20	#300 (#11.811)	#200.10 +0.05 (#7.878" +0.002")	8 (0.20")	6 HOLES #15.5 (#0.610") ON #250.0 (#9.842") P.C.
FA20	#300 (#11.811)	#198.30 +0.05 (#7.807" +0.002")	8 (0.20")	6 HOLES #15.5 (#0.610") ON #250.0 (#9.842") P.C.
ISO F30	#450 (#13.779)	#300.10 +0.10 (#11.811" +0.004")	8 (0.20")	6 HOLES #20.5 (#0.807") ON #350.0 (#13.779") P.C.
ROTORK 630	#418 (#16.461)	#288.10 +0.10 (#11.343" +0.004")	8 (0.20")	6 HOLES #20.5 (#0.807") ON #350.0 (#13.779") P.C.

BASEPLATE DETAILS (ALL RATIOS) (ALTERNATIVES AVAILABLE ON REQUEST)	
ISO F40	8 HOLES MORSE 36 (1.45") DEEP ON #400.0 (#15.748") P.C.
FA40	8 HOLES 1.25" UNCL 36 (1.45") DEEP ON #400.0 (#15.748") P.C.

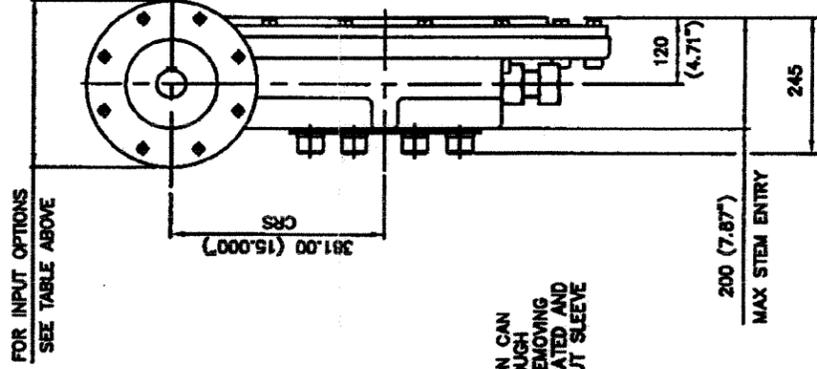

FOR INPUT OPTIONS  
SEE TABLE ABOVE

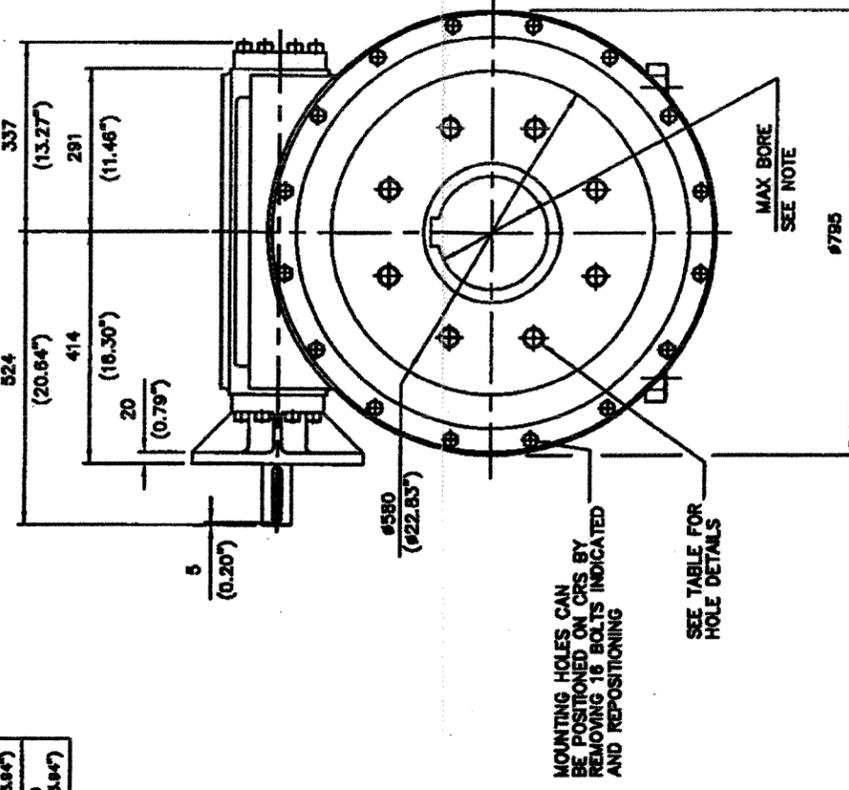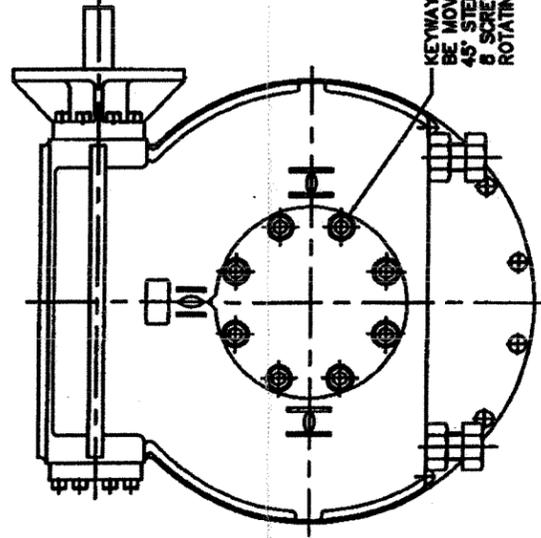

MOUNTING HOLES CAN BE POSITIONED ON CRS BY REMOVING 16 BOLTS INDICATED AND REPOSITIONING

SEE TABLE FOR HOLE DETAILS

MAX BORE  
SEE NOTE

#785  
(#31.30")


VIEW SHOWING MOTORISED UNIT  
RATIO 60 ONLY



DRAWN: S.W. 19.9.96  
CHECKED:

OUTLINE DETAILS OF IW11  
ISO & USA STANDARD

PUB\IW11CD

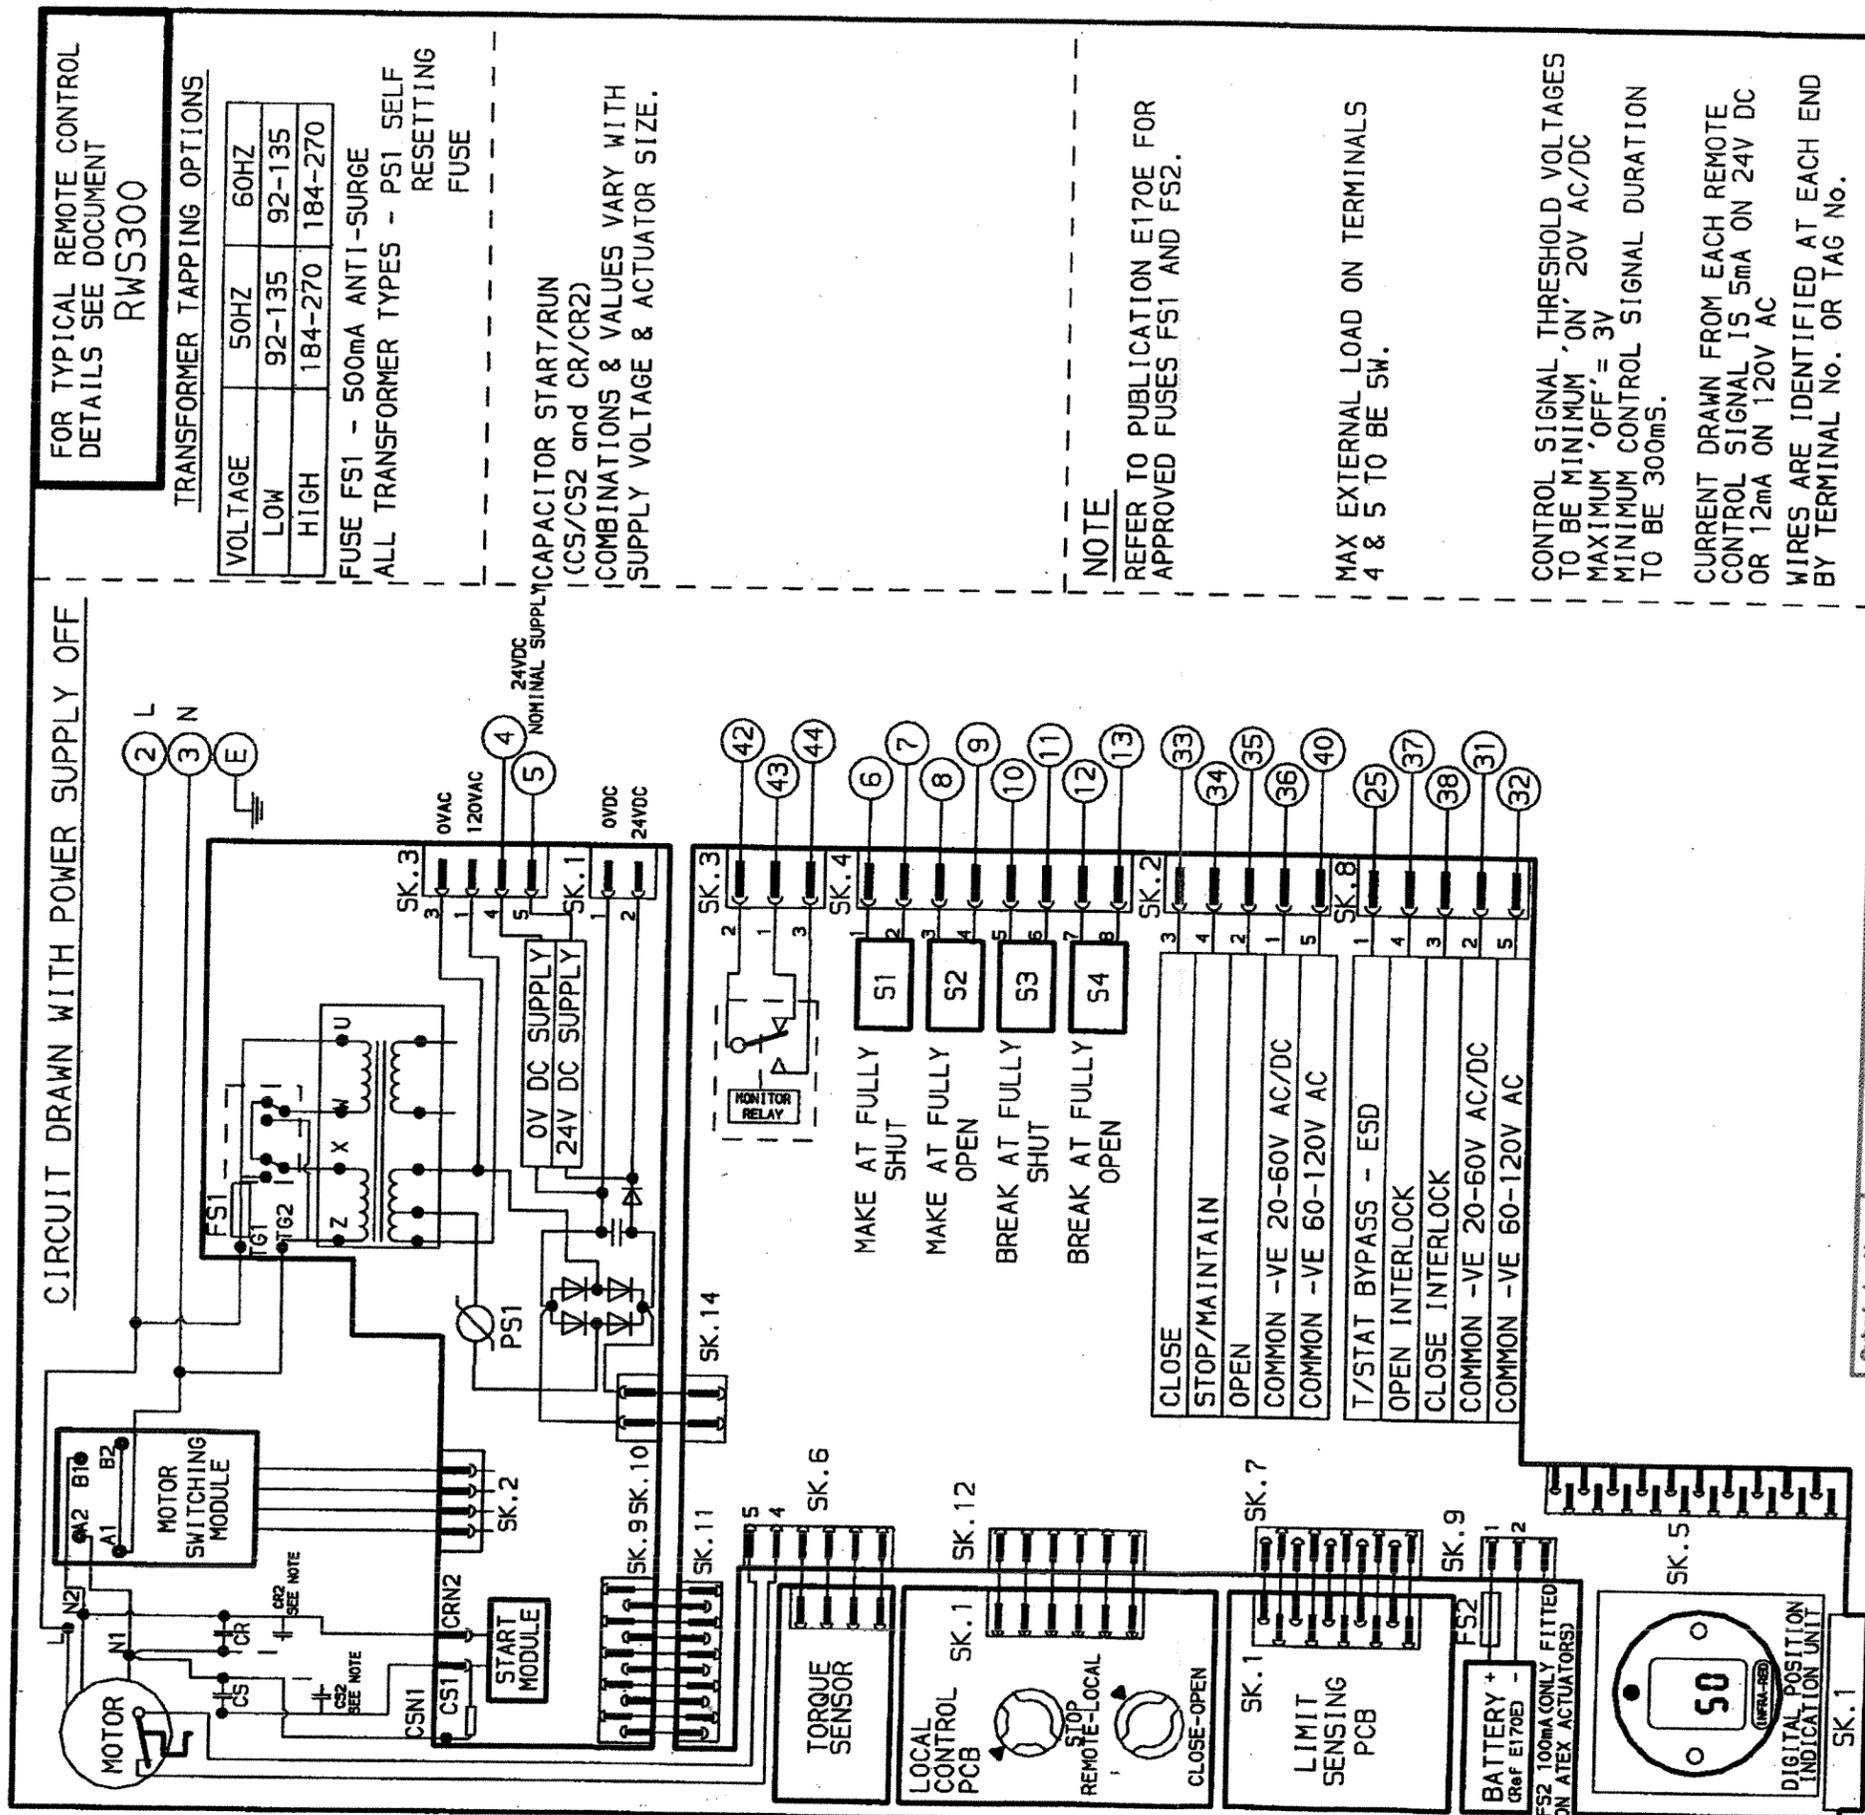

FOR TYPICAL REMOTE CONTROL  
DETAILS SEE DOCUMENT  
**RWS300**

**TRANSFORMER TAPPING OPTIONS**

VOLTAGE	50HZ	60HZ
LOW	92-135	92-135
HIGH	184-270	184-270

FUSE FS1 - 500mA ANTI-SURGE  
ALL TRANSFORMER TYPES - PS1 SELF  
RESETTING  
FUSE

CAPACITOR START/RUN  
(CS/CS2 and CR/CR2)  
COMBINATIONS & VALUES VARY WITH  
SUPPLY VOLTAGE & ACTUATOR SIZE.

**NOTE**  
REFER TO PUBLICATION E170E FOR  
APPROVED FUSES FS1 AND FS2.

MAX EXTERNAL LOAD ON TERMINALS  
4 & 5 TO BE 5W.

CONTROL SIGNAL THRESHOLD VOLTAGES  
TO BE MINIMUM 'ON' 20V AC/DC  
MAXIMUM 'OFF' = 3V  
MINIMUM CONTROL SIGNAL DURATION  
TO BE 300ms.

CURRENT DRAWN FROM EACH REMOTE  
CONTROL SIGNAL IS 5mA ON 24V DC  
OR 12mA ON 120V AC  
WIRES ARE IDENTIFIED AT EACH END  
BY TERMINAL No. OR TAG No.

INDICATION CONTACTS S1-S4 ARE SHOWN  
IN THEIR DEFAULT CONFIGURATION.  
CONTACTS MAY BE CONFIGURED FOR ANY  
OF THE FUNCTIONS DESCRIBED IN E170E

Submission No.:	<b>1</b>		<b>SUBMITTAL REVIEW</b>	AECOM
Project No.:	D865-234-00		Discipline:	
Reviewed - No Comment	<input checked="" type="checkbox"/>	Reviewed - Revise and Resubmit	<input type="checkbox"/>	
Reviewed - As Noted	<input type="checkbox"/>	Reviewed by Consultant Not Required	<input type="checkbox"/>	
<p>Review is solely for general conformity with contract. The Consultant does not warrant or represent that information in this submittal is accurate or complete. Review does not relieve Contractor of responsibility for errors/omissions in designs, including this submittal, that are the Contractor's responsibility, and for conforming/coordinating with all quantities/dimensions, performing the Work, selecting performance means/methods, coordinating with other parts of the Work/between trades, and performing the Work safely. Notwithstanding this review, Contractor remains solely responsible for contract compliance.</p>				
By:	B. Hoar	Date:	Apr 24/09	

No	06
DATE	30/10/04
REVISION DETAILS	
DIAGRAM RE-FORMATTED TO SEPARATE REMOTE CONTROL CIRCUITRY (See 'RWS' Ref)	

**www.rotork.com**

ROTORK CONTROLS LTD  
BATH, BA1 3JG  
ENGLAND

ROTORK CONTROLS INC  
ROCHESTER  
NY 14624, USA

Tel: 01225-733200  
Tel: 585-328-1550

CONFIG BY	PRE
DATE	081004
CHECKED	PJW
BASE WD	--
JOB No	--
M.I.No	--


IQ  
SINGLE PHASE  
CIRCUIT DIAGRAM No -REV 102  
**3001-000-06**  
B1 C1 B2 C2

**IQ20B4 WT actuator c/w IW9R960 gearbox  
(ON-OFF service)**



<b>Max. rating</b>	<b>actuator</b>	<b>142 Nm</b>	<b>105 Ft.lbs</b>
	<b>combination</b>	<b>54,065 Nm</b>	<b>39,900 Ft.lbs</b>
<b>Weight</b>	<b>actuator</b>	<b>46 Kg</b>	<b>101 lbs</b>
	<b>combination</b>	<b>342 Kg</b>	<b>752 lbs</b>
<b>Actuator speed</b>		<b>115 RPM</b>	
<b>Operating time (combination)</b>		<b>125 seconds</b>	
<b>Max. bore</b>	<b>actuator</b>	<b>30 mm</b>	<b>1-1/4"</b>
	<b>gearbox</b>	<b>178 mm</b>	<b>7"</b>
<b>Voltage</b>		<b>575 V / 3 ph / 60 Hz</b>	
<b>Wiring diagram</b>		<b>3000-000</b>	
<b>Amperage</b>	<b>rated torque</b>	<b>3.8 Amps</b>	
	<b>locked rotor</b>	<b>15.5 Amps</b>	
<b>Gearbox ratio</b>		<b>960</b>	
<b>mech. advantage</b>		<b>380</b>	
<b>Gearbox paint</b>		<b>two coats polyamide epoxy paint Amerlock 400</b>	

PROVIDE ACTUATOR MOUNTING DETAILS INCL  
ADAPTER PLATES, INPUT & OUTPUT SHAFT DIA'S

Submission No. : 1	<b>SUBMITTAL REVIEW</b>		AECOM
Project No. : D265-234-00	Discipline :		
<input checked="" type="checkbox"/> Reviewed - No Comment	<input type="checkbox"/> Reviewed - Revise and Resubmit		
<input checked="" type="checkbox"/> Reviewed - As Noted	<input type="checkbox"/> Review by Consultant Not Required		
<p>Review is solely for general conformity with contract. The Consultant does not warrant or represent that information in this submittal is accurate or complete. Review does not relieve Contractor of responsibility for errors/omissions in designs, including this submittal, that are the Contractor's responsibility, and for conforming/correlating with all quantities/dimensions, performing the Work, selecting performance means/methods, coordinating with other parts of the Work/between trades, and performing the Work safely. Notwithstanding this review, Contractor remains solely responsible for contract compliance.</p>			

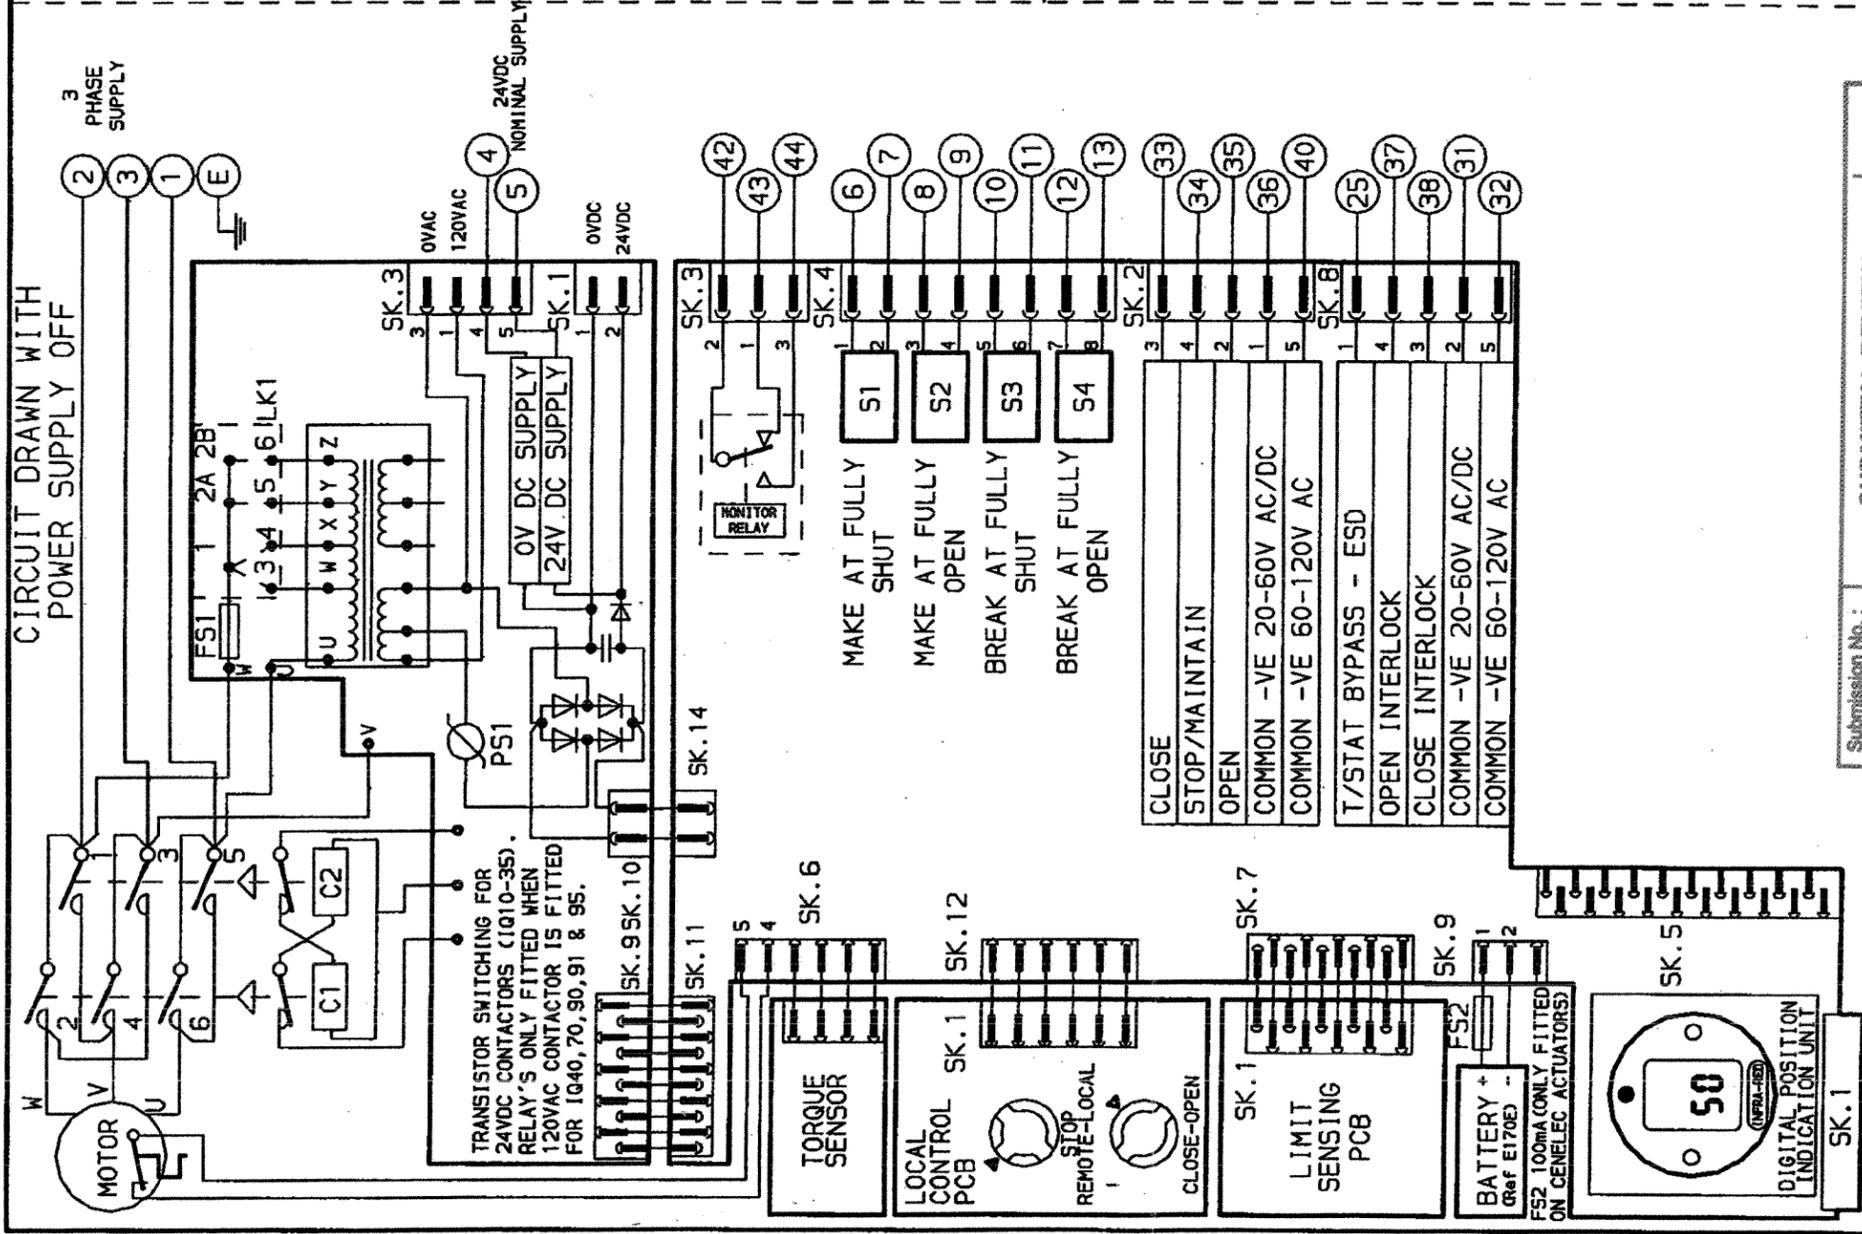


G  
F  
E  
D  
A

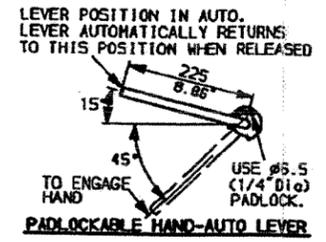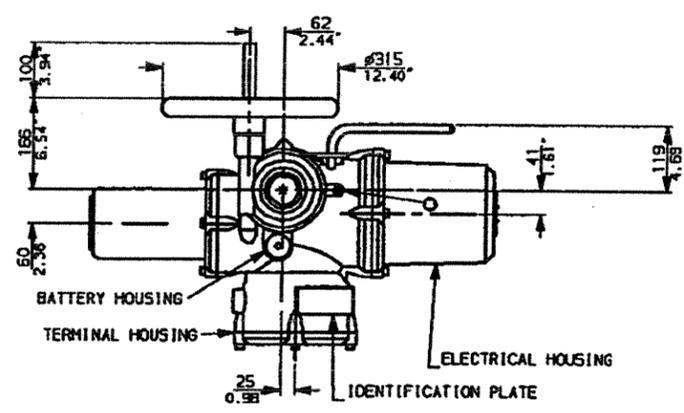



NOTES:  
 DIMENSIONS WITH 'x' INDICATE COVER REMOVAL ALLOWANCE  
 NETT WEIGHT = 342kg (752lbs)  
 O = OIL FILLER/DRAIN PLUG  
 THE INTERFACE PROVIDED FOR MOUNTING THE ACTUATOR OR SECOND STAGE GEARBOX ONTO THE VALVE SHOULD CONFORM TO GOOD ENGINEERING PRACTICES, ENSURING ADEQUATELY TOLERANCED LIMITS FOR PARALLELISM, PERPENDICULARITY AND CONCENTRICITY.

CONDUIT ENTRIES (N.T.S)

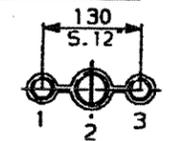


Nos.1 & 3 TAPPED 1" NPT  
 No.2 TAPPED 1 1/2" NPT  
 STD ALTERNATIVES IF SPECIFIED  
 2 X M25, 1 X M40  
 2 X PG16, 1 X PG29

316SS Valve Position Indicator  
 to be fabricated by Mueller Flow Control

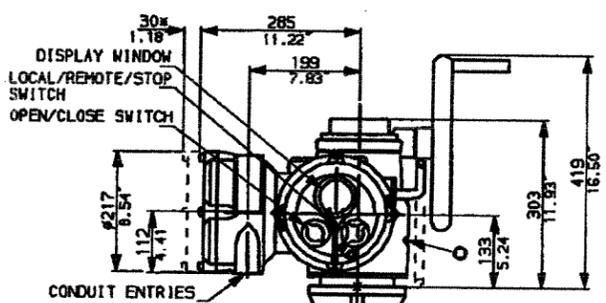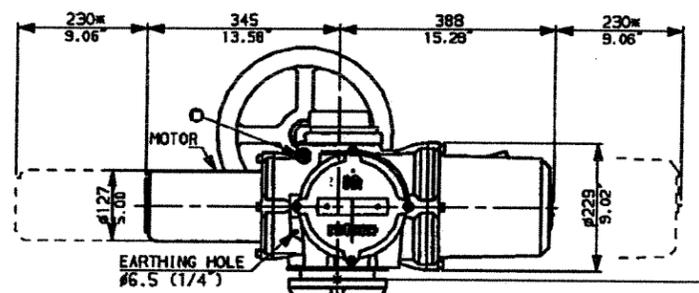

*ORIENTATION OF ACTUATOR ON GEARBOX TO BE CONFIRMED*

N.B. KEYWAY POS. CAN BE MOVED IN 45° STEPS BY REMOVING 8 SCREWS MARKED (A) AND ROTATING OUTPUT SLEEVE.

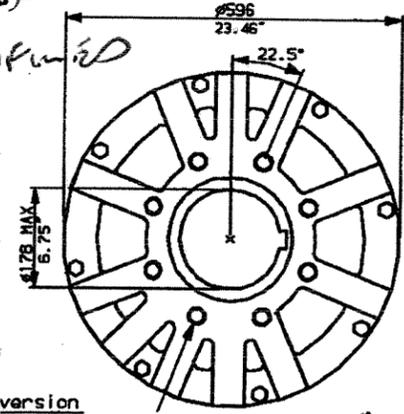

"F" version  
 8 HOLES TAPPED M20 x 30 DP  
 EQUI-SPACED AS SHOWN ON A  
 298 PCD (ISO 5211-F30).

"FA" version  
 8 HOLES TAPPED 3/4"UNCx1.18"dp  
 EQUI-SPACED AS SHOWN ON A  
 11.75" PCD (MSS SP101-FA30).

*CONFIRM  
 EX SHAFT DIA'S +  
 KEY PER TO  
 FAB.*

Submission No.:	SUBMITTAL REVIEW		AECOM
Project No.:	D265-234-00		
Discipline:			
Reviewed - No Comment	<input checked="" type="checkbox"/>	Reviewed - Revise and Resubmit	
Reviewed - As Noted	<input type="checkbox"/>	Review by Consultant Not Required	
Review is solely for general conformity with contract. The Consultant does not warrant or represent that information in this submittal is accurate or complete. Review does not relieve Contractor of responsibility for errors/omissions in design, including this submittal, that are the Contractor's responsibility, and for conforming/complaining with all quantities/dimensions, performing the Work, selecting performance means/methods, coordinating with other parts of the Work/between trades, and performing the Work safely. Notwithstanding this review, Contractor remains solely responsible for contract compliance.			
By:	<i>[Signature]</i>	Date:	<i>April 24/09</i>

**rotork**  
 www.rotork.com  
 Rotork Controls Ltd.  
 Bath England, BA1 3JQ.  
 (Phone 01225-733200)  
 Rotork Controls Inc.  
 Rochester, NY 14624  
 (Phone 585-328-1550)





Title IQ20, 25 (+IQ520), SHW, IW (MOW) 9RH,			
STANDARD DIMENSIONAL DATA			
Drawn CAD	Checked PRE	Ref Data Sheet	
Date April 04	Job No IQ2SHW_IW9RH		

NOTE:  
 Gearbox is shown with HIGH Ratio Input Reducer.  
 (ie Ratios 960, 1080, 1440, 2160, 2520, 3000)  
 See Data Sheet with IW9RL for LOW ratio option.

01	First Issue.
Scale	1:8 THIRD ANGLE PROJECTION
Drawing Number	1 IQ2SHW_IW9RH

1 | 2 | 3 | 4 | 5 | 6 | 7 | 8 | 9 | 10


# IQ20-25 WITH OPTIONAL SIDE HANDWHEEL

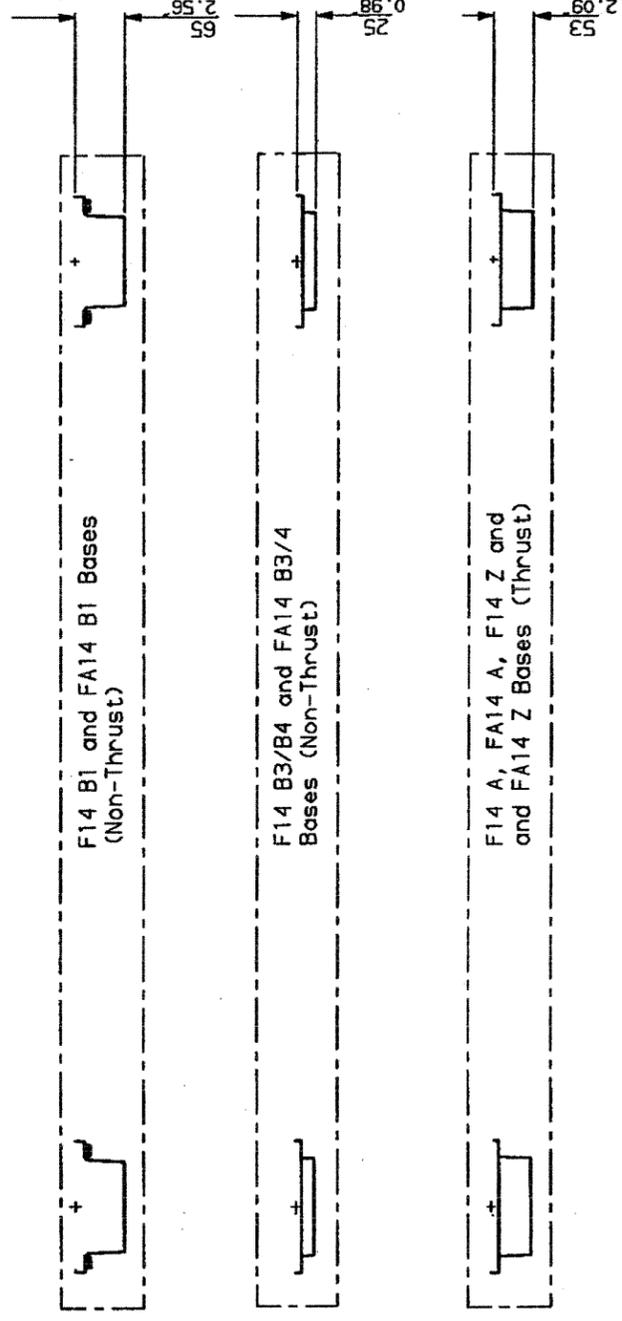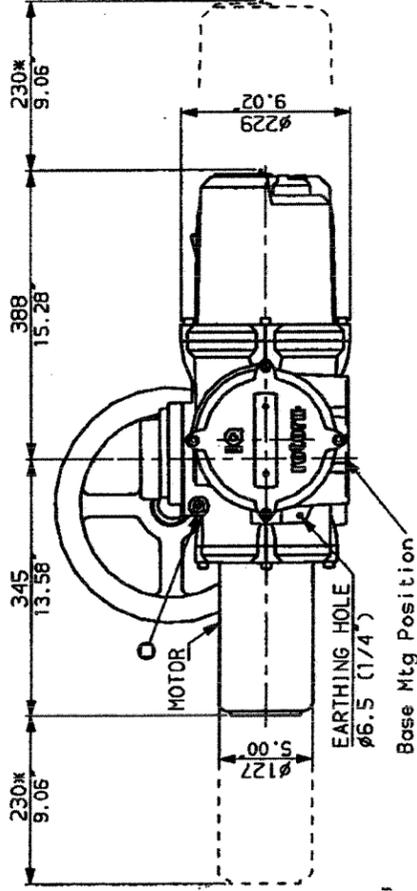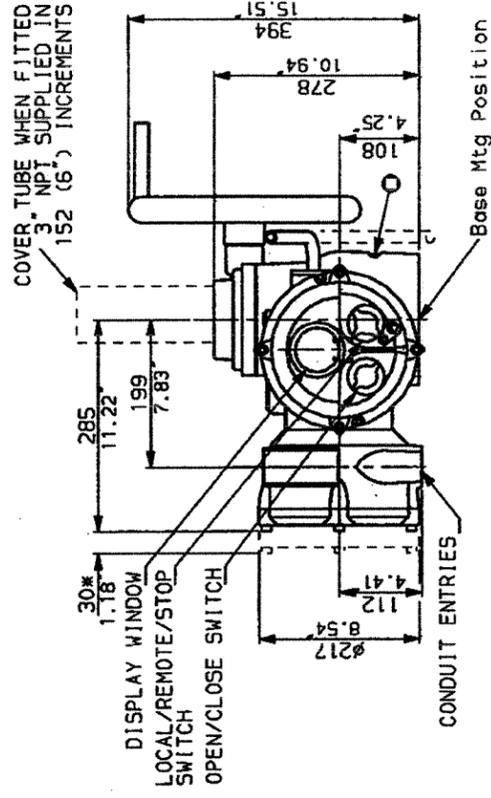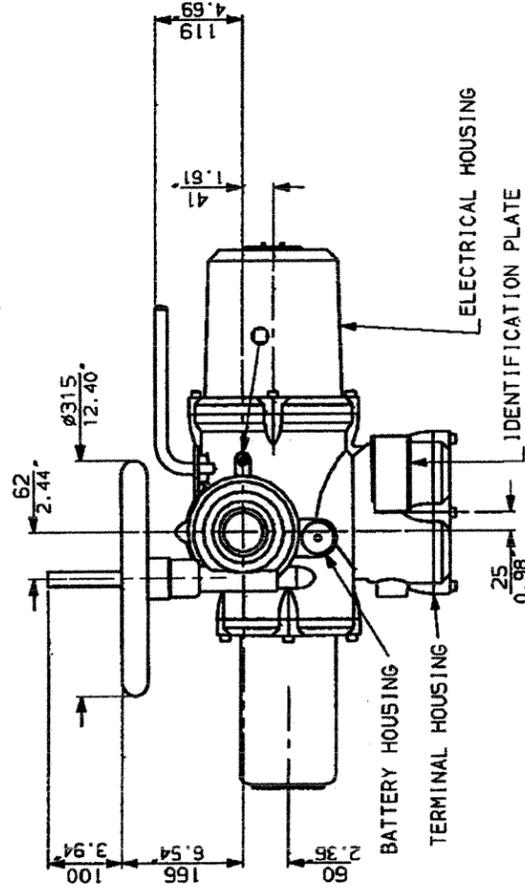

**NOTES**

Three BASE options are detailed to suit the relevant Coupling arrangement. The required BASE for the SIDE & END views should be loaded to position indicated.

**CONDUIT ENTRIES**

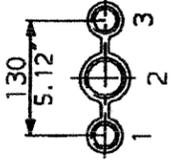

Nos. 1 & 3 TAPPED 1" NPT  
 No. 2 TAPPED 1 1/2" NPT  
 STANDARD ALTERNATIVES IF SPECIFIED  
 2 X M25, 1 X M40  
 2 X PG16, 1 X PG29

Submission No.:	SUBMITTAL REVIEW	ACCOM
Project No.:	Discipline:	
D365-234-00		
Reviewed - No Comment	Reviewed - Revise and Resubmit	
Reviewed - As Noted	Reviewed by Consultant Not Required	

Review is solely for general conformity with contract. The Consultant does not warrant or represent that information in this submittal is accurate or complete. Review does not relieve Contractor of responsibility for omissions in designs, including this submittal, that are the Contractor's responsibility, and for conforming/complaining with all quantities/dimensions, performing the Work, selecting performance measurement methods, coordinating with other parts of the Work/between trades, and performing the Work safely. Notwithstanding this review, Contractor remains solely responsible for contract compliance.

By: *[Signature]* Date: *Apr 2019*

**rotork**  
 Rotork Controls Ltd.  
 Bath, England BA1 3JG  
 Bath (01225) 733200

**IQ20 (SHW) DATA**


Date 090500 Scale 1:12

IQ-205-2

Submission No.:	SUBMITTAL REVIEW		AECOM
Project No.:	Discipline:		
D265-234-00			
Reviewed - No Comment	Reviewed - Revise and Resubmit		
Reviewed - As Noted	Reviewed by Consultant Not Required		
<p>Review is solely for general conformity with contract. The Consultant does not warrant or represent that information in this submittal is accurate or complete. Review does not relieve Contractor of responsibility for errors/omissions in designs, including this submittal, that are the Contractor's responsibility, and for contacting/completing with all quantities/dimensions, performing the Work, selecting performance methods, coordinating with other parts of the Work/between trades, and performing the Work safely. Notwithstanding this review, Contractor remains solely responsible for contract compliance.</p>			
By:	<i>[Signature]</i>	Date:	APR 24/09



INPUT FLANGE DETAILS (RATIOS 180 TO 3000)						
FLANGE O/DIA.	SHAFT DIA.	RECESS DIA.	RECESS DEPTH	HOLE DETAILS (OFF CENTRES)	KEY DETAILS	
ISO F10 #125 (#4.92)	#50.00 (#1.57)	#75.06 (#2.76)	+0.15 (+0.005)	4 (0.16)	4 HOLES #10.5 (#0.41) ON #102.0 (#4.02) P.C.	6x6x40 (0.24"x0.39"x1.57)
FA10 #125 (#4.92)	#50.00 (#1.57)	#65.70 (#2.31)	+0.15 (+0.005)	4 (0.16)	4 HOLES #10.5 (#0.41) ON #102.0 (#4.02) P.C.	6x6x40 (0.24"x0.39"x1.57)
ISO F14 #175 (#6.89)	#63.00 (#1.98)	#100.05 (#3.93)	+0.15 (+0.005)	5 (0.20)	5 HOLES #16.5 (#0.65) ON #140.0 (#5.51) P.C.	8x7x55 (0.31"x0.39"x2.17)
FA14 #175 (#6.89)	#63.00 (#1.98)	#90.25 (#3.75)	+0.15 (+0.005)	5 (0.20)	5 HOLES #16.5 (#0.65) ON #140.0 (#5.51) P.C.	8x7x55 (0.31"x0.39"x2.17)
ISO F16 #210 (#8.27)	#84.00 (#2.59)	#130.05 (#4.92)	+0.15 (+0.005)	5 (0.20)	5 HOLES #20.5 (#0.81) ON #165.0 (#6.50) P.C.	12x8x65 (0.47"x0.31"x2.17)
FA16 #210 (#8.27)	#84.00 (#2.59)	#120.82 (#4.79)	+0.15 (+0.007)	5 (0.20)	5 HOLES #20.5 (#0.81) ON #165.0 (#6.50) P.C.	12x8x65 (0.47"x0.31"x2.17)
ISO F25 #300 (#11.81)	#120.00 (#3.69)	#200.10 (#7.87)	+0.10 (+0.004)	5 (0.20)	5 HOLES #18.5 (#0.73) ON #254.0 (#10.00) P.C.	14x8x85 (0.55"x0.35"x3.94)
FA25 #300 (#11.81)	#120.00 (#3.69)	#192.30 (#6.98)	+0.17 (+0.007)	5 (0.20)	5 HOLES #18.5 (#0.73) ON #254.0 (#10.00) P.C.	14x8x85 (0.55"x0.35"x3.94)

VIEW SHOWING  
HAND OPERATED UNIT  
RATIOS 950, 1080, 1440,  
2160, 2520 & 3000

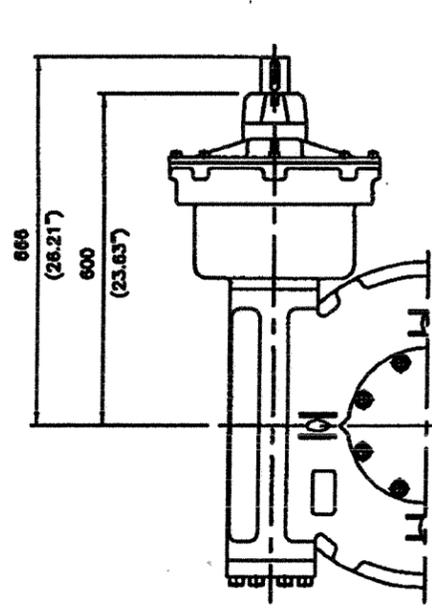


FOR INPUT OPTIONS  
SEE TABLE ABOVE

IEWS SHOWING  
MOTORISED UNIT  
RATIOS 950, 1080, 1440,  
2160, 2520 & 3000

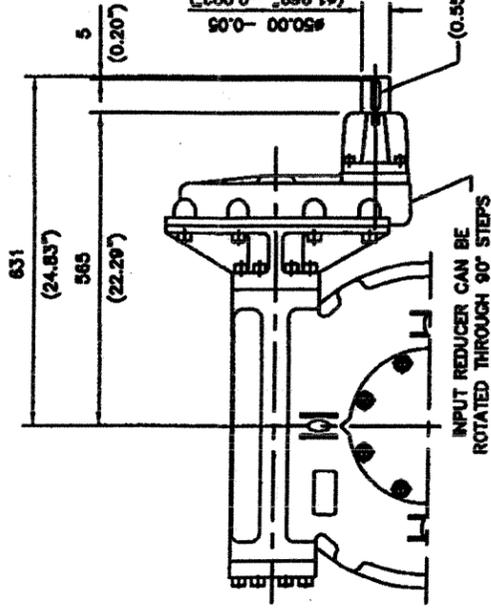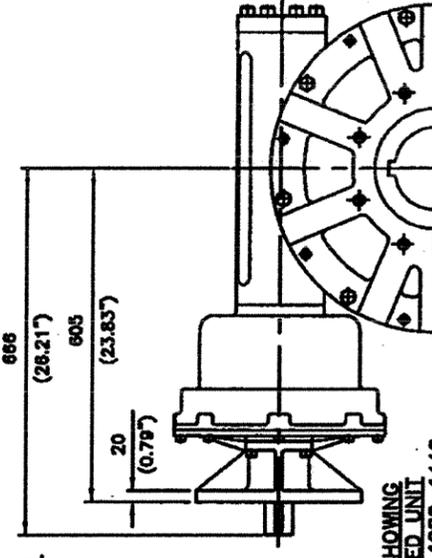


VIEW SHOWING  
HAND OPERATED UNIT  
RATIOS 180, 240, 360, 480, 540 & 720

FOR INPUT OPTIONS  
SEE TABLE ABOVE

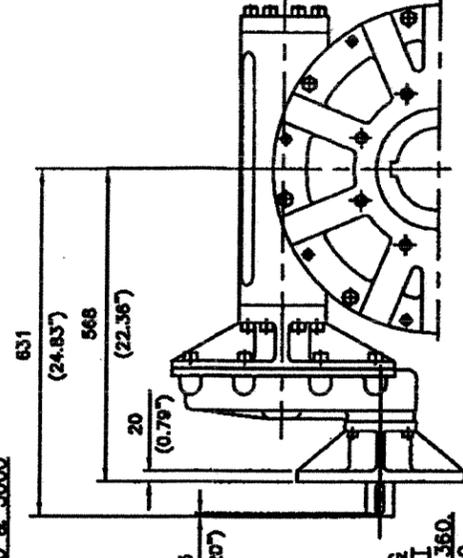


IEWS SHOWING  
MOTORISED UNIT  
RATIOS 180, 240, 360,  
480, 540 & 720

INPUT FLANGE DETAILS (RATIO 90)						
FLANGE O/DIA.	SHAFT DIA.	RECESS DIA.	RECESS DEPTH	HOLE DETAILS (OFF CENTRES)	KEY DETAILS	
ISO F16 #210 (#8.27)	#84.00 (#2.59)	#130.05 (#4.92)	+0.15 (+0.005)	5 (0.20)	5 HOLES #20.5 (#0.81) ON #165.0 (#6.50) P.C.	12x8x100 (0.47"x0.31"x3.94)
FA16 #210 (#8.27)	#84.00 (#2.59)	#120.82 (#4.79)	+0.15 (+0.007)	5 (0.20)	5 HOLES #20.5 (#0.81) ON #165.0 (#6.50) P.C.	12x8x100 (0.47"x0.31"x3.94)
ISO F25 #300 (#11.81)	#120.00 (#3.69)	#200.10 (#7.87)	+0.10 (+0.004)	5 (0.20)	5 HOLES #18.5 (#0.73) ON #254.0 (#10.00) P.C.	14x8x100 (0.55"x0.35"x3.94)
FA25 #300 (#11.81)	#120.00 (#3.69)	#192.30 (#6.98)	+0.17 (+0.007)	5 (0.20)	5 HOLES #18.5 (#0.73) ON #254.0 (#10.00) P.C.	14x8x100 (0.55"x0.35"x3.94)

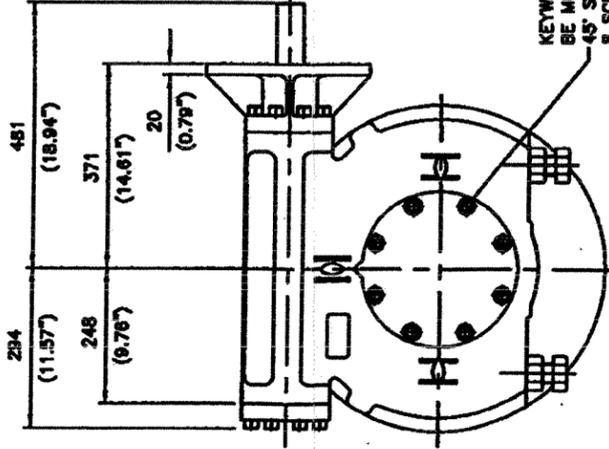

KEYWAY POSITION CAN  
BE MOVED THROUGH  
45° STEPS BY REMOVING  
8 SCREWS INDICATED AND  
ROTATING OUTPUT SLEEVE

FOR INPUT OPTIONS  
SEE TABLE ABOVE

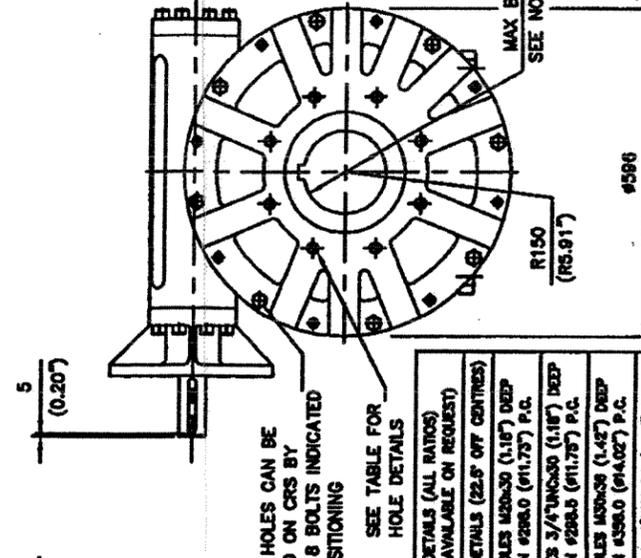

MOUNTING HOLES CAN BE  
POSITIONED ON CRS BY  
REMOVING 8 BOLTS INDICATED  
AND REPOSITIONING

BASEPLATE DETAILS (ALL RATIOS) (ALTERNATIVES AVAILABLE ON REQUEST)	
ISO F30	ISO F40
8 HOLES M20x30 (1.18") DEEP ON #298.0 (#11.75") P.C.	8 HOLES M20x30 (1.18") DEEP ON #298.0 (#11.75") P.C.
8 HOLES 3/4"UNCx30 (1.18") DEEP ON #298.0 (#11.75") P.C.	8 HOLES 3/4"UNCx30 (1.18") DEEP ON #298.0 (#11.75") P.C.
8 HOLES M30x38 (1.42") DEEP ON #358.6 (#14.00") P.C.	8 HOLES M30x38 (1.42") DEEP ON #358.6 (#14.00") P.C.
8 HOLES 1"UNCx38 (1.42") DEEP ON #358.6 (#14.00") P.C.	8 HOLES 1"UNCx38 (1.42") DEEP ON #358.6 (#14.00") P.C.
8 HOLES M36x38 (1.42") DEEP ON #408.4 (#16.00") P.C.	8 HOLES M36x38 (1.42") DEEP ON #408.4 (#16.00") P.C.
8 HOLES 1.25"UNCx38 (1.42") DEEP ON #408.4 (#16.00") P.C.	8 HOLES 1.25"UNCx38 (1.42") DEEP ON #408.4 (#16.00") P.C.

IEWS SHOWING MOTORISED UNIT  
RATIO 60 ONLY

165 (6.50)  
MAX STEM ENTRY

BASEPLATE DETAILS (ALL RATIOS) (ALTERNATIVES AVAILABLE ON REQUEST)	
ISO F30	ISO F40
8 HOLES M20x30 (1.18") DEEP ON #298.0 (#11.75") P.C.	8 HOLES M20x30 (1.18") DEEP ON #298.0 (#11.75") P.C.
8 HOLES 3/4"UNCx30 (1.18") DEEP ON #298.0 (#11.75") P.C.	8 HOLES 3/4"UNCx30 (1.18") DEEP ON #298.0 (#11.75") P.C.
8 HOLES M30x38 (1.42") DEEP ON #358.6 (#14.00") P.C.	8 HOLES M30x38 (1.42") DEEP ON #358.6 (#14.00") P.C.
8 HOLES 1"UNCx38 (1.42") DEEP ON #358.6 (#14.00") P.C.	8 HOLES 1"UNCx38 (1.42") DEEP ON #358.6 (#14.00") P.C.
8 HOLES M36x38 (1.42") DEEP ON #408.4 (#16.00") P.C.	8 HOLES M36x38 (1.42") DEEP ON #408.4 (#16.00") P.C.
8 HOLES 1.25"UNCx38 (1.42") DEEP ON #408.4 (#16.00") P.C.	8 HOLES 1.25"UNCx38 (1.42") DEEP ON #408.4 (#16.00") P.C.



MAX BORE SO KEY	MAX BORE RECTANGULAR KEY
STD BORE KEY	STD BORE KEY
ISO F30	ISO F30
ISO F40	ISO F40
ISO F50	ISO F50
ISO F63	ISO F63
ISO F80	ISO F80
ISO F100	ISO F100
ISO F125	ISO F125
ISO F160	ISO F160
ISO F200	ISO F200
ISO F250	ISO F250
ISO F315	ISO F315
ISO F400	ISO F400
ISO F500	ISO F500
ISO F630	ISO F630
ISO F800	ISO F800
ISO F1000	ISO F1000
ISO F1250	ISO F1250
ISO F1600	ISO F1600
ISO F2000	ISO F2000
ISO F2500	ISO F2500
ISO F3150	ISO F3150
ISO F4000	ISO F4000
ISO F5000	ISO F5000
ISO F6300	ISO F6300
ISO F8000	ISO F8000
ISO F10000	ISO F10000
ISO F12500	ISO F12500
ISO F16000	ISO F16000
ISO F20000	ISO F20000
ISO F25000	ISO F25000
ISO F31500	ISO F31500
ISO F40000	ISO F40000
ISO F50000	ISO F50000
ISO F63000	ISO F63000
ISO F80000	ISO F80000
ISO F100000	ISO F100000
ISO F125000	ISO F125000
ISO F160000	ISO F160000
ISO F200000	ISO F200000
ISO F250000	ISO F250000
ISO F315000	ISO F315000
ISO F400000	ISO F400000
ISO F500000	ISO F500000
ISO F630000	ISO F630000
ISO F800000	ISO F800000
ISO F1000000	ISO F1000000
ISO F1250000	ISO F1250000
ISO F1600000	ISO F1600000
ISO F2000000	ISO F2000000
ISO F2500000	ISO F2500000
ISO F3150000	ISO F3150000
ISO F4000000	ISO F4000000
ISO F5000000	ISO F5000000
ISO F6300000	ISO F6300000
ISO F8000000	ISO F8000000
ISO F10000000	ISO F10000000
ISO F12500000	ISO F12500000
ISO F16000000	ISO F16000000
ISO F20000000	ISO F20000000
ISO F25000000	ISO F25000000
ISO F31500000	ISO F31500000
ISO F40000000	ISO F40000000
ISO F50000000	ISO F50000000
ISO F63000000	ISO F63000000
ISO F80000000	ISO F80000000
ISO F100000000	ISO F100000000
ISO F125000000	ISO F125000000
ISO F160000000	ISO F160000000
ISO F200000000	ISO F200000000
ISO F80000000000000000	ISO F80000000000000000
ISO F100000000000000000	ISO F100000000000000000
ISO F125000000000000000	ISO F125000000000000000
ISO F160000000000000000	ISO F160000000000000000
ISO F200000000000000000	ISO F20000000000000000