


- MUA-1 ICG DIRECT FIRED/ 100% O.A.
- MUA-2 THERMAL AIRE (TEMPRITE) DIRECT FIRED/ 100% O.A.
- MUA-3 BULLOCH DIRECT FIRED/ 100% O.A.
- MUA-4 NATIONAL CHAMPION (TEMPRITE) INDIRECT FIRED/ MIXED AIR
- MUA-5 THERMAL AIRE (TEMPRITE) DIRECT FIRED/ 100% O.A.
- MUA-6 NATIONAL CHAMPION (TEMPRITE) INDIRECT FIRED/ MIXED AIR
- MUA-7 NATIONAL CHAMPION (TEMPRITE) INDIRECT FIRED/ MIXED AIR

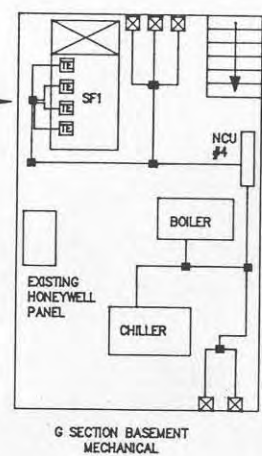

MUA #2 → EXH  
32,500  
MVA #3 → EXH  
40,000

MUA #5 - EXH  
+ 32,500

- RESISTIVE TEMP. ELEMENT
- CO<sub>2</sub> SENSOR (MTD. AT FACE HEIGHT)
- MAG STARTER
- OVERHEAD DOOR CONTROLLER
- JUNCTION BOX
- MAKE UP AIR UNIT
- EXHAUST FAN  
n = UNIT I.D.

MUA #7  
+ 4000 cfm  
MUA-6 & EXH

UNIT -n JOHNSON CONTROLS DC-9100-8154  
UNITARY DIGITAL CONTROLLER (u = N2 ADDRESS)

DRAWING TITLE FT. ROUGE G SECTION EQUIPMENT & CONDUIT LAYOUT		FILE: GSECFLRB	
REFERENCE DRAWING NO.	1 AS BUILT	REVISION-LOCATION	04/10/24 CF
SALES ENGINEER PROJECT MANAGER	RC	DRAWN	EGN DATE
BY DATE	10/02/21	DATE	
PROJECT WINNIEPEG TRANSIT ADMINISTRATION AND G SECTION METASIS FACILITY MANAGEMENT SYSTEM	CONTRACT NUMBER 91098-5006	CONTRACT NUMBER 91098-5006	DRAWING NUMBER 1501-32B
JOHNSON CONTROLS Systems & Services Division		JOHNSON CONTROLS LTD 800 MORAY STREET WINNIEPEG, MANITOBA R3U 3V9 204-985-8380	