



PANEL TT EXHAUST FANS

EF1-C BUS EXHAUST PICKUP S.W. CORNER WELD SHOP XRL6 B01 B11	EF9-C BUS EXHAUST PICKUP UNDER FLOOR EAST BLISTER XRL7 B01 B11	17 NOT PICKED UP BY METASYS	EF25-C NOT PICKED UP BY METASYS XRL7 B05 B19
EF2-C WEST CEILING HIGH BAY EXHAUST XRL6 B02 B12	EF10-C CAR & TRUCK UNDER FLOOR EXHAUST SOUTH EAST BLISTER XRL7 B02 B12	18 NOT PICKED UP BY METASYS	26 NOT PICKED UP BY METASYS
EF3-C CENTRE HIGH BAY EXHAUST UNIT XRL6 B03 B13	EF11-C EAST WALL SOUTH SIDE GENERAL EXHAUST XRL7 B03 B13	19 NOT PICKED UP BY METASYS	27 NOT PICKED UP BY METASYS
EF4-C EAST HIGH BAY EXHAUST XRL6 B04 B14	12 NOT PICKED UP BY METASYS	20 NOT PICKED UP BY METASYS	28 NOT PICKED UP BY METASYS
EF5-C UNDER FLOOR BUS EXHAUST PICKUP GENERAL FOREMAN'S OFFICE XRL6 B05 B15	13 NOT PICKED UP BY METASYS	21 NOT PICKED UP BY METASYS	EF29-C NEW EXHAUST FAN XRL7 B05 B15
EF6-C EXHAUST FAN STEAM ROOM XRL6 B06 B16	14 NOT PICKED UP BY METASYS	22 NOT PICKED UP BY METASYS	30 SPARE
EF7-C BUS EXHAUST PICKUP UNDER FLOOR WEST SOUTH BLISTER XRL6 B07 B17	15 NOT PICKED UP BY METASYS	23 NOT PICKED UP BY METASYS	31 SPARE
EF8-C WEST/SOUTH WALL GENERAL EXHAUST XRL6 B08 B18	16 NOT PICKED UP BY METASYS	EF24-C EXHAUST FAN PAINT ROOM XRL7 B04 B14	32 SPARE

B1 9

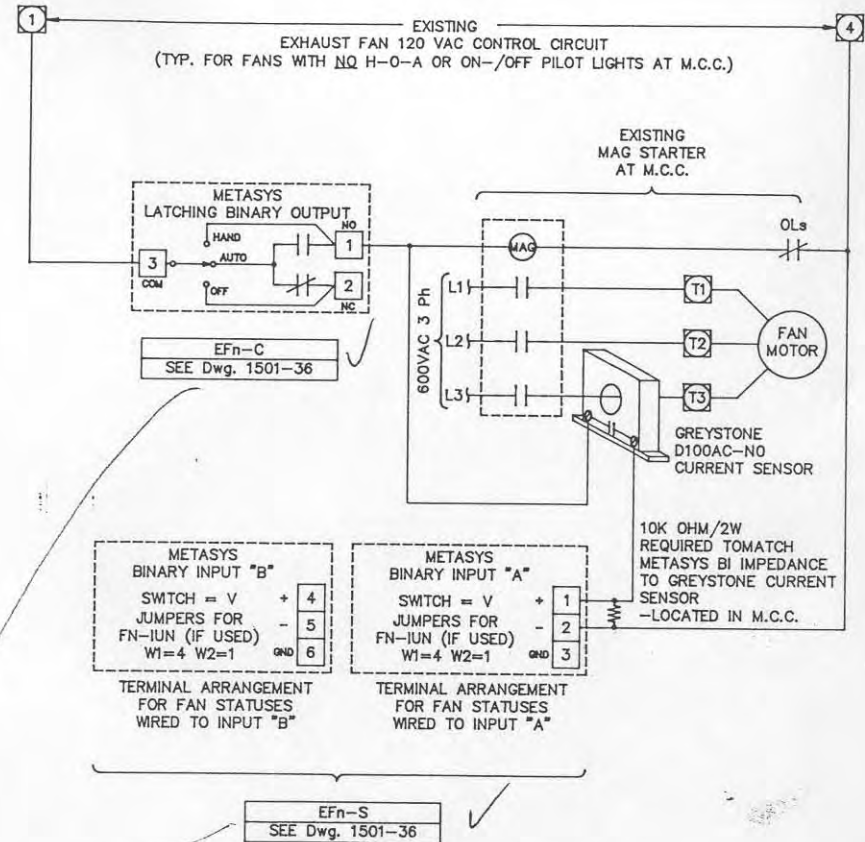

~~EXH-FANS/EF-S~~
~~XRL6 B01~~

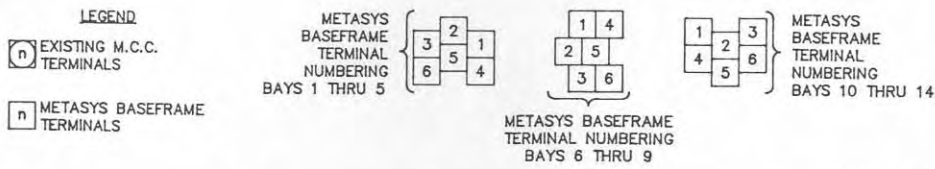

DRAWING TITLE PANEL TT EXHAUST FAN WIRING DETAILS		1 AS BUILT		04/10/10 CW	
REFERENCE DRAWING NO.	REVISION-LOCATION	ECH	DATE	BY	APPROVED
SALES ENGR/PROJECT MGR/APPL ENGR	DRAWN	BY	DATE	BY	
RH	RC	RC	BY CW DATE 10/10/10	DATE	
PROJECT WINNIPEG TRANSIT ADMINISTRATION AND 6 SECTION METASYS FACILITY MANAGEMENT SYSTEM			JOHNSON CONTROLS LTD 800 WATSON STREET WINNIPEG, MANITOBA R3J 3Y9 204-885-8380		CONTRACT NUMBER 91C98-5006 DRAWING NUMBER 1501-32C

FILE: PANELTT