



TE-6000-4
1000 OHM
RESISTIVE
TEMPERATURE
ELEMENT

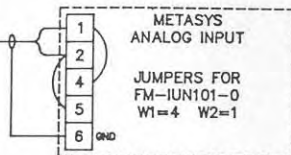

NOTE:


WHEN USING FM-IUN101-0 IN 2-WIRE RTD APPLICATION AS SHOWN JUMPER TERMINAL 1 TO 4 AND 2 TO 5 AND SET W1=4 AND W2=1 TO ELIMINATE TEMPERATURE OFFSET CAUSED BY IUN INPUT FUSING.

THIS COMPENSATION IS NOT REQUIRED WITH THE FM-IUN101-1.

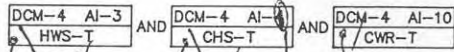

TEMPERATURE MONITORING


Boiler, Chiller, Chiller

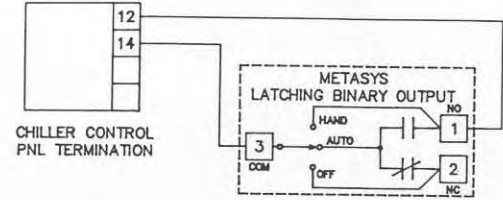

XRL-2 BO-2
CH-C


CHILLER CONTROL

*remote shutdown only
Startup requires local activation*

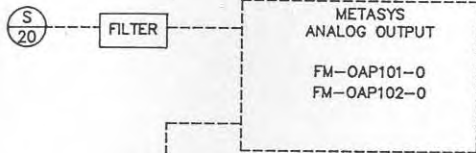

DCM-4 AO-3
HW-VLV

PERIMETER

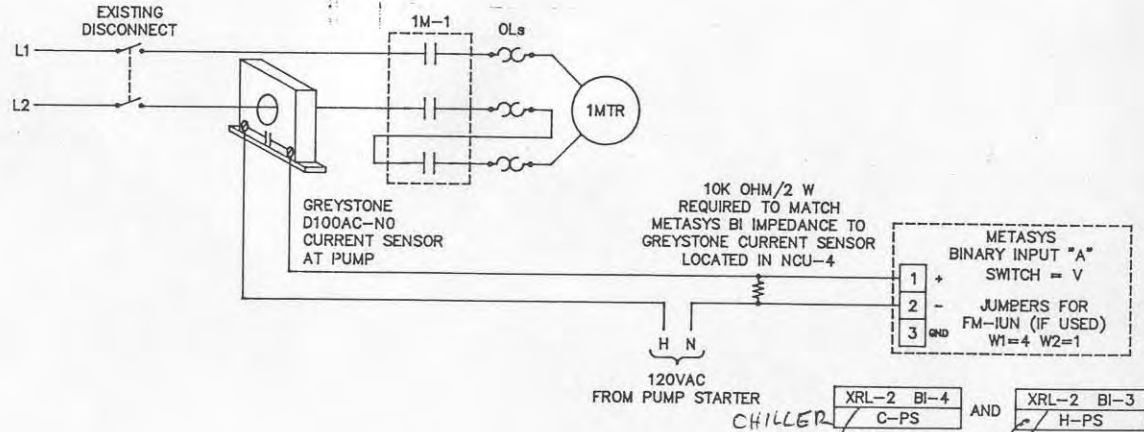


This is not the perimeter loop circ pump, but the condenser cooling water pump to the roof water evaporator/cooling tower

LEGEND


n EXISTING M.C.C. TERMINALS

n METASYS BASEFRAME TERMINALS


METASYS BASEFRAME TERMINAL NUMBERING BAYS 1 THRU 5

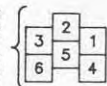

METASYS BASEFRAME TERMINAL NUMBERING BAYS 6 THRU 9

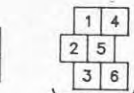

METASYS BASEFRAME TERMINAL NUMBERING BAYS 10 THRU 14

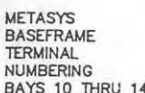

DRAWING TITLE FT. ROUGE ADMINISTRATION HOT WATER/CHILLED WATER WIRING DETAILS		1 AS BUILT		DATE BY	
SALES ENR	PROJECT MGR	NO. RC	REVISION-LOCATION	ECON	DATE BY
RC	RC	RC	RC	RC	RC
PROJECT WINNIPEG TRANSIT ADMINISTRATION AND G SECTION METASYS FACILITY MANAGEMENT SYSTEM		 Systems & Services Division		CONTRACT NUMBER 91098-5006 DRAWING NUMBER 1501-40	