
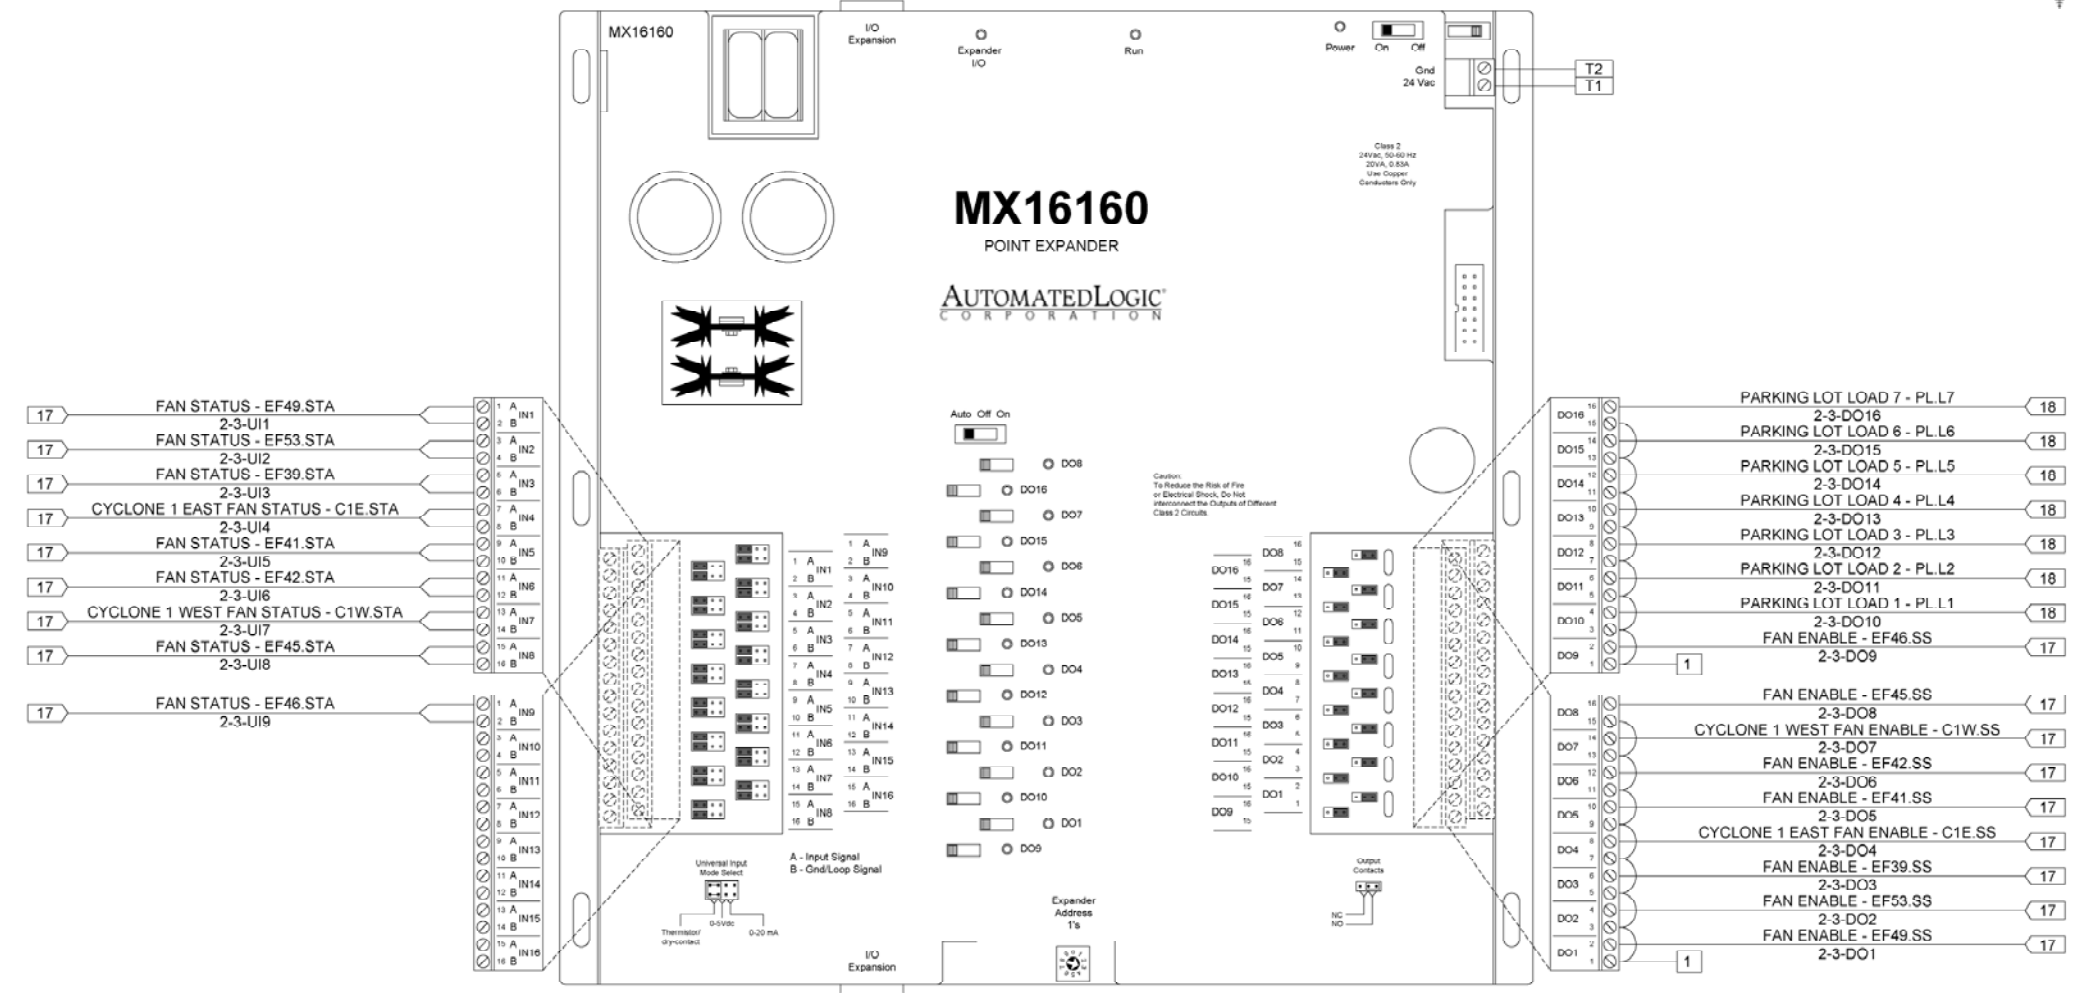



EF Controller(s) cont'd.

Bill of Materials				
DID	DESCRIPTION	MANUFACTURER	PART NUMBER	QTY
MX16160	MX16160	AUTOMATED LOGIC	MX16160	1 ea


Panel continued from previous page

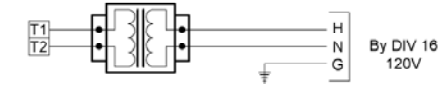

Panel Layout

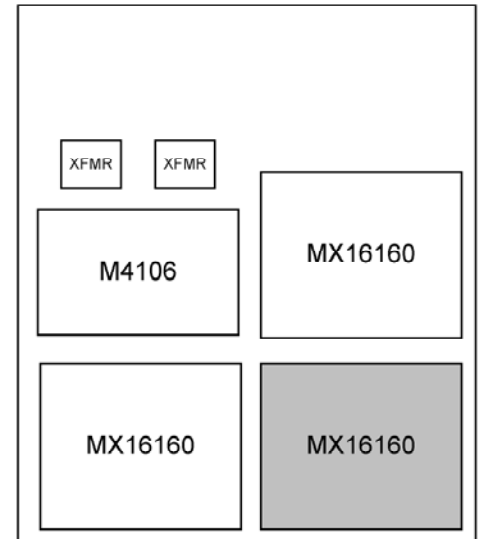

Relay wiring details

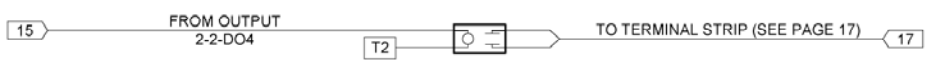

Winnipeg Transit Winnipeg, Manitoba			
Integrated Control Systems			
EF Controller(s) cont'd.			
REV: 1	As-Built	5/29/2008	JOB NO: ICS06-81
AUTOMATED LOGIC CORPORATION			CHECK BY: JJJ
			DSCODE:
			16 of 27