
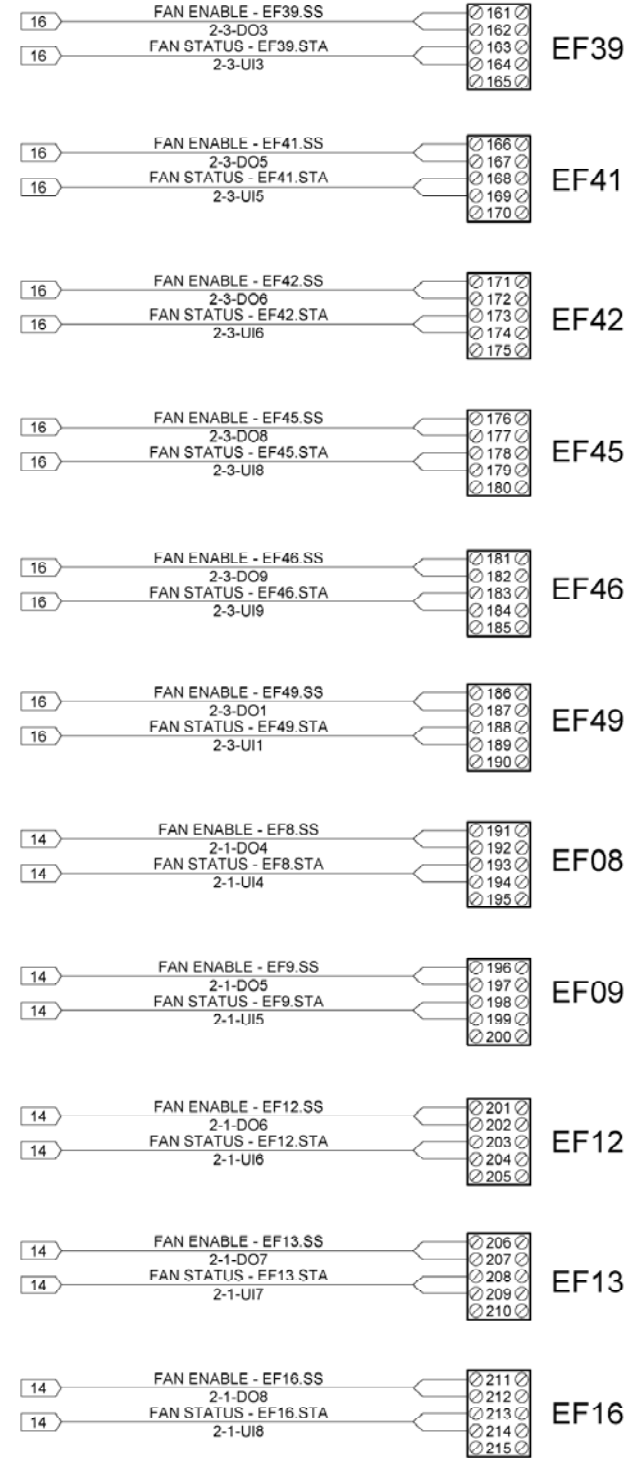




# Exhaust Fan Wiring Details

## Large Termination Cabinet

### Large Termination Cabinet

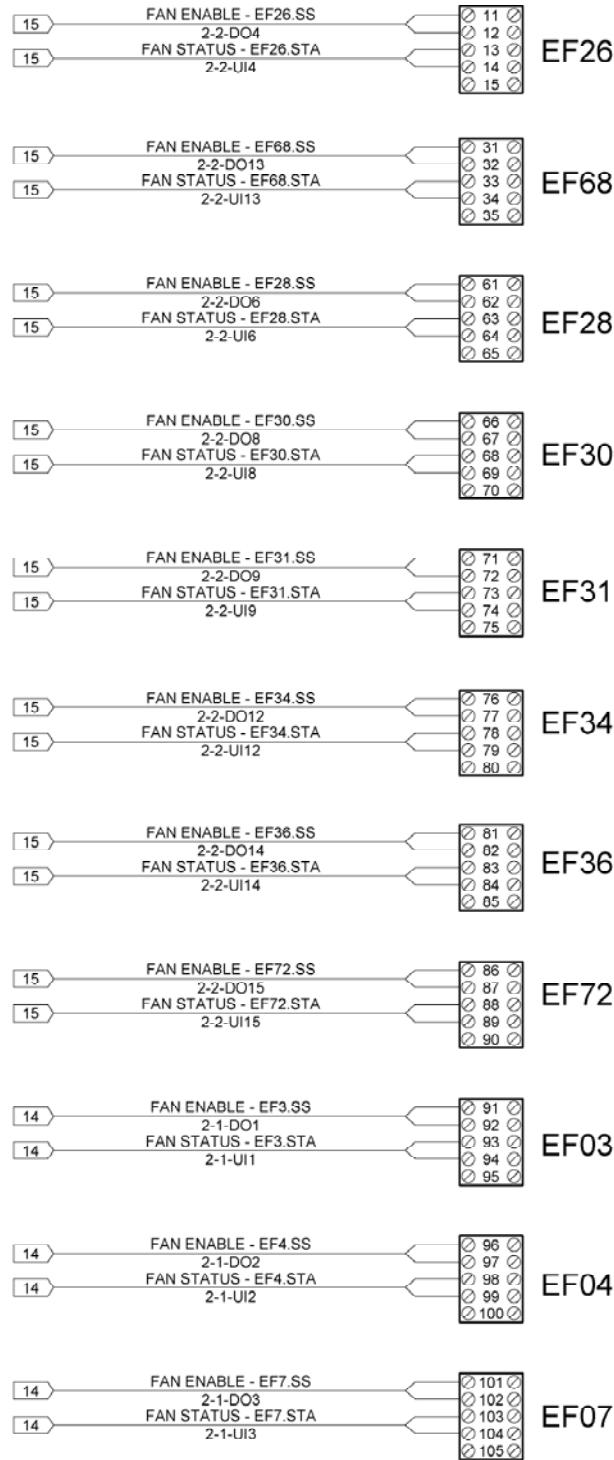

Bill of Materials				
DID	DESCRIPTION	MANUFACTURER	PART NUMBER	QTY
REL-B	DPDT RELAY WITH LIGHT 24VDC	IDEC	RH2B-ULC-AC24V	33 ea

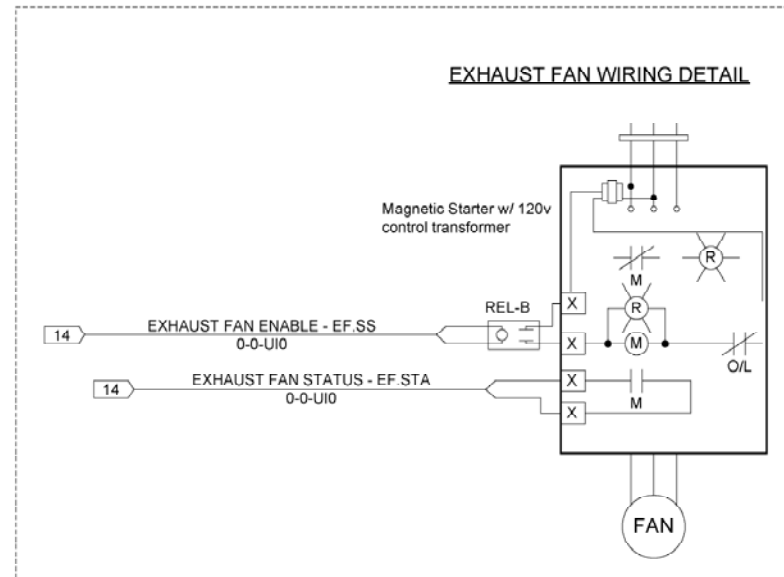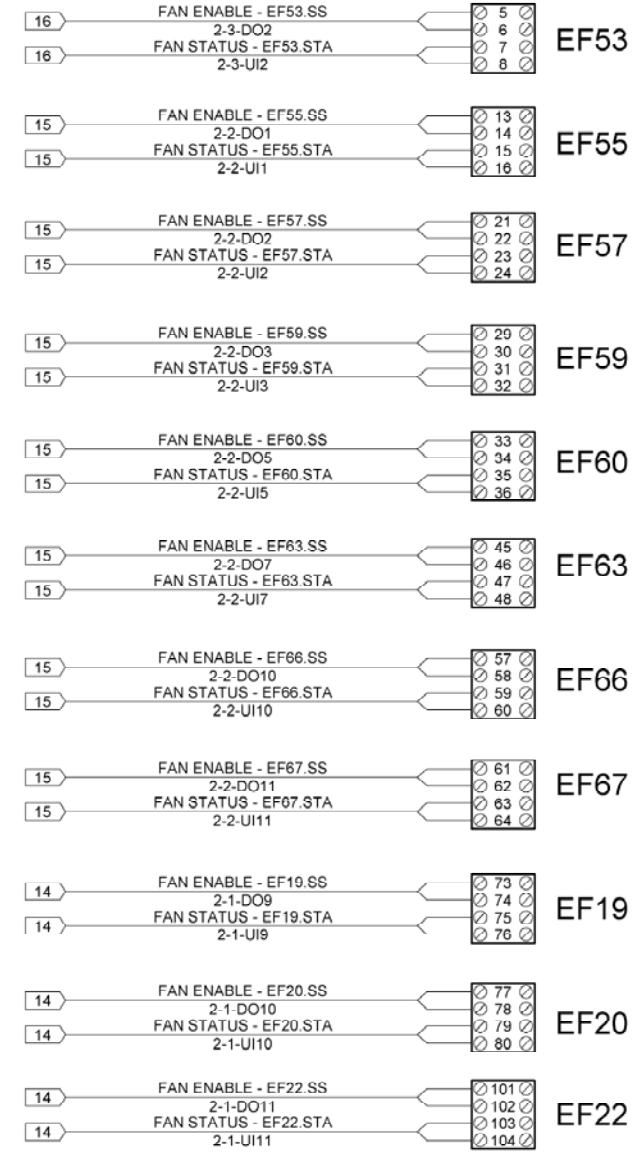

Winnipeg Transit  
Winnipeg, Manitoba

Integrated Control Systems

Exhaust Fan Wiring Details

REV: 1	As-Built	5/29/2008	JOB NO: ICS06-81
AUTOMATED LOGIC CORPORATION			CHECK BY: JJJ
			DSCODE:
17 of 27			