


# F-1, East Cyclone 1 Schematics

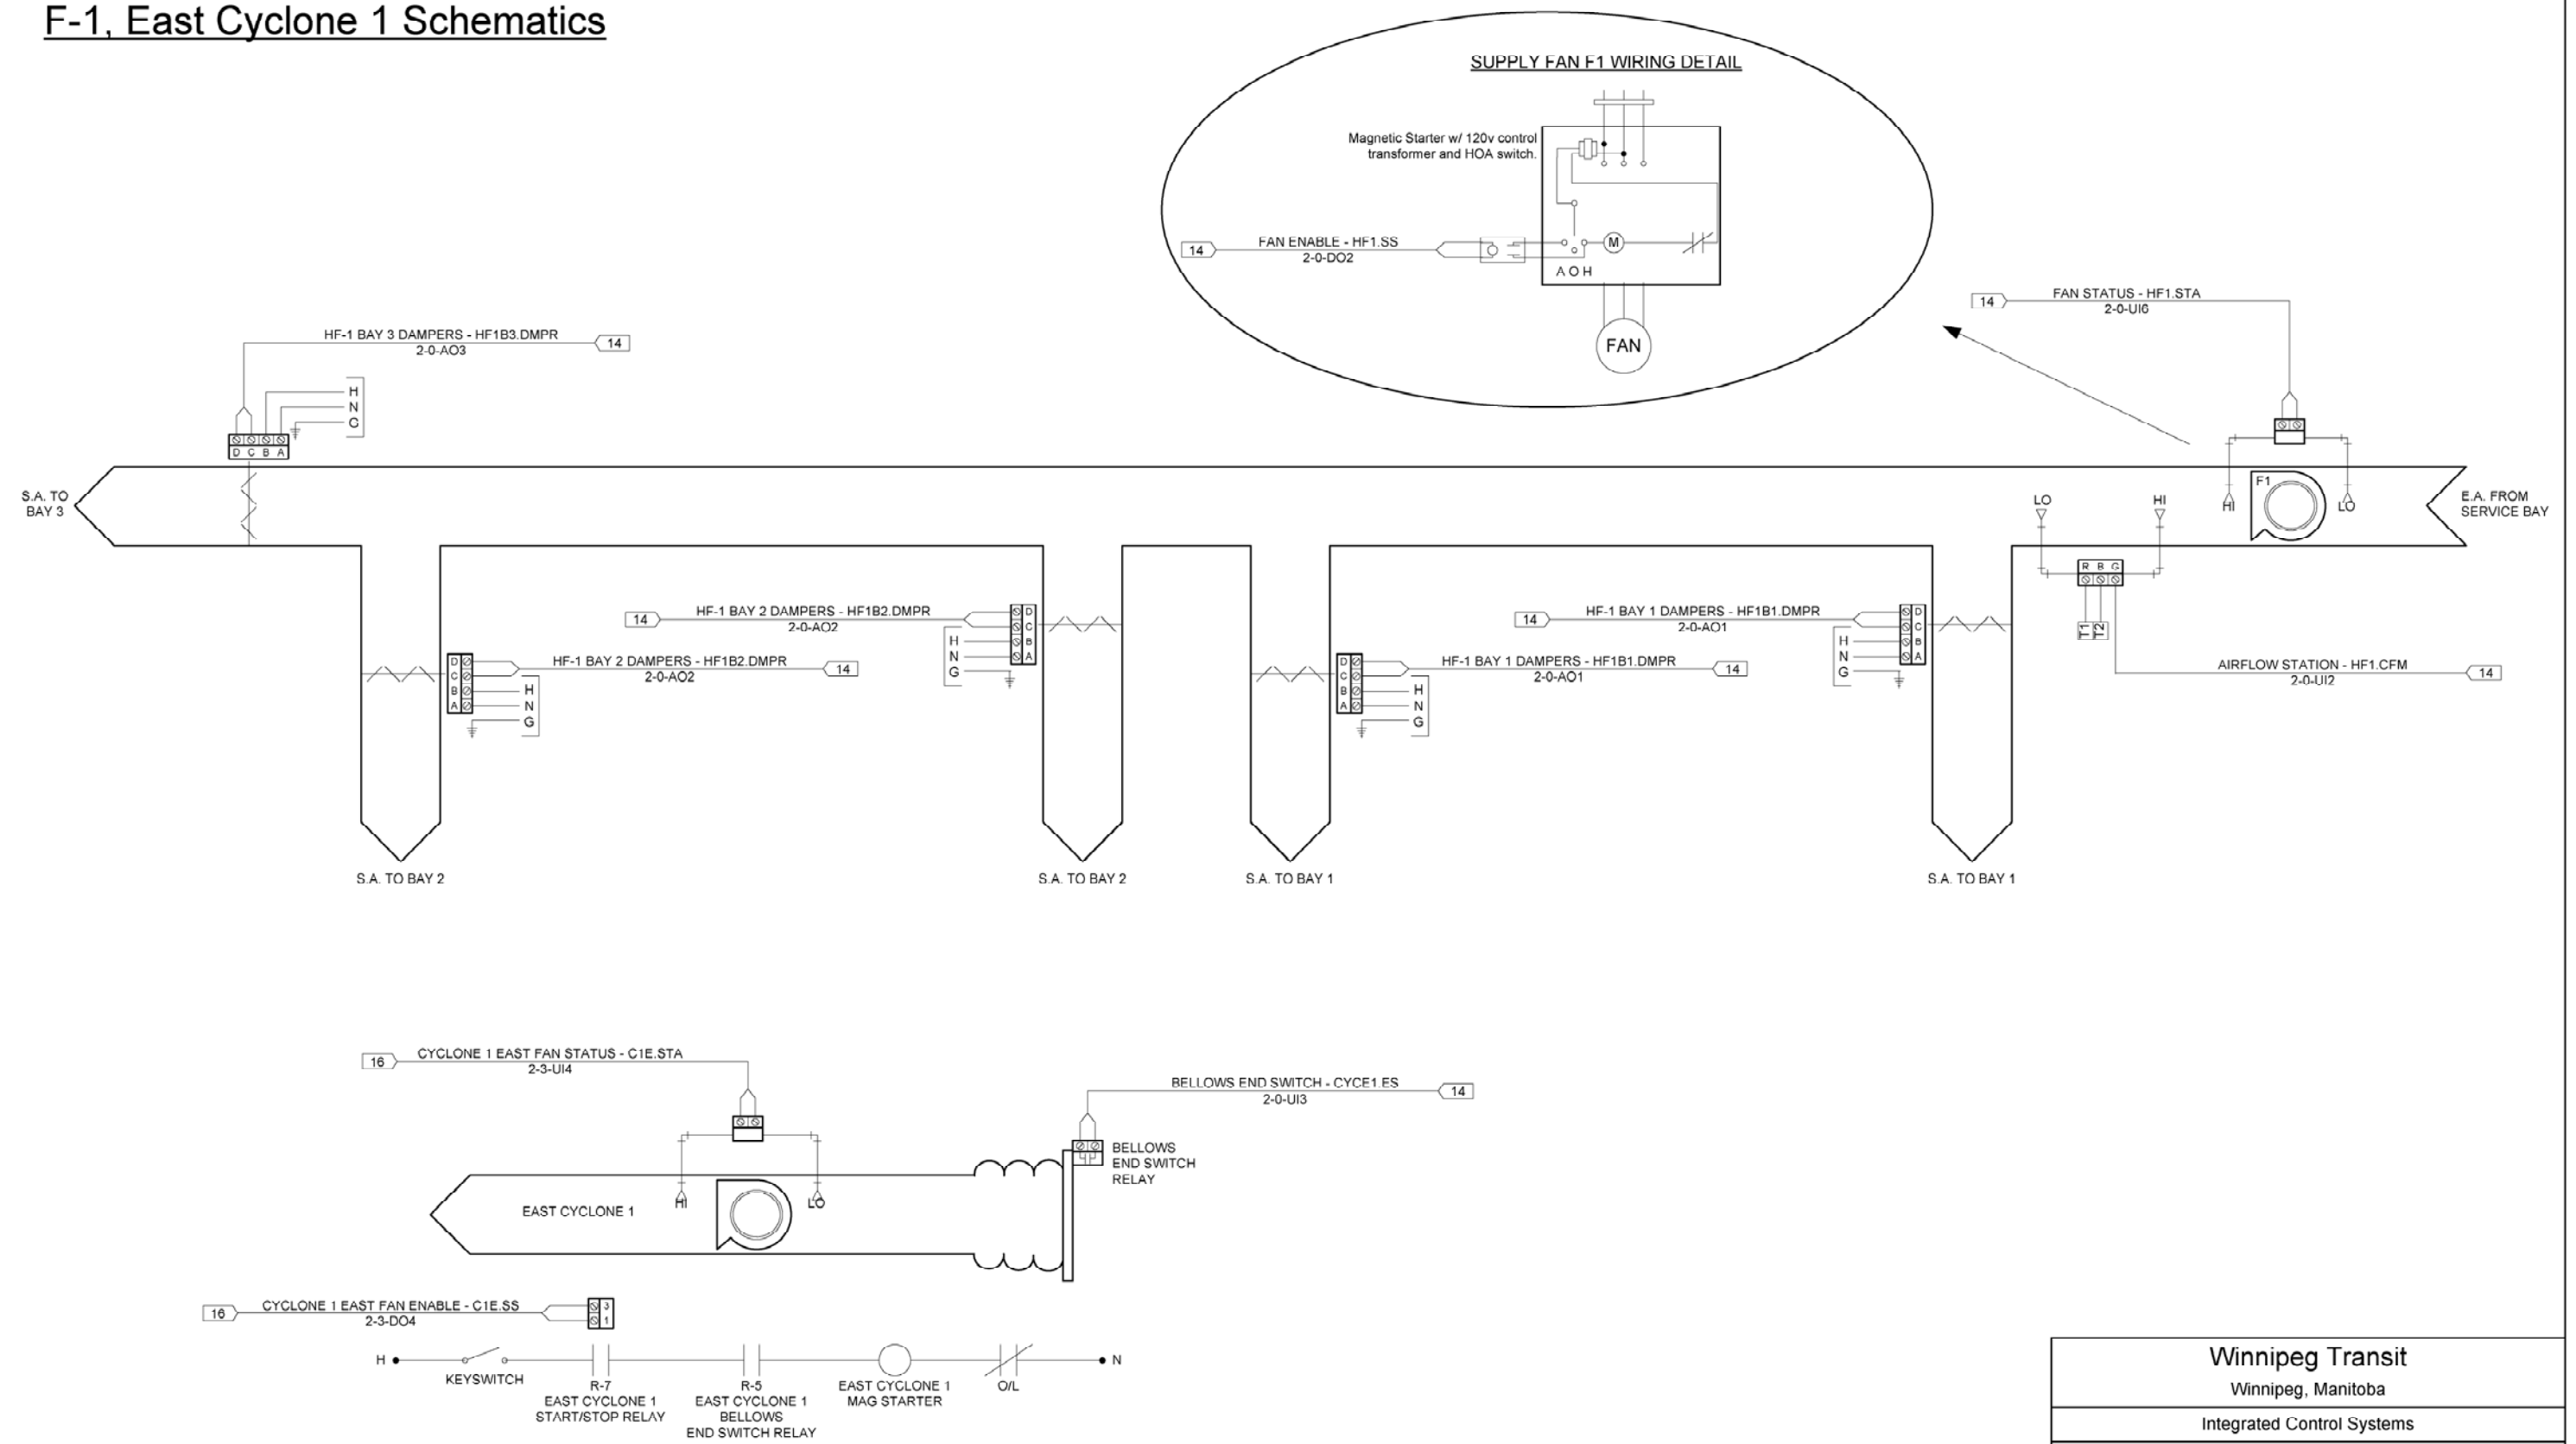

<b>Winnipeg Transit</b> Winnipeg, Manitoba			
Integrated Control Systems			
F-1, East Cyclone 1 Schematics			
REV: 1	As-Built	5/29/2008	JOB NO: ICS06-81
<b>AUTOMATEDLOGIC</b> CORPORATION			CHECK BY: JJJ
			DSCODE:
			19 of 27