
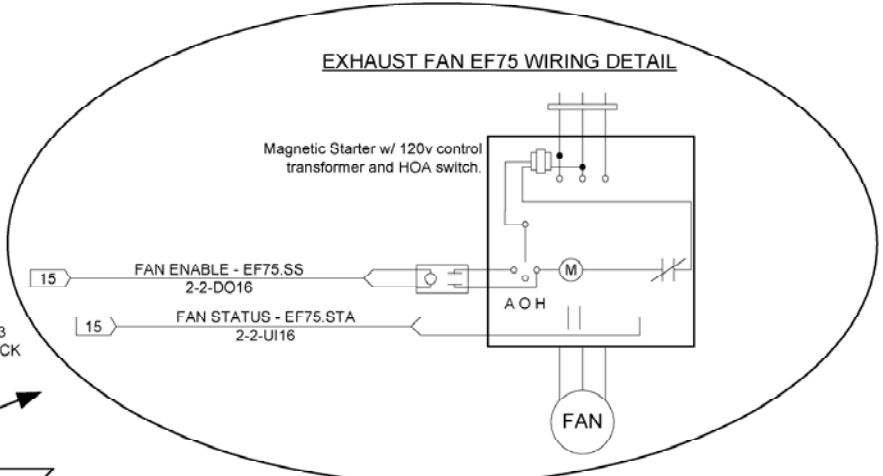
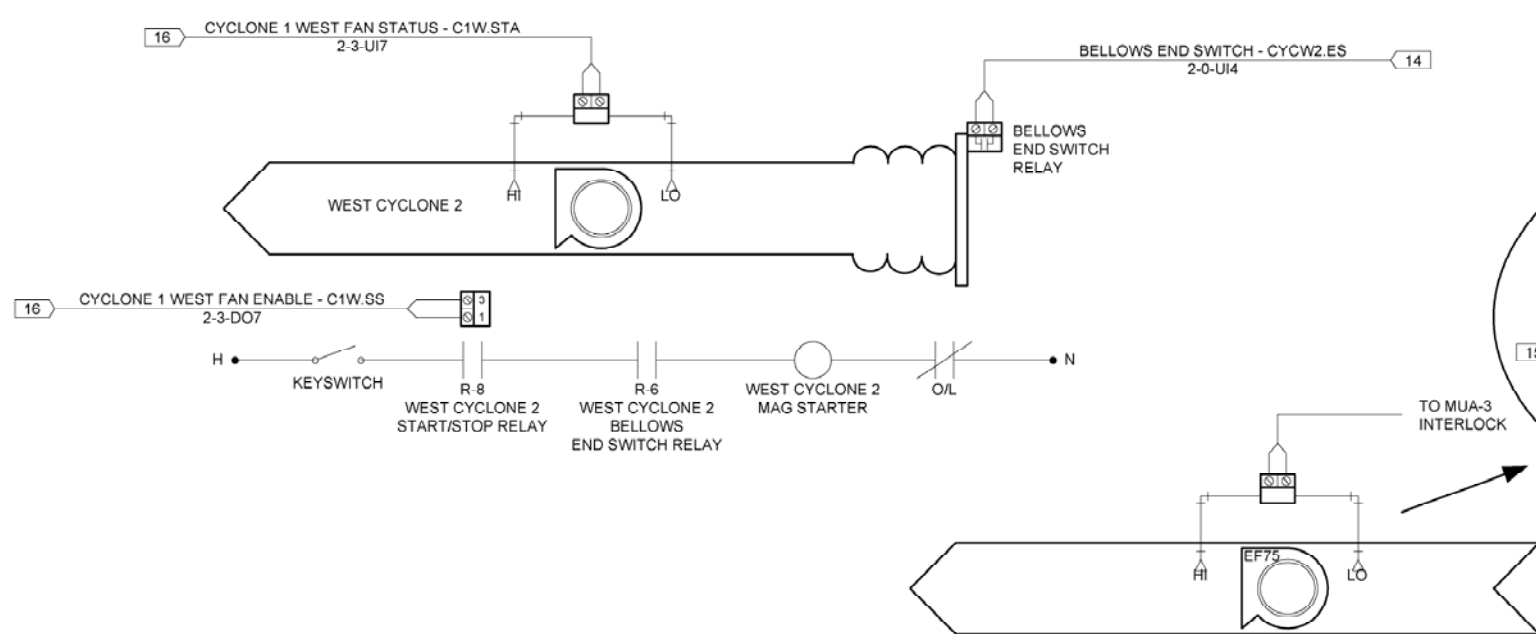
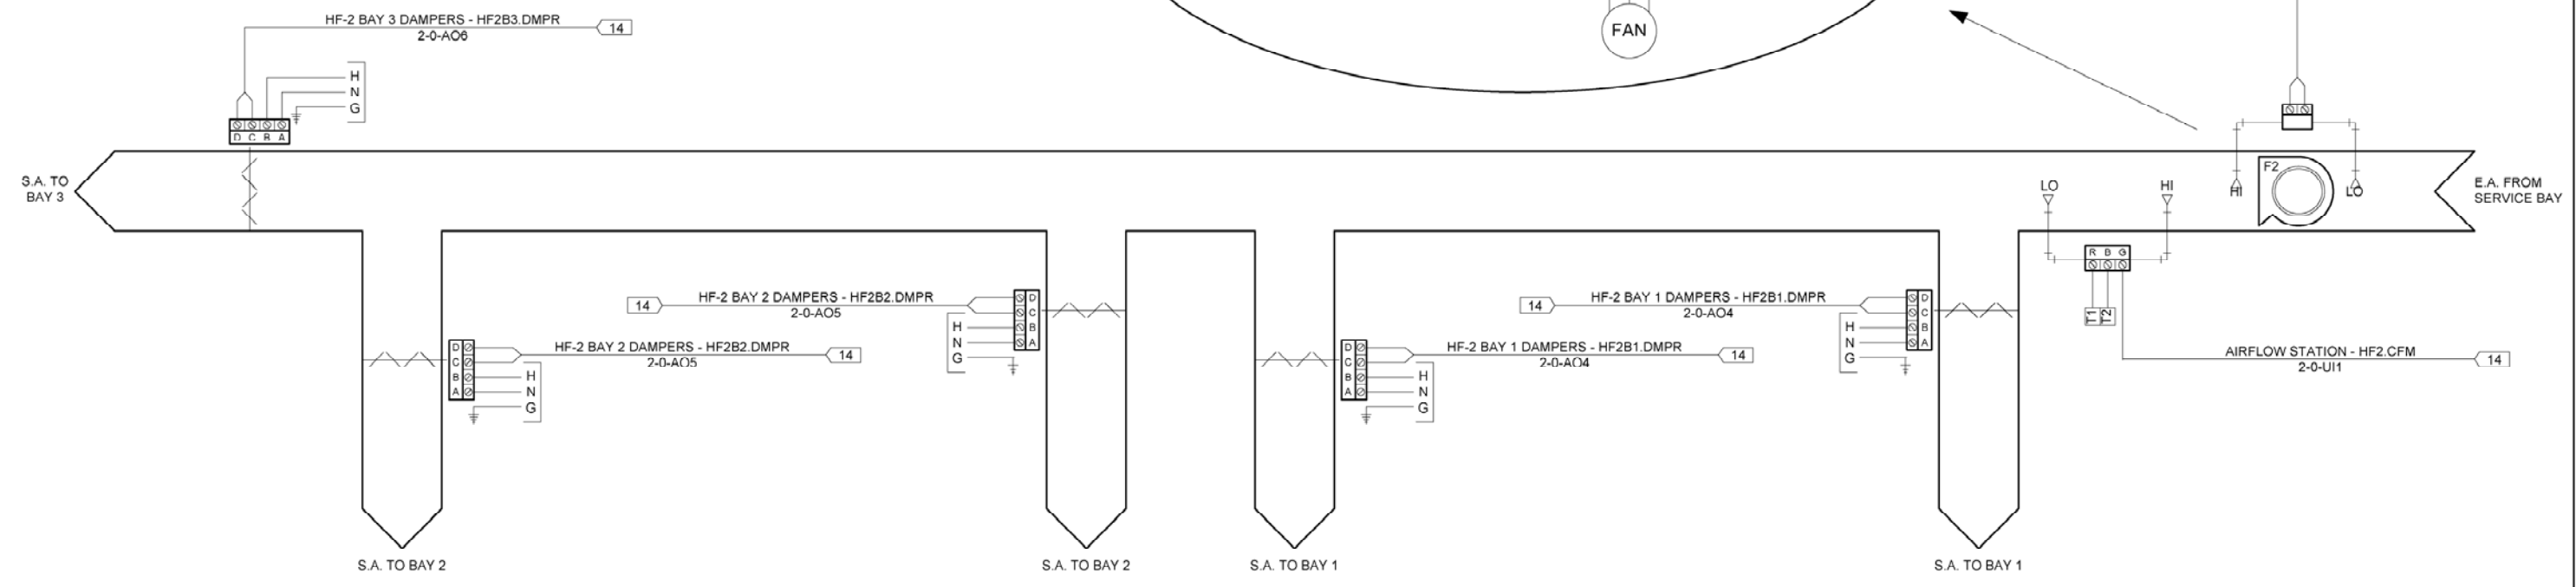


F-2, West Cyclone 2 Schematics

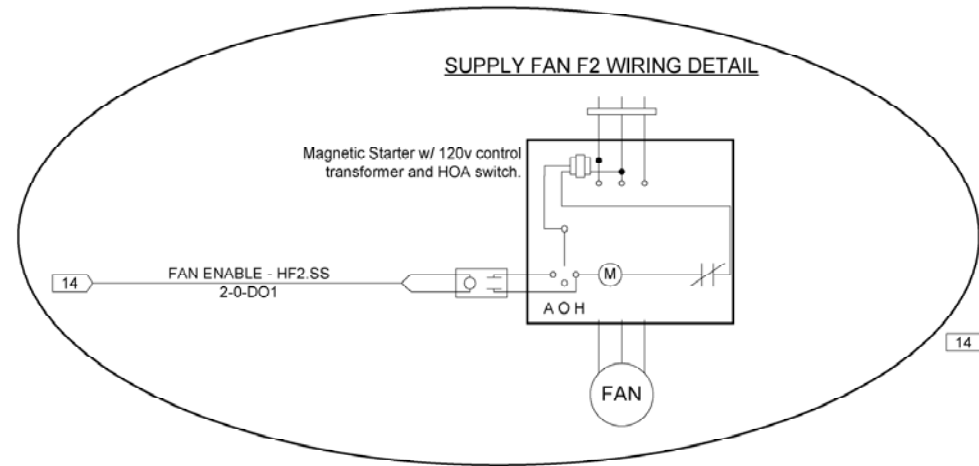

Winnipeg Transit			
Winnipeg, Manitoba			
Integrated Control Systems			
F-2, West Cyclone 2 Schematics			
REV: 1	As-Built	5/29/2008	JOB NO: ICS06-81
AUTOMATEDLOGIC CORPORATION			CHECK BY: JJL
			DSCODE:
			20 of 27