
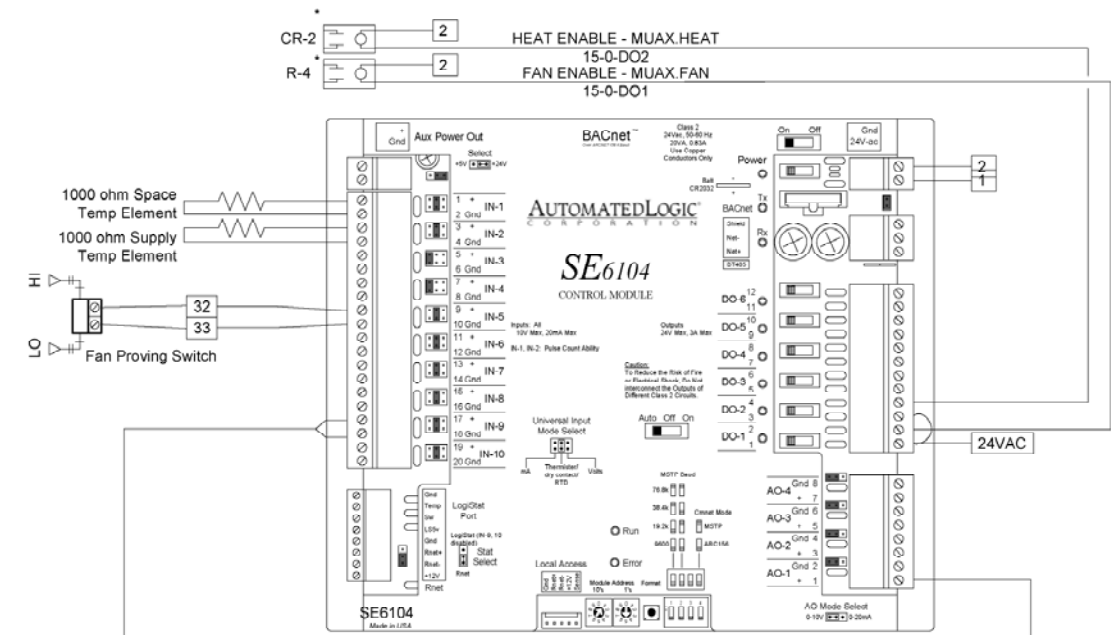


# MUA2 and MUA3 Wiring Details

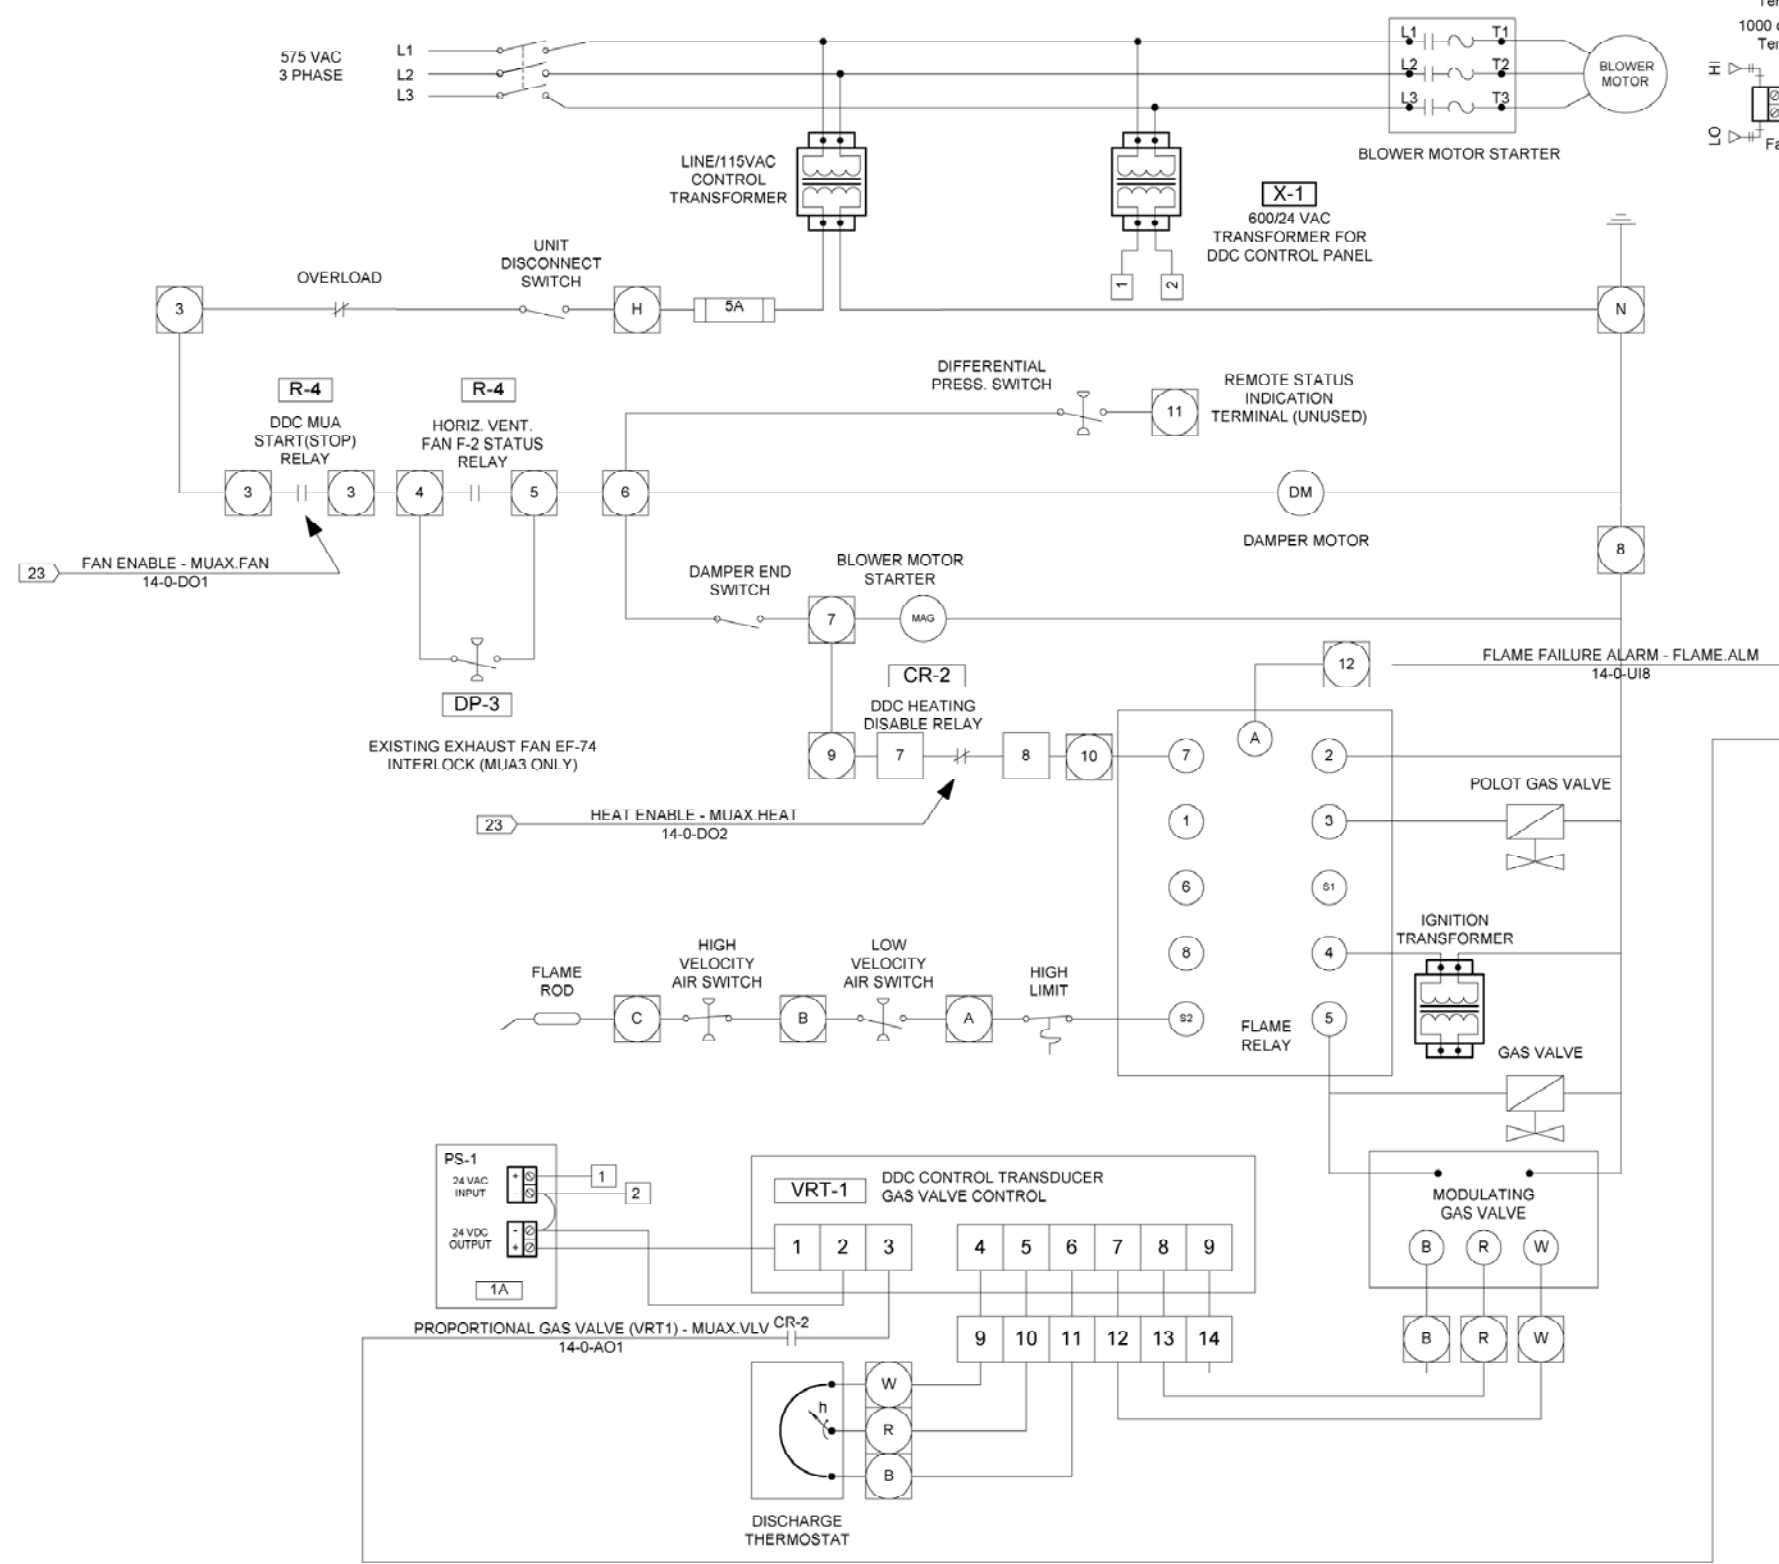

**INPUT AND OUTPUT CONFIGURATION**

I/O #	Description
UI1	Space Temperature
UI2	Supply Air Temperature
UI3	Filter Pressure
UI4	Gas Sensor
UI5	Fan Status
UI6	Door A Status
UI7	Door B Status
UI8	Door C Status
UI9	Flame Failure
UI10	Outside Air Temp (MUA6)
DO1	Supply Fan Enable (CR-1)
DO2	Heat Enable (CR-2)
DO3	Unit Heater (future)
AO1	Heating Valve
AO2	Outside Air Damper

**Winnipeg Transit**  
Winnipeg, Manitoba

**Integrated Control Systems**

**MUA2 and MUA3 Wiring Details**

REV: 1	As-Built	5/29/2008	JOB NO: ICS06-81
			CHECK BY: JJL
			DSCODE:

**AUTOMATEDLOGIC**  
CORPORATION

23 of 27