


OBSERVATION WELLS			
NO	ELEV	NORTH	WEST
1	778.65	2180	0180
2	780.63	25180	0150
3	777.89	26106	20100
4	777.43	26100	23130
5	777.53	23100	24115
6	776.21	20100	24115
7	776.93	17100	24115
8	775.30	14125	23190

NOTE:
 FOR SOILS INFORMATION PERTAINING TO SITE REFER TO CLAUSE 27-04 OF THE SPECIFICATIONS.
 FOR LANDSCAPING REFER TO SECTION 33 OF THE SPECIFICATIONS.

THIS PLAN COMPILED FROM:
 LAND SURVEY PLANS No. 2474, 2269, 3264, 7396, 9023
 SURVEY FIELD BOOKS No. F-278, F-285, F-308, F-309

SURVEYED & PLAN CHECKED
 BY: [Signature]
 APPROVED AS BUILT
 BY: [Signature]

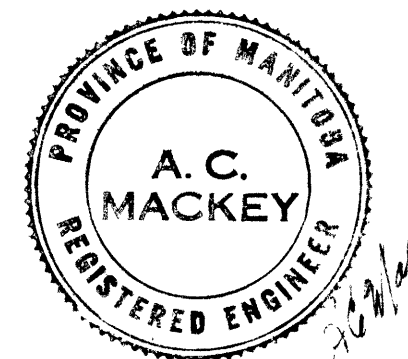

THE METROPOLITAN CORPORATION OF GREATER WINNIPEG
 WATERWORKS & WASTE DISPOSAL DIVISION
 A. PENMAN - DIRECTOR

WATERWORKS DEPT.
DEACON RESERVOIR
 STAGE I
SITE PLAN

DATE: OCT. 1970
 DRAWING NO. **G-120 A**

MICROFILMED mar77