

INTERIOR WALL FINISH LEGEND

..... 16mm VH1 ABUSE RESISTANT GYPSUM IN LIEU OF 16mm GYPSUM

1
AD05a

WALL TYPE CLARIFICATION - BASEMENT

SCALE 1:100

WALL TYPE REVISION:

- DELETE VHI GYPSUM FINISH NOT REQUIRED ON BASEMENT CONCRETE BLOCK WALLS.

SINCLAIR PARK COMMUNITY CENTRE

AD-05a


harold funk architect inc.

NOTE: THIS DRAWING IS PROVIDED FOR CLARIFICATION AND REVISION PURPOSES AND SHALL BE READ IN CONJUNCTION WITH OTHER CONSTRUCTION DOCUMENTATION. EXTRANEOUS INFORMATION HAS BEEN REMOVED FOR CLARITY. NOTIFY THE CONTRACT ADMINISTRATOR IN THE EVENT OF QUESTIONS.

Project # 08-011
Drawn: G.S.
Reviewed: H.F.
Date: 30th March 2010

Harold Funk Architect Inc.
Architecture and Urban Design

401-55 Donald Street, Winnipeg, Manitoba R3C 1L8
T (204) 943-5087 info@funkarchitect.com
F (204) 949-9231 funkarchitect.com

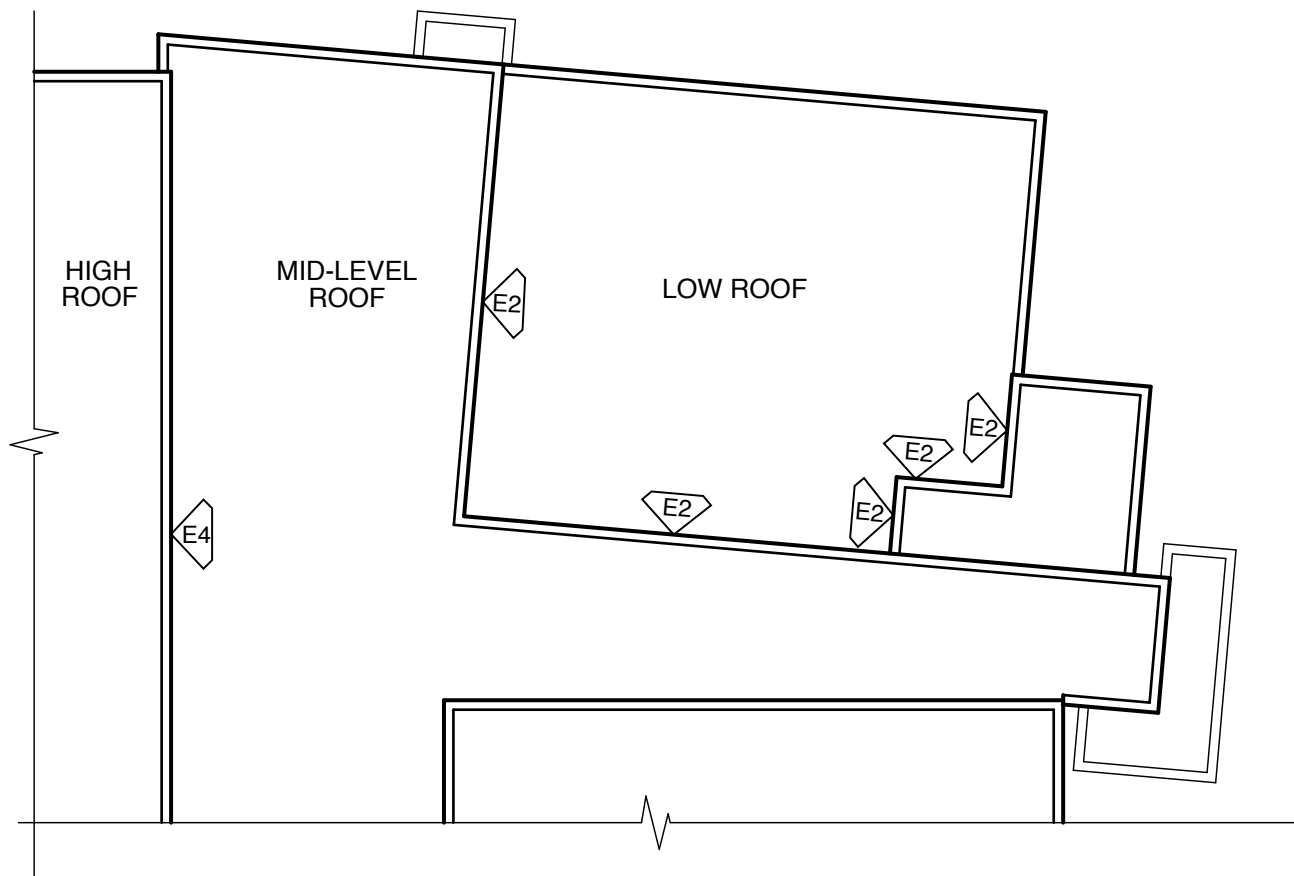

1
AD05b

WALL TYPE CLARIFICATION - ROOF

SCALE 1:200

WALL TYPE REVISION:
- CLARIFICATIONS FOR WALL TYPES
ABOVE LOWER ROOF LEVELS.

AD-05b

SINCLAIR PARK COMMUNITY CENTRE

harold funk architect inc.

NOTE: THIS DRAWING IS PROVIDED FOR CLARIFICATION AND REVISION PURPOSES AND SHALL BE READ IN CONJUNCTION WITH OTHER CONSTRUCTION DOCUMENTATION. EXTRANEOUS INFORMATION HAS BEEN REMOVED FOR CLARITY. NOTIFY THE CONTRACT ADMINISTRATOR IN THE EVENT OF QUESTIONS.

Project # 08-011
Drawn: G.S.
Reviewed: H.F.
Date: 30th March 2010

Harold Funk Architect Inc.
Architecture and Urban Design

401-55 Donald Street, Winnipeg, Manitoba R3C 1L8
T (204) 943-5087 info@funkarchitect.com
F (204) 949-9231 funkarchitect.com