


GENERAL NOTES:

1. LABEL THE AREAS EACH ZONE CONTROL IS SERVING.
2. UNLESS OTHERWISE SPECIFIED, ALL EQUIPMENT IN THE LIST IS TO BE PROVIDED BY OTHERS. THE ELECTRICAL CONTRACTOR SHALL BE RESPONSIBLE FOR ALL WIRING OF ELECTRICALLY POWERED EQUIPMENT.

REV. 1

MOTOR/EQUIPMENT SCHEDULE																	
DESCRIPTION	ITEM	EQUIPMENT LOCATIONS (REFER TO MECHANICAL DWGS FOR AREAS SERVED)	KW/HP/AMPS	VOLTS/Φ	FEED FROM	PKG UNIT	STARTER					CONTROLS				FIRE ALARM SHUT-DOWN	REMARKS
							TYPE	FUNC	PL	PB	HQA	SUPPLY BY	TYPE	SUPPLY BY	INSTALL BY		
FURNACE	F1	MECHANICAL ROOM 202	1 HP	120V/1	D15	✓						MC	MC	EC	✓		
	F2	MECHANICAL ROOM 202	1 HP	120V/1	D14	✓						MC	MC	EC	✓		
	F3	MECHANICAL ROOM 202	1 HP	120V/1	D17	✓						MC	MC	EC	✓		
	F4	MECHANICAL ROOM 202	1 HP	120V/1	D16	✓						MC	MC	EC	✓		
	F5	MECHANICAL ROOM 202	1/2 HP	120V/1	D19	✓						MC	MC	EC	✓		
	F6	MECHANICAL ROOM 202	1 HP	120V/1	D18	✓						MC	MC	EC	✓		
	F7	MECHANICAL ROOM 202	1 HP	120V/1	D21	✓						MC	MC	EC	✓		
	F8	MECHANICAL ROOM 202	1 HP	120V/1	D20	✓						MC	MC	EC	✓		
CONDENSER	C1	LOWER ROOF BESIDE NORTH GYM WALL	40A	208V/3	G1,3,5	✓								EC			
	C2	LOWER ROOF BESIDE NORTH GYM WALL	40A	208V/3	G2,4,6	✓								EC			
	C3	LOWER ROOF BESIDE NORTH GYM WALL	40A	208V/3	G7,9,11	✓								EC			
	C4	LOWER ROOF BESIDE NORTH GYM WALL	40A	208V/3	G8,10,12	✓								EC			
	C5	LOWER ROOF BESIDE NORTH GYM WALL	40A	208V/3	G13,15,17	✓								EC			
	C6	LOWER ROOF BESIDE NORTH GYM WALL	30A	208V/3	G14,16,18	✓								EC			
	C7	LOWER ROOF BESIDE NORTH GYM WALL	25A	208V/3	G19,21,23	✓								EC			
	C8	LOWER ROOF BESIDE NORTH GYM WALL	40A	208V/3	G20,22,24	✓								EC			
	C9 (FUTURE)	LOWER ROOF BESIDE NORTH GYM WALL	30A	208V/3	G25,27,29	✓								EC			
ERV	ERV1	MECHANICAL ROOM 202	5.1A	575/3	B23,25,27	✓						MC	EC				
	ERV2	MECHANICAL ROOM 202	12.3A	575/3	B24,26,28	✓						MC	EC				
BASE BOARD HEATER	BBH-1	GRAND HALL 101 AREA BY WINDOWS	1.75kW	600V/3	B8,10,12							MC	EC				
	BBH-2	GRAND HALL 101 AREA BY WINDOWS	1.75kW	600V/3	B8,10,12							MC	EC				
	BBH-3	GRAND HALL 101 AREA BY WINDOWS	2kW	600V/3	B8,10,12							MC	EC				
	BBH-4	CHANGE ROOM 105	1.5kW	600V/3	B13,15,17							MC	EC				
	BBH-5	CHANGE ROOM 106	1.5kW	600V/3	B13,15,17							MC	EC				
	BBH-6	CHANGE ROOM 107	1.5kW	600V/3	B13,15,17							MC	EC				
	BBH-7	CHANGE ROOM 108	1.5kW	600V/3	B13,15,17							MC	EC				
	BBH-8	MEETING ROOM 116	1kW	600V/3	B1,3,5							MC	EC				
	BBH-9	MEETING ROOM 116	1kW	600V/3	B1,3,5							MC	EC				
	BBH-10	STORAGE 115	750W	600V/3	B1,3,5							MC	EC				
CEILING FAN	CF-1	GYM 102	0.64A	120V/1	D13							EC	EC			SPEED CONTROL	
	CF-2	GYM 102	0.64A	120V/1	D13							EC	EC			SPEED CONTROL	
	CF-3	GYM 102	0.64A	120V/1	D13							EC	EC			SPEED CONTROL	
	CF-4	GYM 102	0.64A	120V/1	D13							EC	EC			SPEED CONTROL	
INSTANTANEOUS WATER HEATER	WH-1	Bar/storage 113	60A/2# X 2	208V/2p	A27,29,31,33												
	WH-2	MALE WC 112	60A/2#	208V/2p	A14,16												
	WH-3	FEMALE WC 117	60A/2#	208V/2p	A13,15												
	WH-4	CANTEEN 119	60A/2# X 2	208V/2p	C8,10,12,14												
	WH-5	JANITOR'S ROOM 134	60A/2# X 2	208V/2p	C19,21,23,25												
	WH-6	MEETING ROOM 116	60A/2#	208V/2p	A33,35												
	WH-7	EXISTING MECH 206	60A/2# X 2	208V/2p	A32,34,36,38												
FORCED FLOW HEATER	FFH-1	VESTIBULE 100	3kW	600V/3	B7,9,11												
	FFH-2	VESTIBULE 100	3kW	600V/3	B7,9,11												
	FFH-3	VESTIBULE 104	4kW	600V/3	B14,16,18												
	FFH-4	STAIRS ST4	2kW	600V/3	B14,16,18												
SUMP PUMP	SP-1	STORAGE 114	12A	120V/1	E13							MC	EC			HIGH LEVEL ALARM	
HAND DRYER	HD-1	FEMALE WC 117	12A	120V/1	A23												
	HD-2	FEMALE WC 117	12A	120V/1	A28												
	HD-3	MALE WC 112	12A	120V/1	A24												
	HD-4	MALE WC 112	12A	120V/1	A26												
REHEAT COIL	RH-1	CHANGE ROOM 105	1.5kW	600V/3#	B30							MC	MC	EC		AIR FLOW SWITCH CONTROL INTERLOCK	
	RH-2	CHANGE ROOM 106	1.5kW	600V/3#	B30							MC	MC	EC		AIR FLOW SWITCH CONTROL INTERLOCK	
	RH-3	CHANGE ROOM 107	1.5kW	600V/3#	B30							MC	MC	EC		AIR FLOW SWITCH CONTROL INTERLOCK	
	RH-4	CHANGE ROOM 108	1.5kW	600V/3#	B30							MC	MC	EC		AIR FLOW SWITCH CONTROL INTERLOCK	
BASKETBALL BACKSTOP WINCHES	BBW-1	GYM 102	3/4HP (20A)	120V/1#	E20								EC	EC			
	BBW-2	GYM 102	3/4HP (20A)	120V/1#	E22								EC	EC			

1 MOTOR/EQUIPMENT SCHEDULE
E-4.2 SCALE: N.T.S.

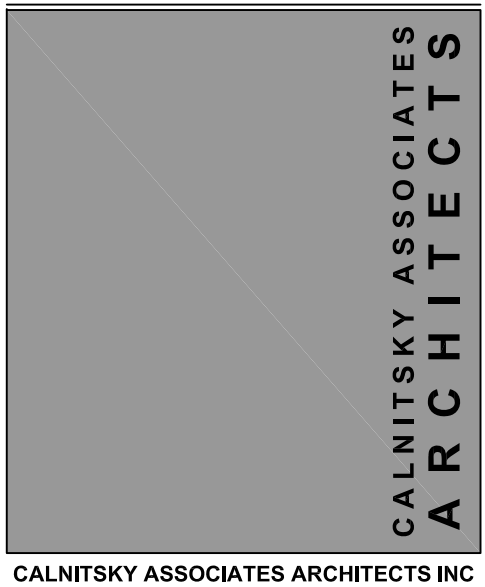


CALNITSKY ASSOCIATES ARCHITECTS INC
ARCHITECTURE | INTERIOR DESIGN
124 Nassau Street North Winnipeg, Manitoba R3L 2H1
Tel: (204) 453-6441 Fax: (204) 453-3392
E-mail: cas@escapex.ca

This drawing is not intended to be an as-built or record drawing. The contractor is responsible for verifying the accuracy of the information on-site. If there is any information that is in error, the contractor shall record the discrepancy and contact the Engineer immediately with his findings.

DATE	NO.	DESCRIPTION	DRAWN BY
2010JAN10	1	DRAWING UPDATE	BH
2010MAY13	0	ISSUE FOR TENDER	BH

REVISIONS

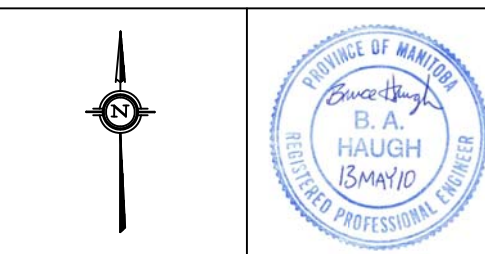

JOB TITLE:
ADDITION & RENOVATION OF WINAKWA COMMUNITY CENTRE
980 WINAKWA ROAD WINNIPEG, MB

DRAWING TITLE:
SCHEDULE

SCALE: AS SHOWN	DATE: 2010 MAY 13	DRAWING NO: E-4.2
DRAWN: B.H.	DESIGN: B.H.	CHECKED: B.H.
FILE NO: -	PROJECT NO: 339-2010	