


MUA 5-26 Controller

Bill of Materials

DID	DESCRIPTION	MANUFACTURER	PART NUMBER	QTY
SE6104	SE6104	AUTOMATED LOGIC	SE6104	22 ea
X-1	600-24VAC 100VA CONTROL TRANSFORMER	HAMMOND	EG9G	1 ea

DDC Control Panel

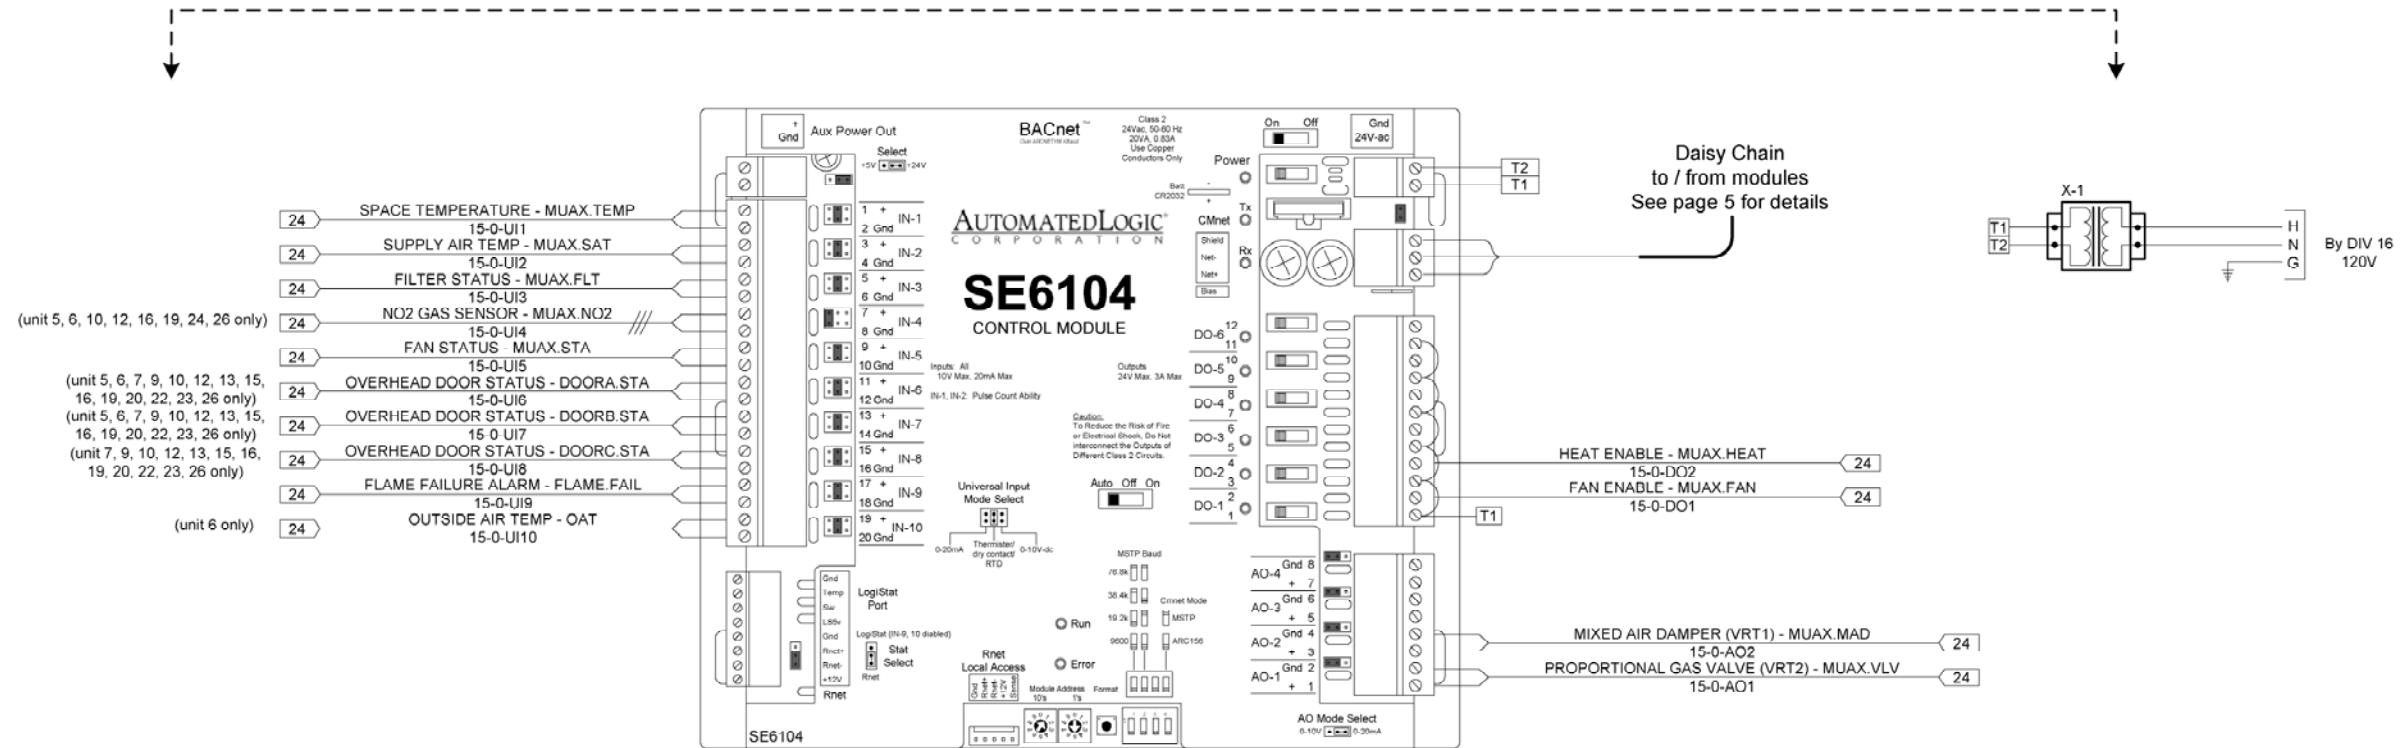

For Wiring details on MUA5 through MUA19 refer to page 24

For Wiring details on MUA20 through MUA26 refer to page 25

General Notes:

1. All wiring shall be #18-2 twisted pair unless noted otherwise.
2. Refer to ALC Technical documentation for specifications on Modules and wiring.
3. Locate control relays at starters where possible.

Winnipeg Transit Winnipeg, Manitoba			
Integrated Control Systems			
MUA 5-26 Controller			
REV: 1	As-Built	5/29/2008	JOB NO: ICS06-81
			CHECK BY: J.J.L.
			DSCODE:
			9 of 27