
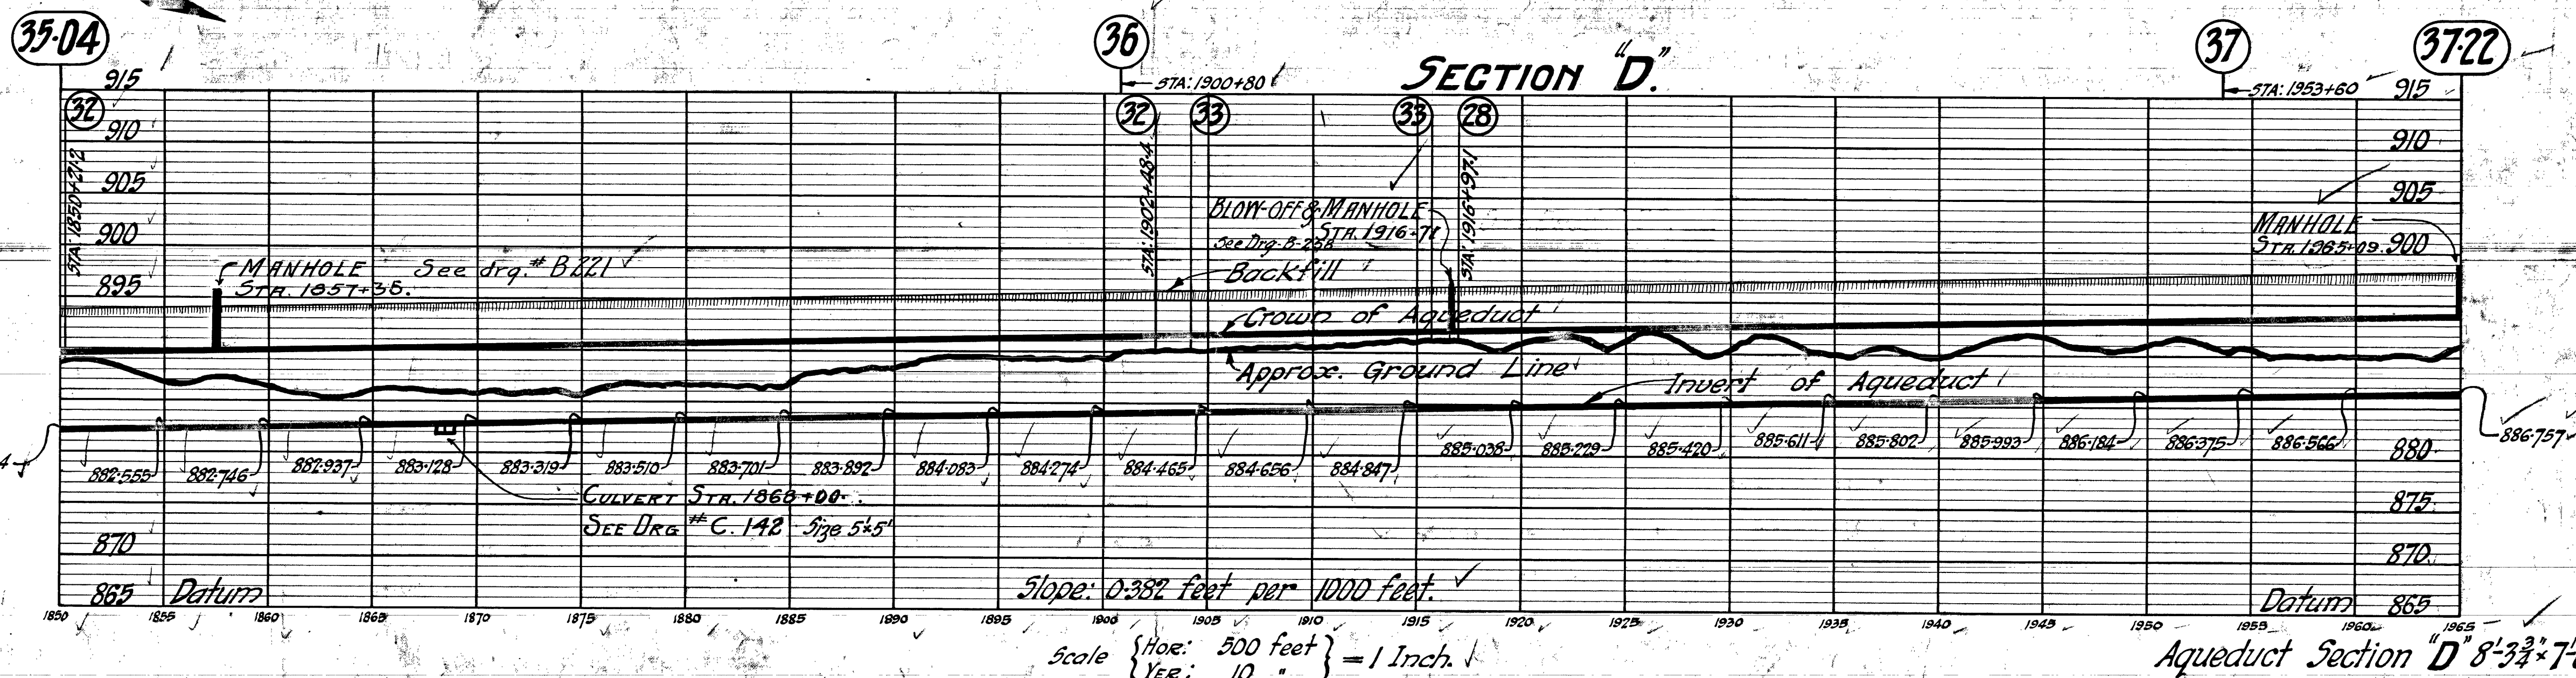


TOWNSHIP 9. RANGE 8. E.P.M.

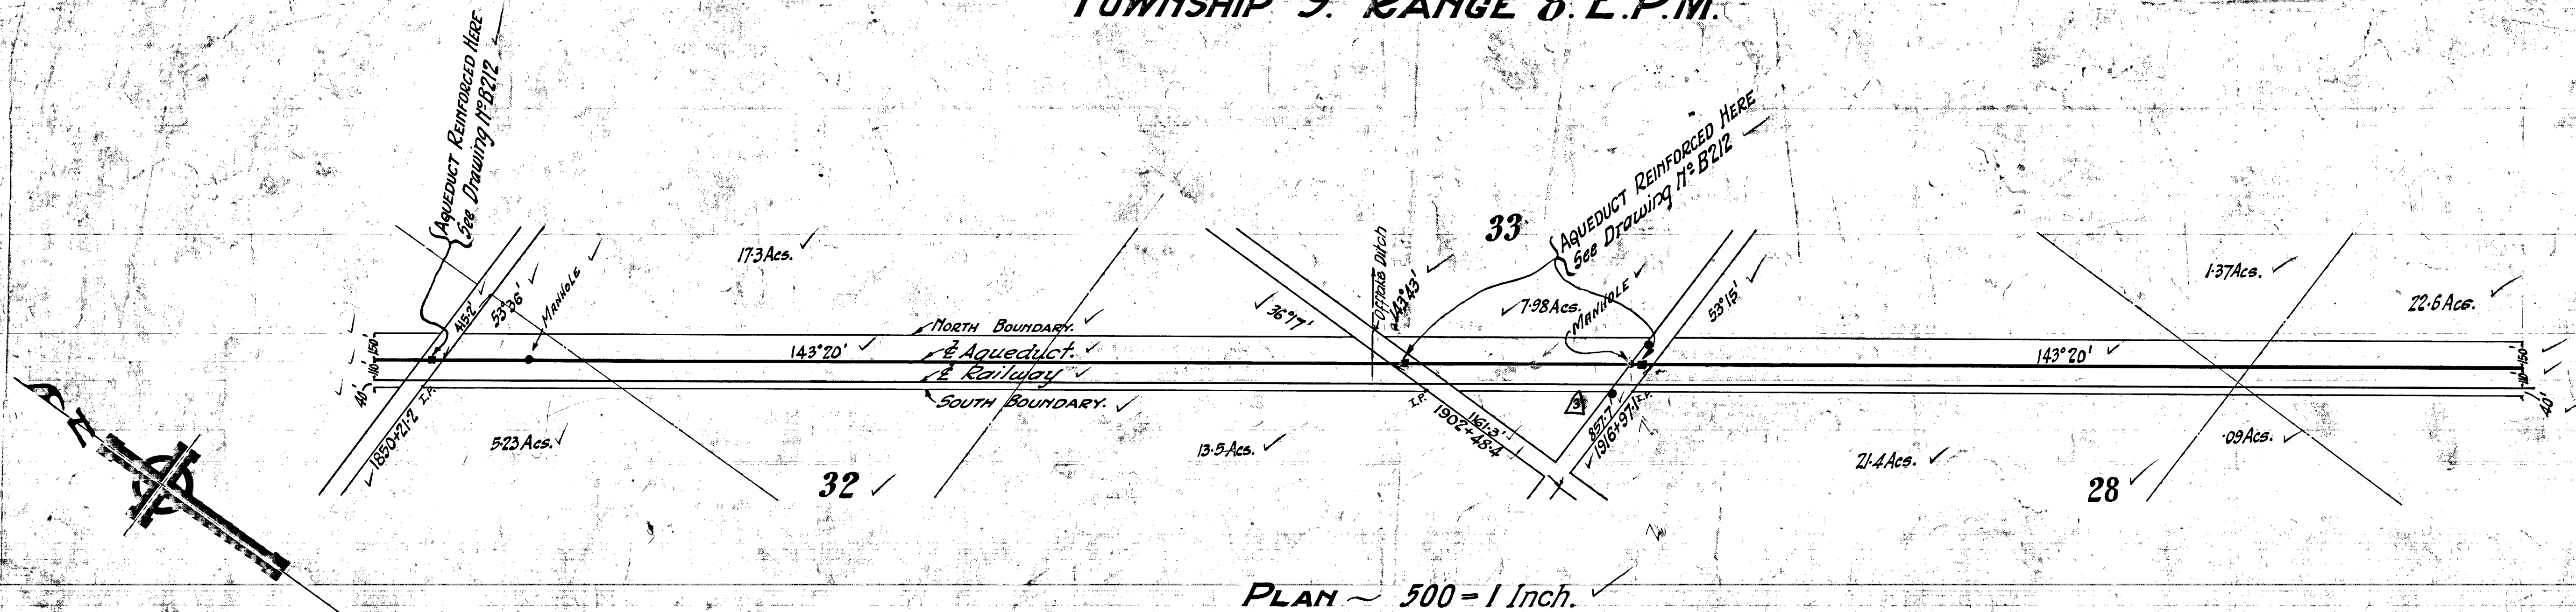

D-0291A

D-291A

DRAWN BY: *[Signature]*
 CHECKED BY: *[Signature]*
 APPROVED: *[Signature]*

Manholes & Culvert added 4th May 1917. B.S.M.K.
 ADDED HYDRO POLES May 95 M.B.D.

James H. Fuertes
 CONSULTING ENGINEER
[Signature]
 CHIEF ENGINEER

CONTRACT #31 ✓ D291
 GREATER WINNIPEG WATER DISTRICT
 Aqueduct Plan & Profile.
 MILE 35-04 to MILE 37-22.
 Date: _____ Scale as shown.

Micro-Film 1 1965