

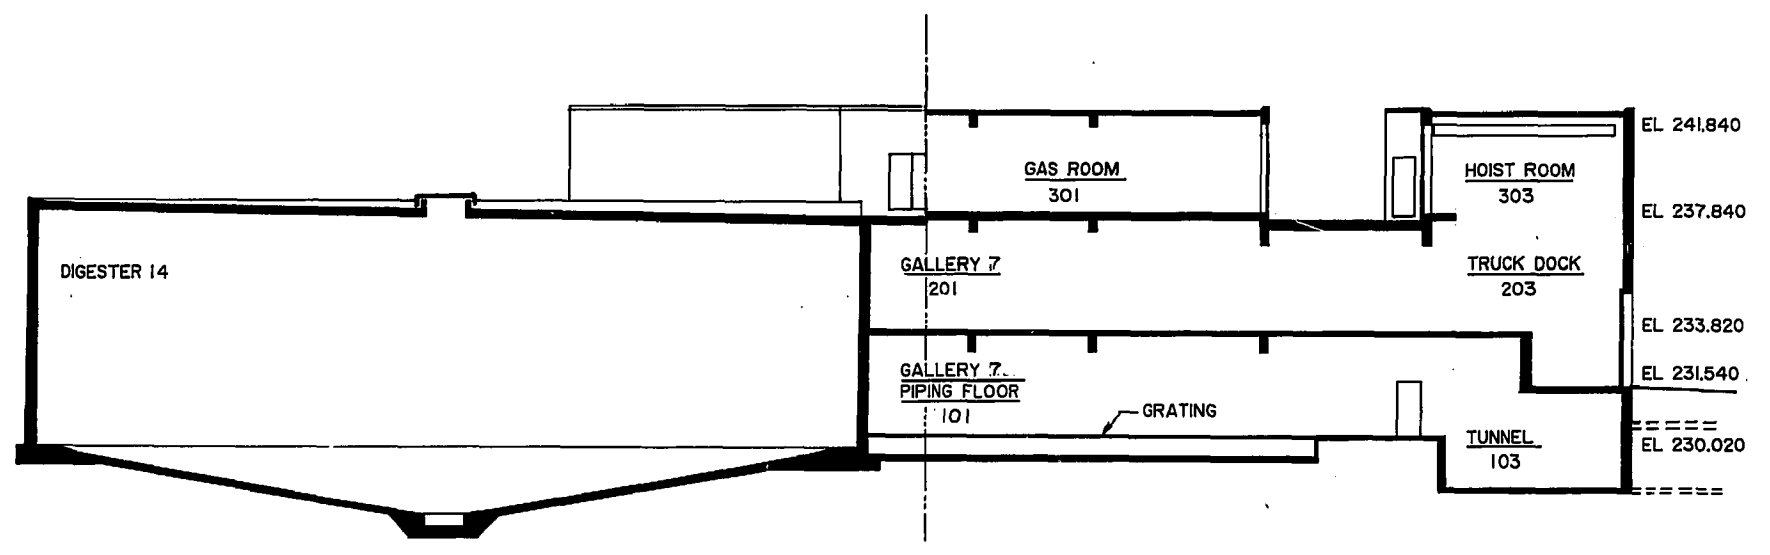
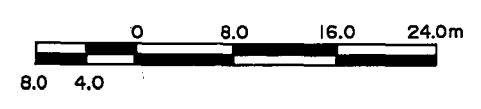


PLAN AT EL 237.840

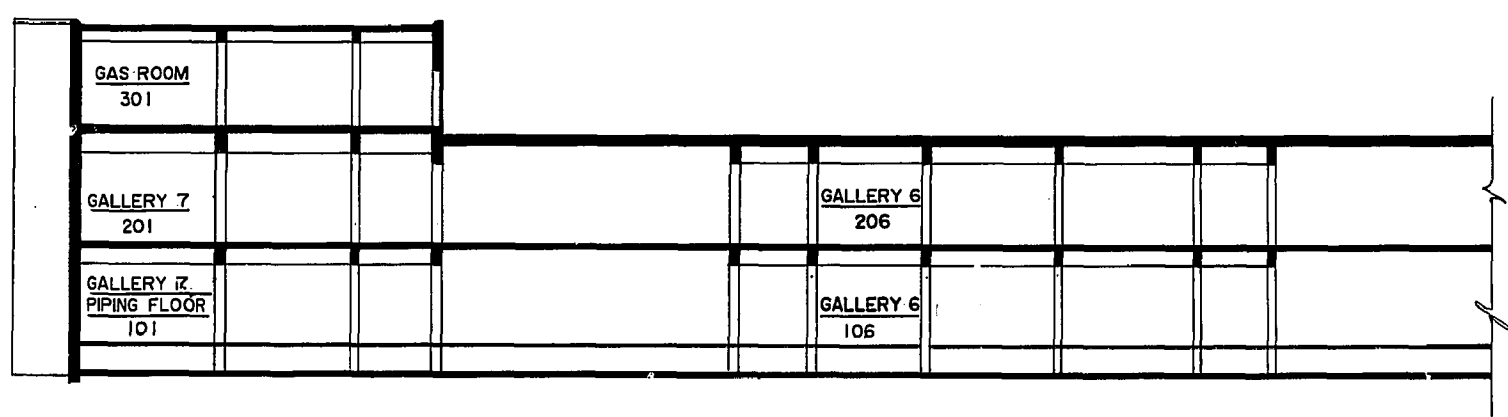

SECTION 1

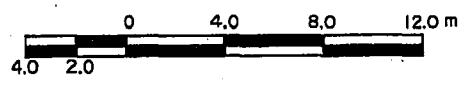


SECTION 2

FOR SHOP DRAWING INFORMATION REFER TO THE SHOP DRAWING CROSS REFERENCE INDEX

A	DESIGNATION
B	ITEM ORIGIN
C	ITEM LOCATION

NO.	REVISIONS	DATE	XPP.
A	REVISED TO AS CONSTRUCTED	2/10/85	[Signature]

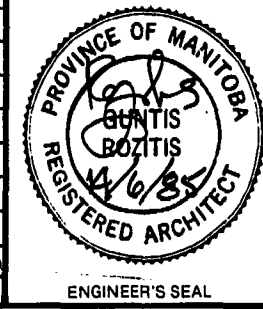

Underwood McLellan Ltd.
Consulting Engineers and Planners
GORE & STORRIE LIMITED
CONSULTING ENGINEERS

DESIGNED BY: G. ROZITIS
DRAWN BY: J.R.C.
CHECKED BY: G. ROZITIS
DATE: FEB./85
APPROVED BY: [Signature]
DATE: JUNE/85

THE CITY OF WINNIPEG
WORKS & OPERATIONS DIVISION
WATERWORKS, WASTE & DISPOSAL DEPARTMENT

NORTH END WATER POLLUTION CONTROL CENTRE
SLUDGE DIGESTION EXPANSION

GENERAL ARRANGEMENT
EL 237.840
PLAN AND SECTIONS

RELEASED FOR CONSTRUCTION: [Signature]
DATE: 17/6/85

SCALE: AS SHOWN
DRAWING NO.: NEP-1189

AS CONSTRUCTED
APPROVED BY: [Signature]
DATE: 28-03-85

"TO OBTAIN PLANT DATUM SUBTRACT 221.764 METRES"