


NORTH ENTRY PLAN GALLERY 5
(T.O. SLAB EL. 233.820)

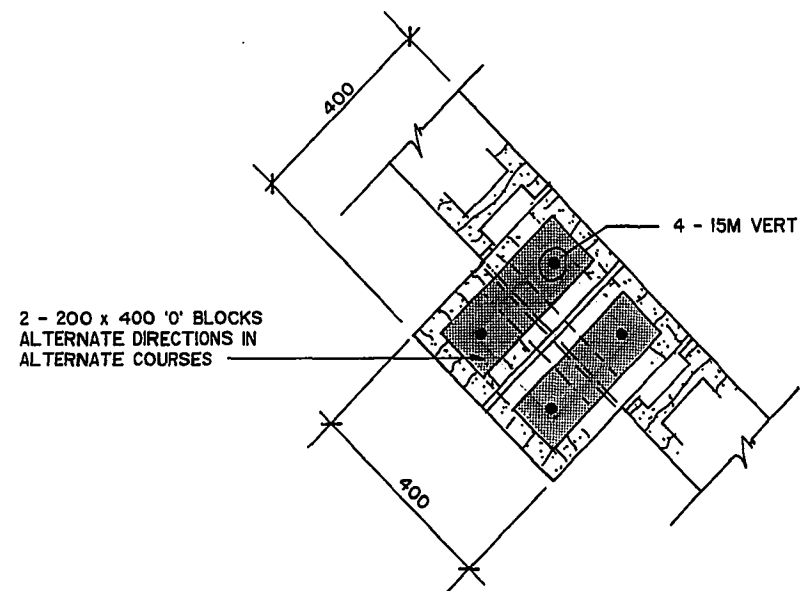

DETAIL A

CORBEL REPAIRS
REPAIR LOCATIONS SHOWN AS TYPE 'A,B,C & D' FOR CORBEL REPAIR SCHEDULE & REPAIR DETAILS SEE DWG NFP-1219

NOTE No. 1
OPENINGS FILLED WITH CONCRETE
10M @ 275 EW BOT (MIN 3 EW)
10M x 400 THREADED DWLS @ 550 O/C
IN CENTRE OF SLAB C/W SLEEVE INSERT
MIN 100 INTO EXISTING CONCRETE (MIN 2 PER SIDE)
TYPICAL 4 THUS

BEAM REINFORCING
B201 - 250 x 400 (3 THUS)
2 - 25M TOP & BOT
10M STIRRUPS @ 150
B202 - 250 x 400 (1 THUS)
2 - 20M TOP & BOT
10M STIRRUPS @ 150


GENERAL NOTES:
1. OPENINGS THROUGH EXISTING WALLS & FLOORS FOR PIPES
- SEE PROCESS & MECHANICAL DRAWINGS FOR LOCATION AND SIZE

AS CONSTRUCTED
APPROVED BY: [Signature]
DATE: 1/88-03-28

FOR SHOP DRAWING INFORMATION REFER TO THE SHOP DRAWING CROSS REFERENCE INDEX

A DESIGNATION
B ITEM ORIGIN
C ITEM LOCATION

"TO OBTAIN PLANT DATUM SUBTRACT 221.764 METRES"

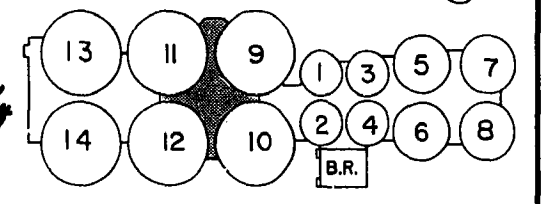

KEY PLAN

FLOOR FRAMING PLAN - GALLERY 5 SOUTH STAIR
(T.O. SLAB EL. 233.820)

NO.	REVISIONS	DATE	APP.
1	REVISED TO AS CONSTRUCTED	1/1/88	[Signature]



Underwood McLellan Ltd.
Consulting Engineers and Planners
GORE & STORRIE LIMITED
CONSULTING ENGINEERS
DESIGNED BY: B. BISWANGER
DRAWN BY: L.M.G.
CHECKED BY: D. ROGOWSKY
DATE: FEB/85
APPROVED BY: [Signature]
DATE: JUNE/85

THE CITY OF WINNIPEG
WORKS & OPERATIONS DIVISION
WATERWORKS, WASTE & DISPOSAL DEPARTMENT

DIGESTION GALLERY No. 5
STRUCTURAL (EL. 233.820)
EXIT FLOOR PLANS
RELEASED FOR CONSTRUCTION: [Signature]
DATE: 17/6/85
SCALE: AS SHOWN
DRAWING NO: **NEP-1212**