



"TO OBTAIN PLANT DATUM SUBTRACT 221.764 METRES"

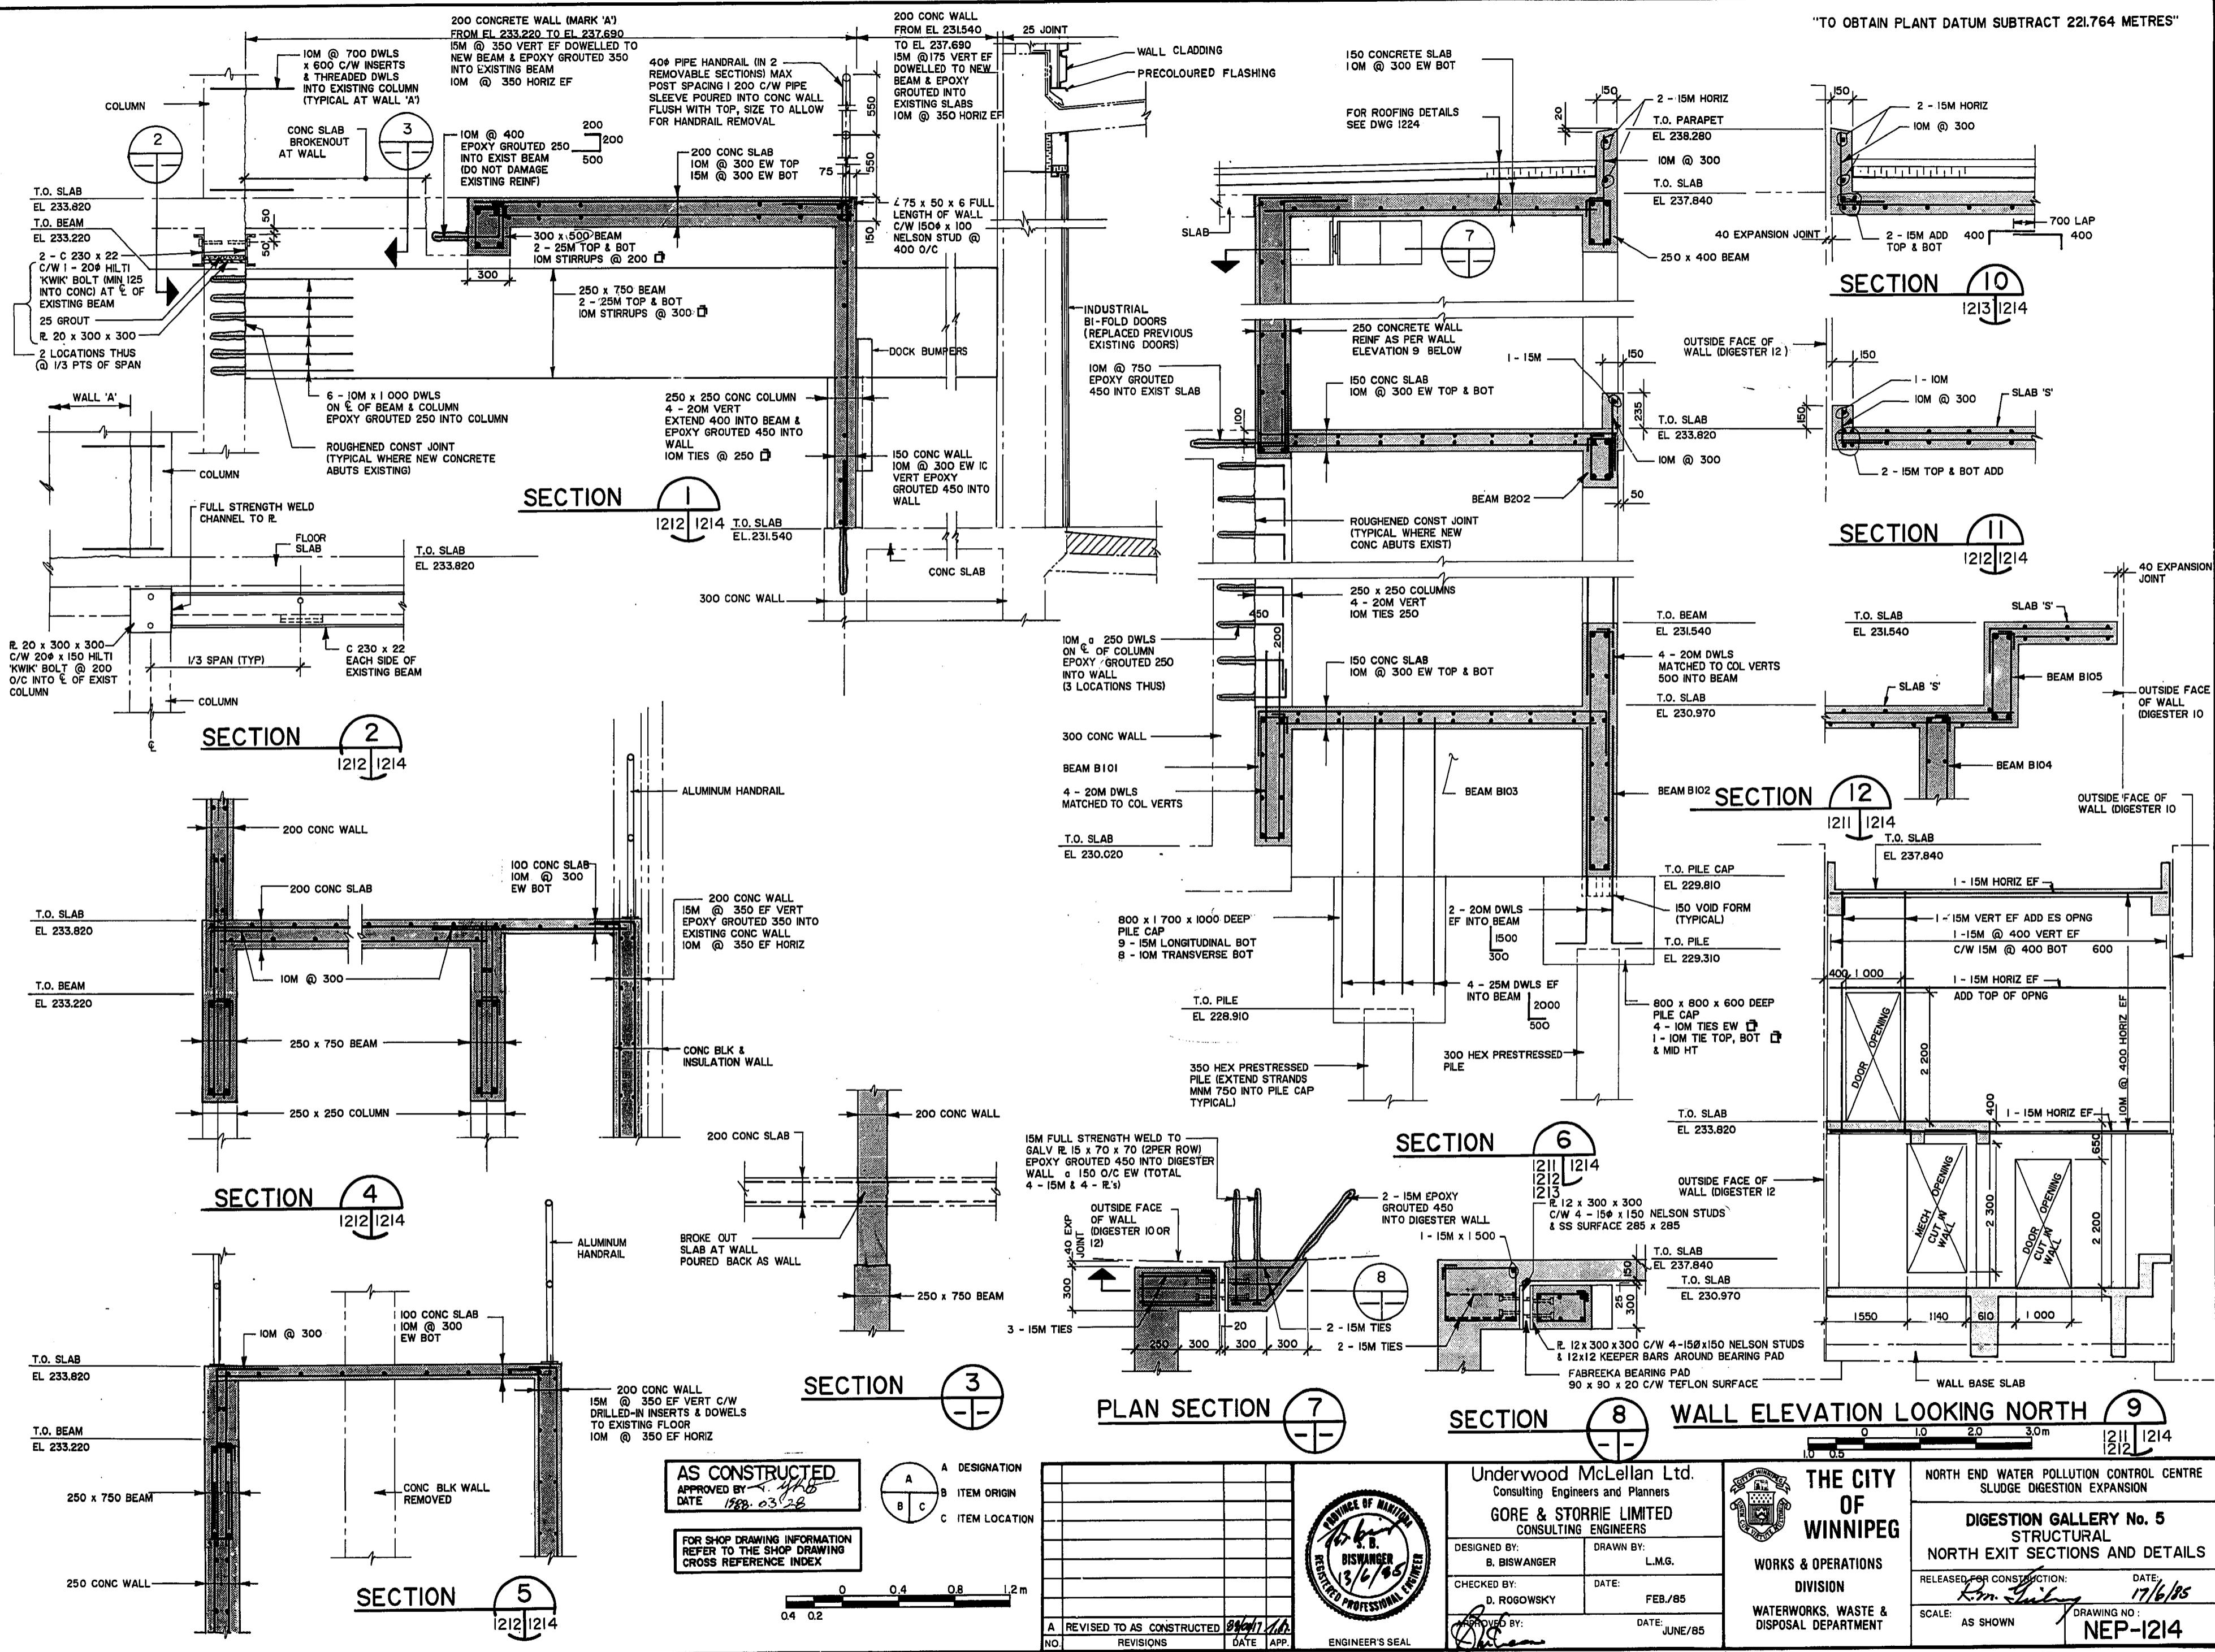


AS CONSTRUCTED
 APPROVED BY: *[Signature]*
 DATE: 1988-03-28

FOR SHOP DRAWING INFORMATION REFER TO THE SHOP DRAWING CROSS REFERENCE INDEX

A	DESIGNATION
B	ITEM ORIGIN
C	ITEM LOCATION

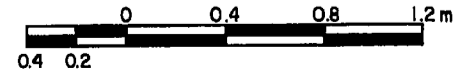

NO.	REVISIONS	DATE	APP.
A	REVISED TO AS CONSTRUCTED	08/07/88	[Signature]

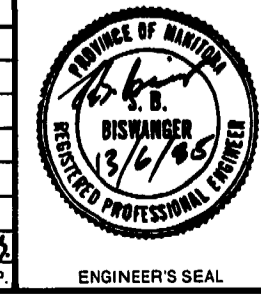

Underwood McLellan Ltd.
 Consulting Engineers and Planners
GORE & STORRIE LIMITED
 CONSULTING ENGINEERS

DESIGNED BY: B. BISWANGER
 DRAWN BY: L.M.G.
 CHECKED BY: D. ROGOWSKY
 DATE: FEB/85
 APPROVED BY: [Signature]
 DATE: JUNE/85



NORTH END WATER POLLUTION CONTROL CENTRE
 SLUDGE DIGESTION EXPANSION

DIGESTION GALLERY No. 5
 STRUCTURAL
 NORTH EXIT SECTIONS AND DETAILS

RELEASED FOR CONSTRUCTION: *[Signature]* DATE: 17/6/85
 SCALE: AS SHOWN DRAWING NO: NEP-1214