


**LEGEND**  
 EXISTING PIPING, VALVES, EQUIPMENT & STRUCTURE  
 NEW PIPING & EQUIPMENT

A DESIGNATION  
 B ITEM ORIGIN  
 C ITEM LOCATION

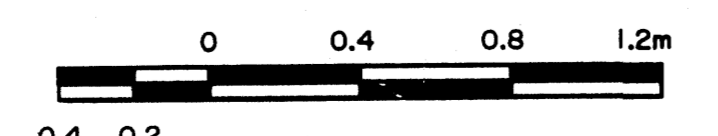

FOR SHOP DRAWING INFORMATION REFER TO THE SHOP DRAWING CROSS REFERENCE INDEX

NO.	REVISIONS	DATE	APP.
A	REVISED TO AS CONSTRUCTED	10/16/85	MA

**ENGINEER'S SEAL**  
 A.P.E.M. - 112-84(R)  
 EXP. DATE: 85-10-15  
 G. G. POWELL  
 PROVINCE OF ONTARIO

**Underwood McLellan Ltd.**  
 Consulting Engineers and Planners  
**GORE & STORRIE LIMITED**  
 CONSULTING ENGINEERS  
 DESIGNED BY: J. CHENG  
 CHECKED BY: J. CHENG  
 DRAWN BY: C.L. S.C.  
 DATE: JUNE / 85  
 APPROVED BY: [Signature]  
 DATE: JUNE / 85

**THE CITY OF WINNIPEG**  
 WORKS & OPERATIONS DIVISION  
 WATERWORKS, WASTE & DISPOSAL DEPARTMENT

NORTH END WATER POLLUTION CONTROL CENTRE  
 SLUDGE DIGESTION EXPANSION  
**DIGESTION GALLERY No. 5 PROCESS**  
 PERSPECTIVE VIEWS & SECTIONS  
 RELEASED FOR CONSTRUCTION: [Signature] DATE: 17/6/85  
 SCALE: AS NOTED  
 DRAWING NO: **NEP - 1258**

AS CONSTRUCTED  
 APPROVED BY: [Signature]  
 DATE: 1988-03-24

"TO OBTAIN PLANT DATUM SUBTRACT 221.764 METRES"