

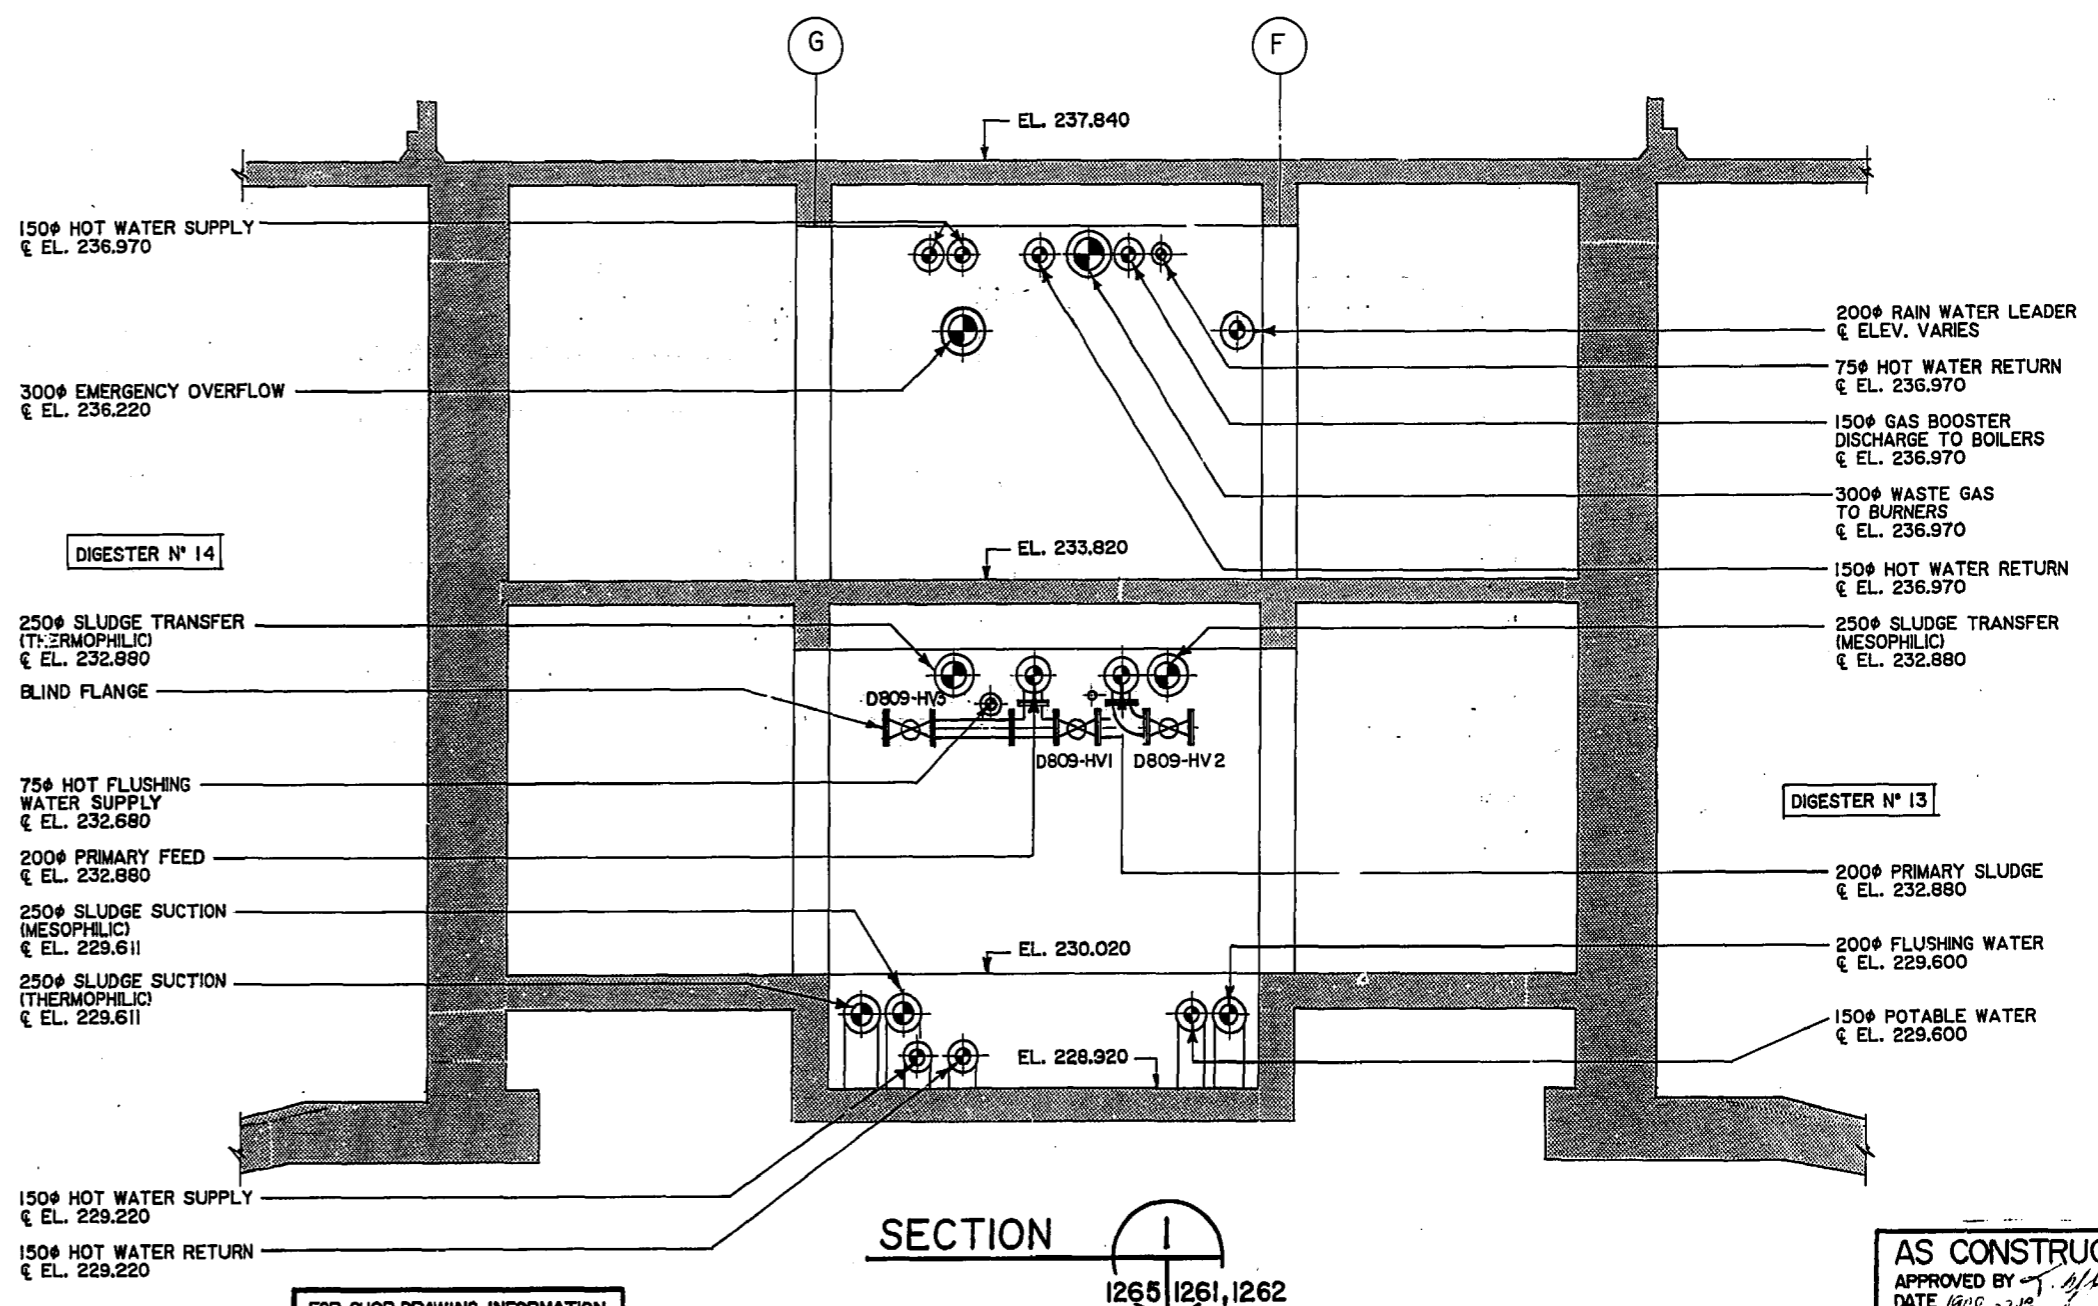
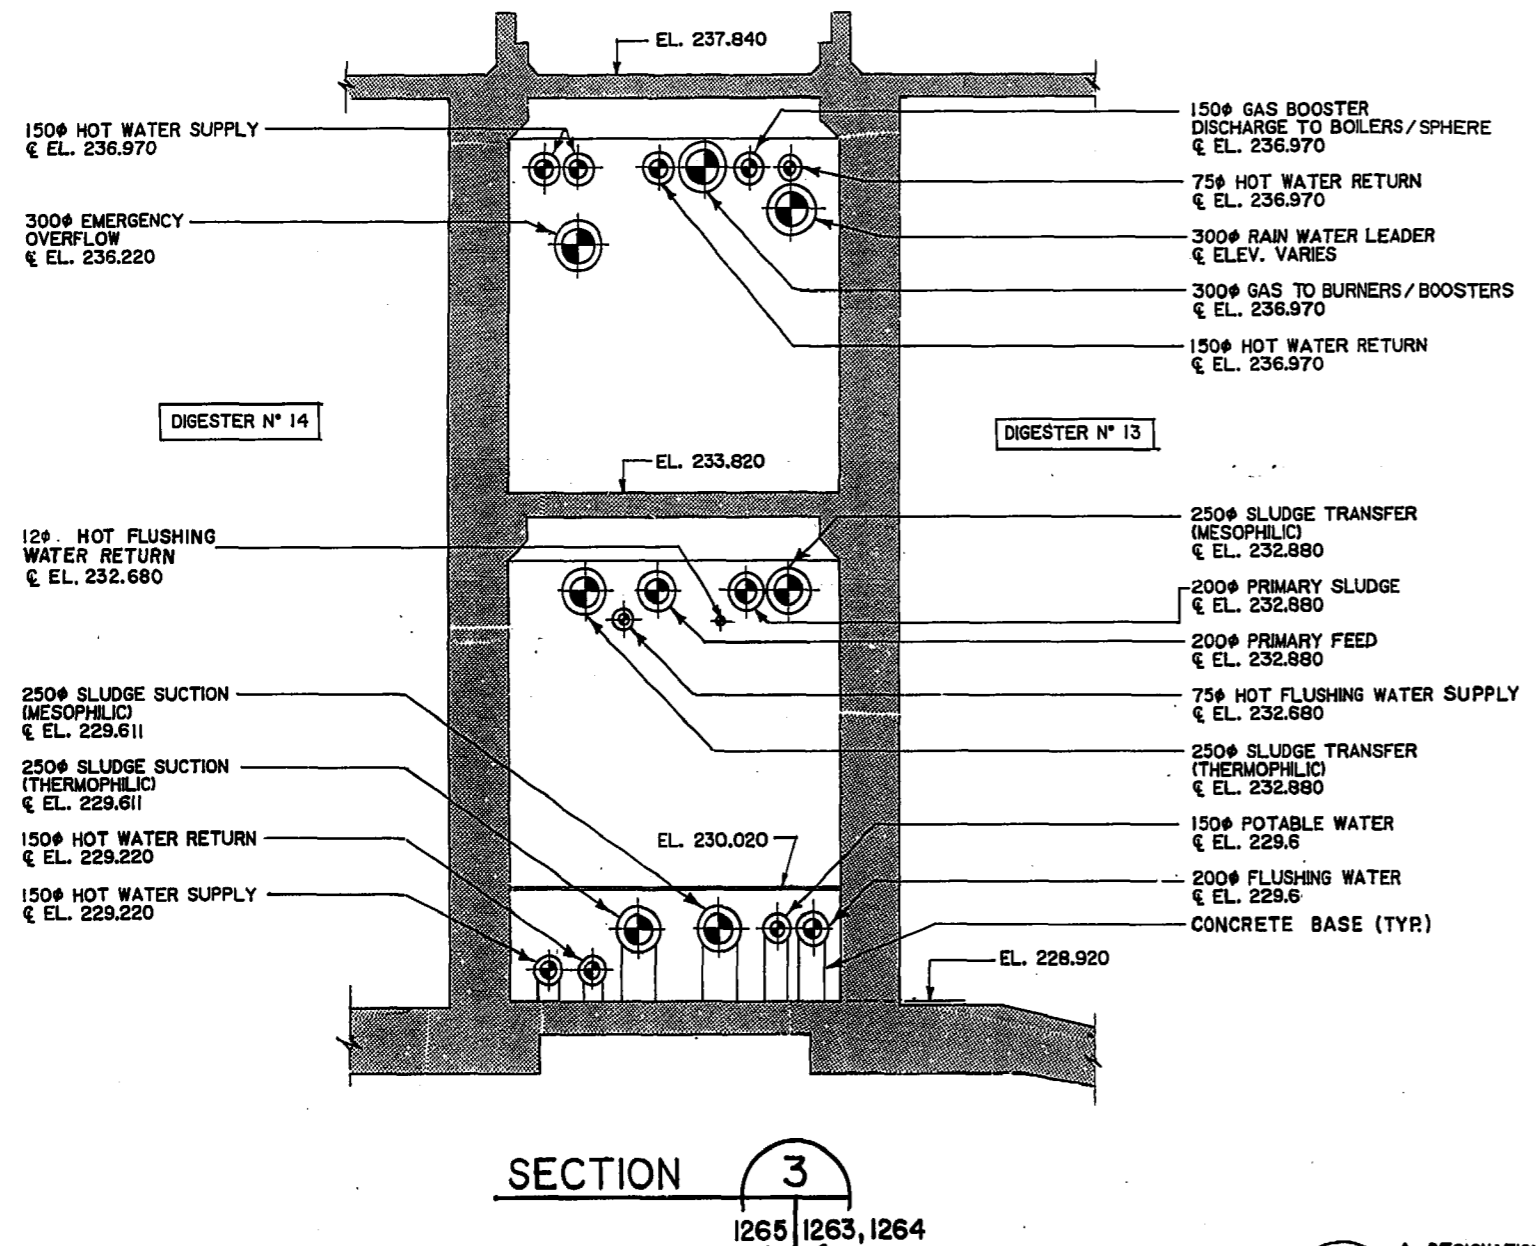
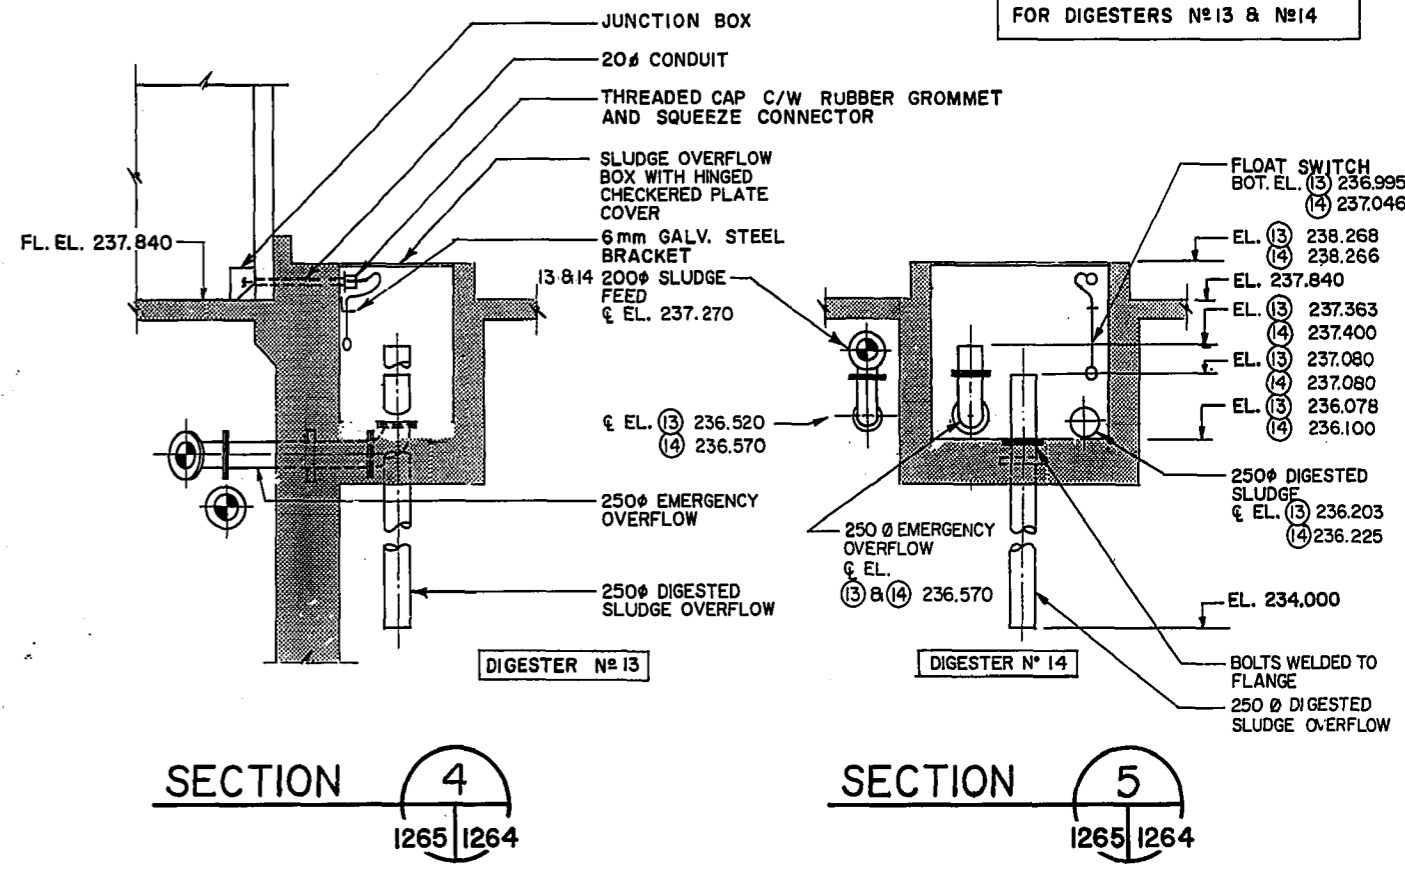


NOTE: ALL ELEVATIONS ARE TYPICAL FOR DIGESTERS N°13 & N°14

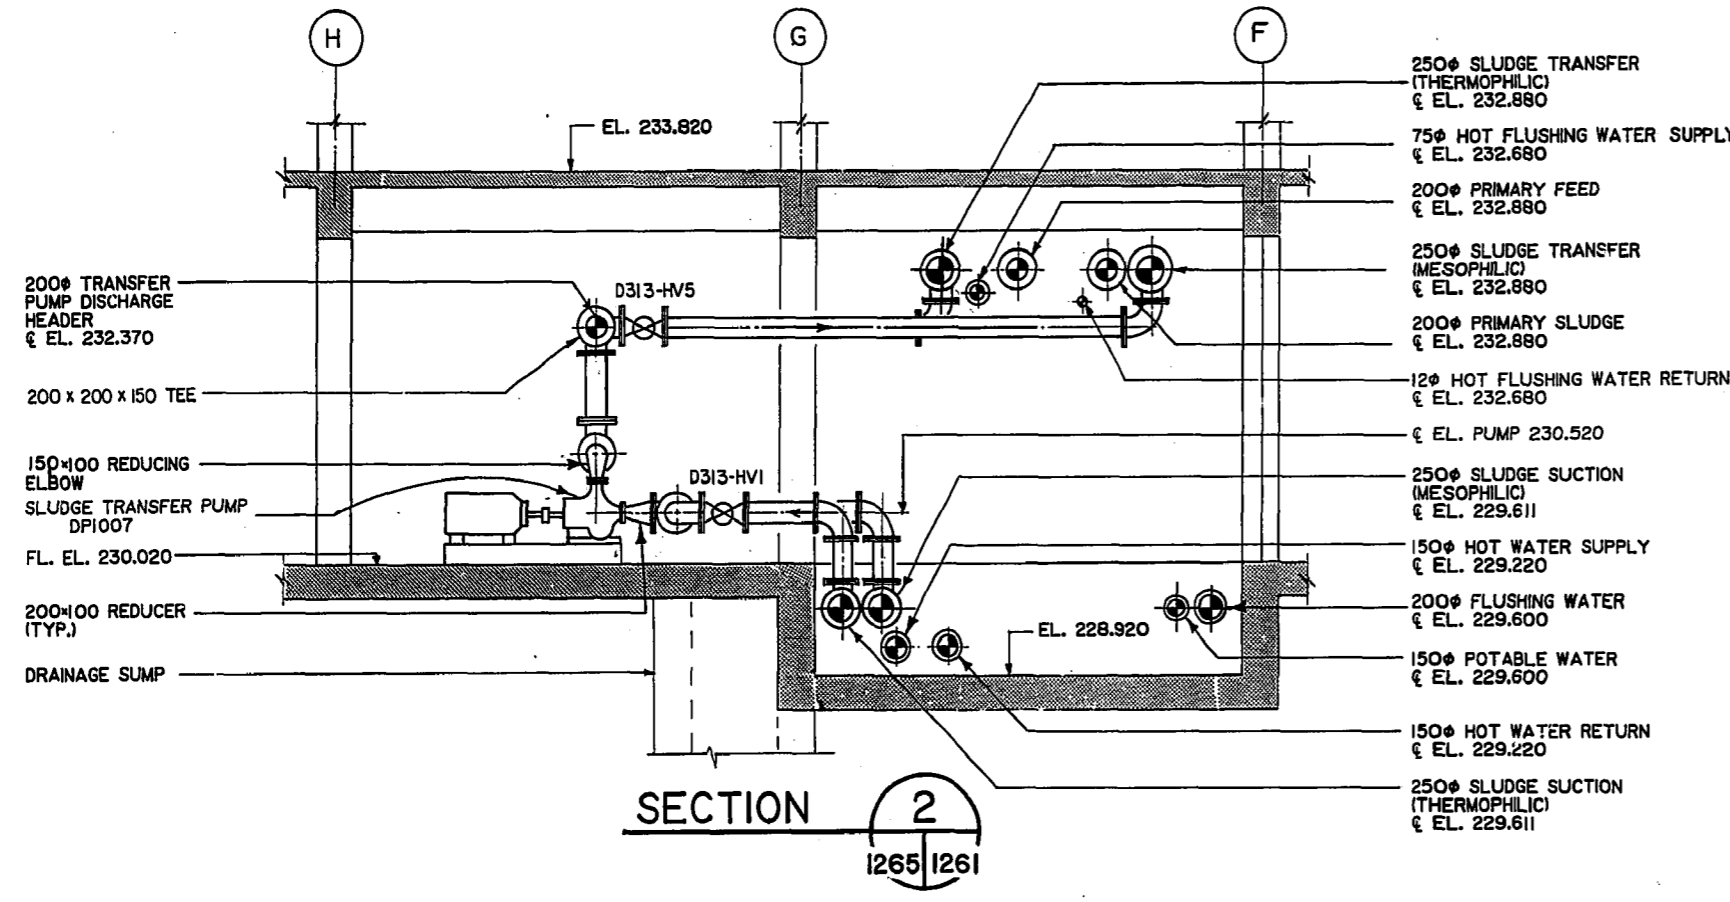


A DESIGNATION
 B ITEM ORIGIN
 C ITEM LOCATION

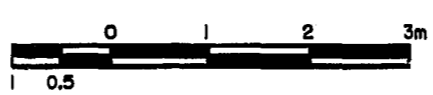

FOR SHOP DRAWING INFORMATION REFER TO THE SHOP DRAWING CROSS REFERENCE INDEX


NO.	REVISIONS	DATE	APP.
A	REVISED TO AS CONSTRUCTED	17/6/85	[Signature]

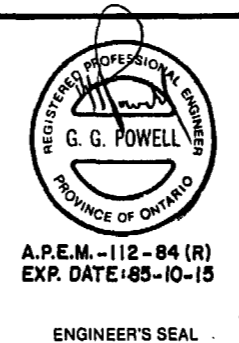

Underwood McLellan Ltd.
 Consulting Engineers and Planners
GORE & STORRIE LIMITED
 CONSULTING ENGINEERS

DESIGNED BY: J. CHENG
 CHECKED BY: J. CHENG
 APPROVED BY: [Signature]

DRAWN BY: C.L. S.N.
 DATE: JUNE / 85
 DATE: JUNE / 85

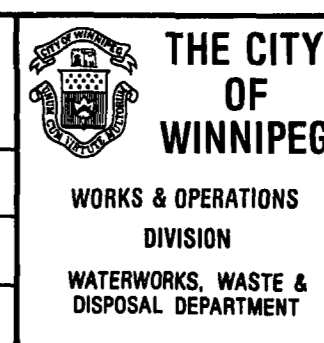

"TO OBTAIN PLANT DATUM SUBTRACT 221.764 METRES"

NORTH END WATER POLLUTION CONTROL CENTRE
 SLUDGE DIGESTION EXPANSION

DIGESTION GALLERIES No. 6 & 7
 PROCESS SECTIONS

RELEASED FOR CONSTRUCTION: [Signature] DATE: 17/6/85
 SCALE: AS NOTED DRAWING NO: NEP-1265