



PLAN AT ELEV. 237.000

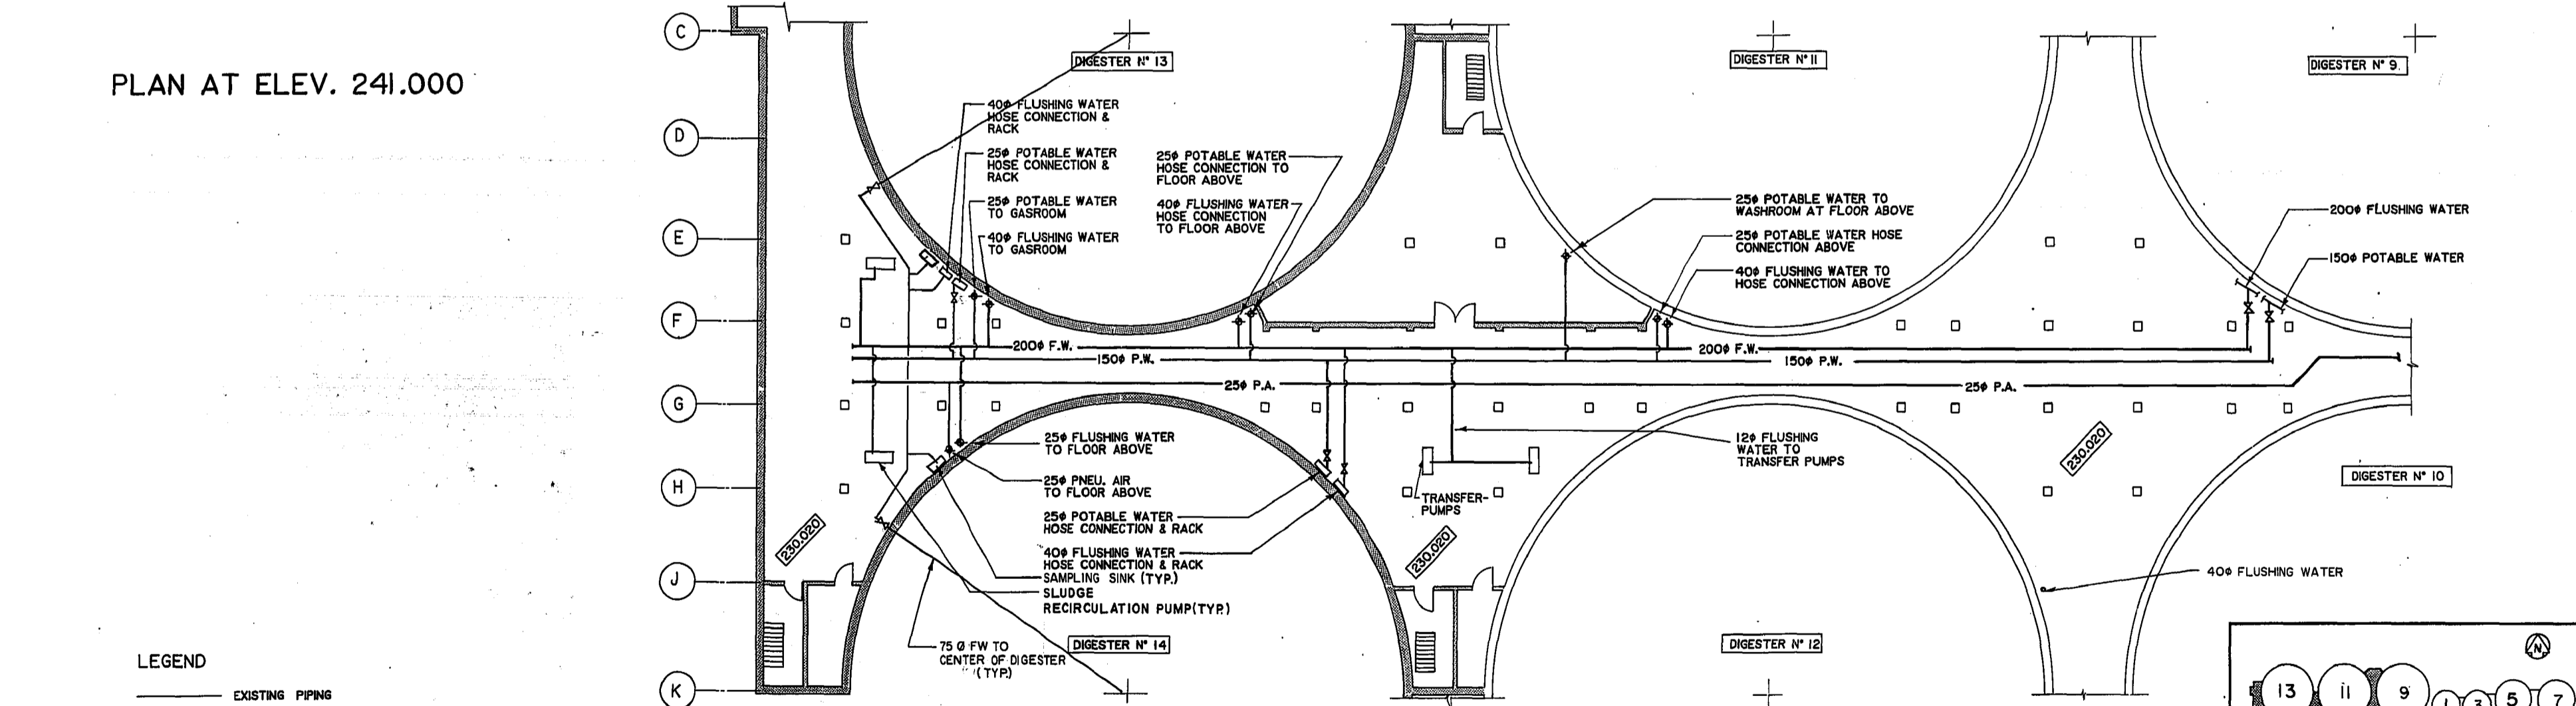

PLAN AT ELEV. 241.000


PLAN AT ELEV. 233.000

- LEGEND**
- EXISTING PIPING
 - NEW PIPING
 - EXISTING STRUCTURE
 - NEW STRUCTURE
 - P.A. PNEUMATIC AIR
 - P.W. POTABLE WATER
 - F.W. FLUSHING WATER

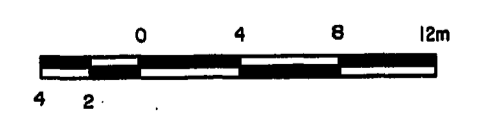

FOR SHOP DRAWING INFORMATION
REFER TO THE SHOP DRAWING
CROSS REFERENCE INDEX

AS CONSTRUCTED
APPROVED BY: *[Signature]*
DATE: 1988.03.26

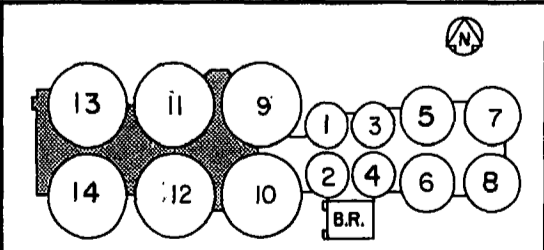

KEY PLAN

<p>Underwood McLellan Ltd. Consulting Engineers and Planners</p> <p>GORE & STORRIE LIMITED CONSULTING ENGINEERS</p>		<p>THE CITY OF WINNIPEG</p> <p>WORKS & OPERATIONS DIVISION</p> <p>WATERWORKS, WASTE & DISPOSAL DEPARTMENT</p>	<p>NORTH END WATER POLLUTION CONTROL CENTRE SLUDGE DIGESTION EXPANSION</p>	
<p>DESIGNED BY: J. CHENG</p> <p>CHECKED BY: J. CHENG</p>	<p>DRAWN BY: S.C. S.N.</p> <p>DATE: JUNE / 85</p>		<p>DIGESTION GALLERIES No. 5 - 7 PROCESS SERVICE PIPING</p>	
<p>APPROVED BY: <i>[Signature]</i> DATE: JUNE / 85</p>		<p>RELEASED FOR CONSTRUCTION: DATE:</p>		
<p>NO. REVISIONS DATE APP.</p>		<p>SCALE: AS NOTED</p>		
<p>ENGINEER'S SEAL</p>		<p>DRAWING NO: NEP-1280</p>		